


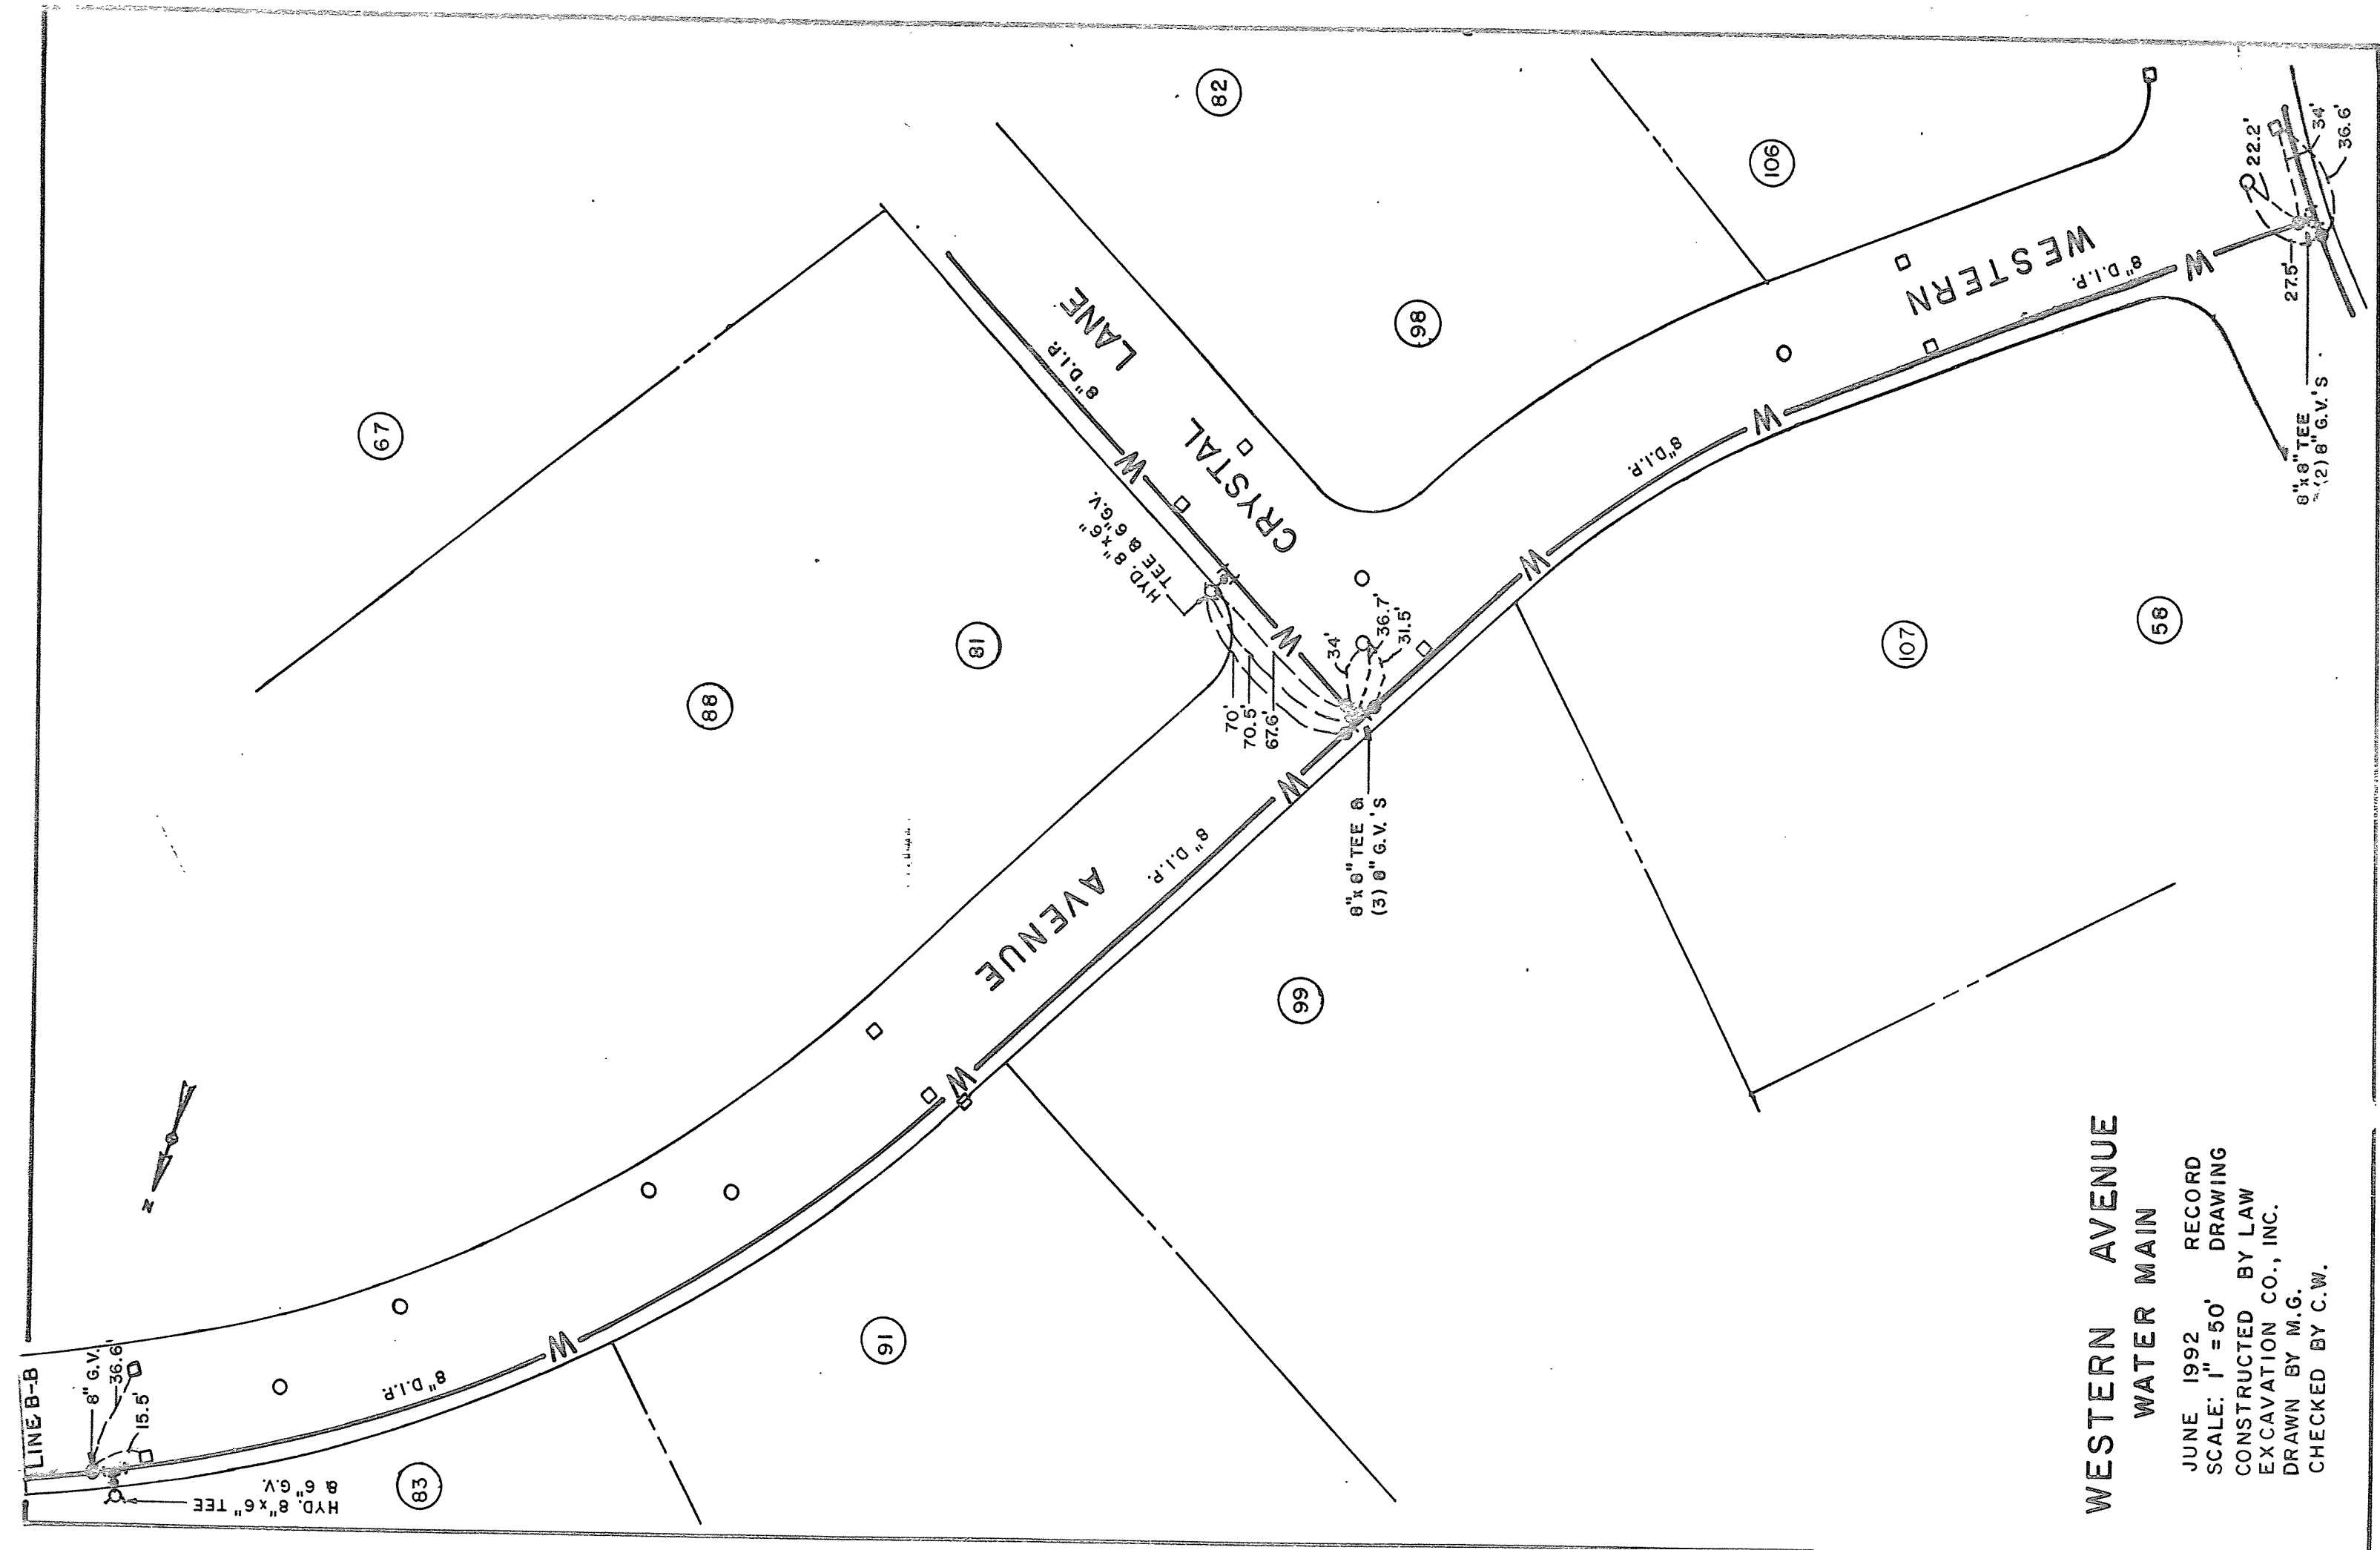

WESTERN AVENUE
WATER MAIN

JUNE 1992 RECORD
SCALE: 1" = 50' DRAWING
CONSTRUCTED BY LAW
EXCAVATION CO., INC.
DRAWN BY M.G.
CHECKED BY C.W.