


WHITE OAK ROAD
WATER DISTRICT NO. 1

TOWN OF BETHLEHEM

Record of Installations
Scale 1"=100' June 1974
J. Kenneth Fraser and Associates, P.C.
Consulting Engineers -- Rensselaer, N.Y.

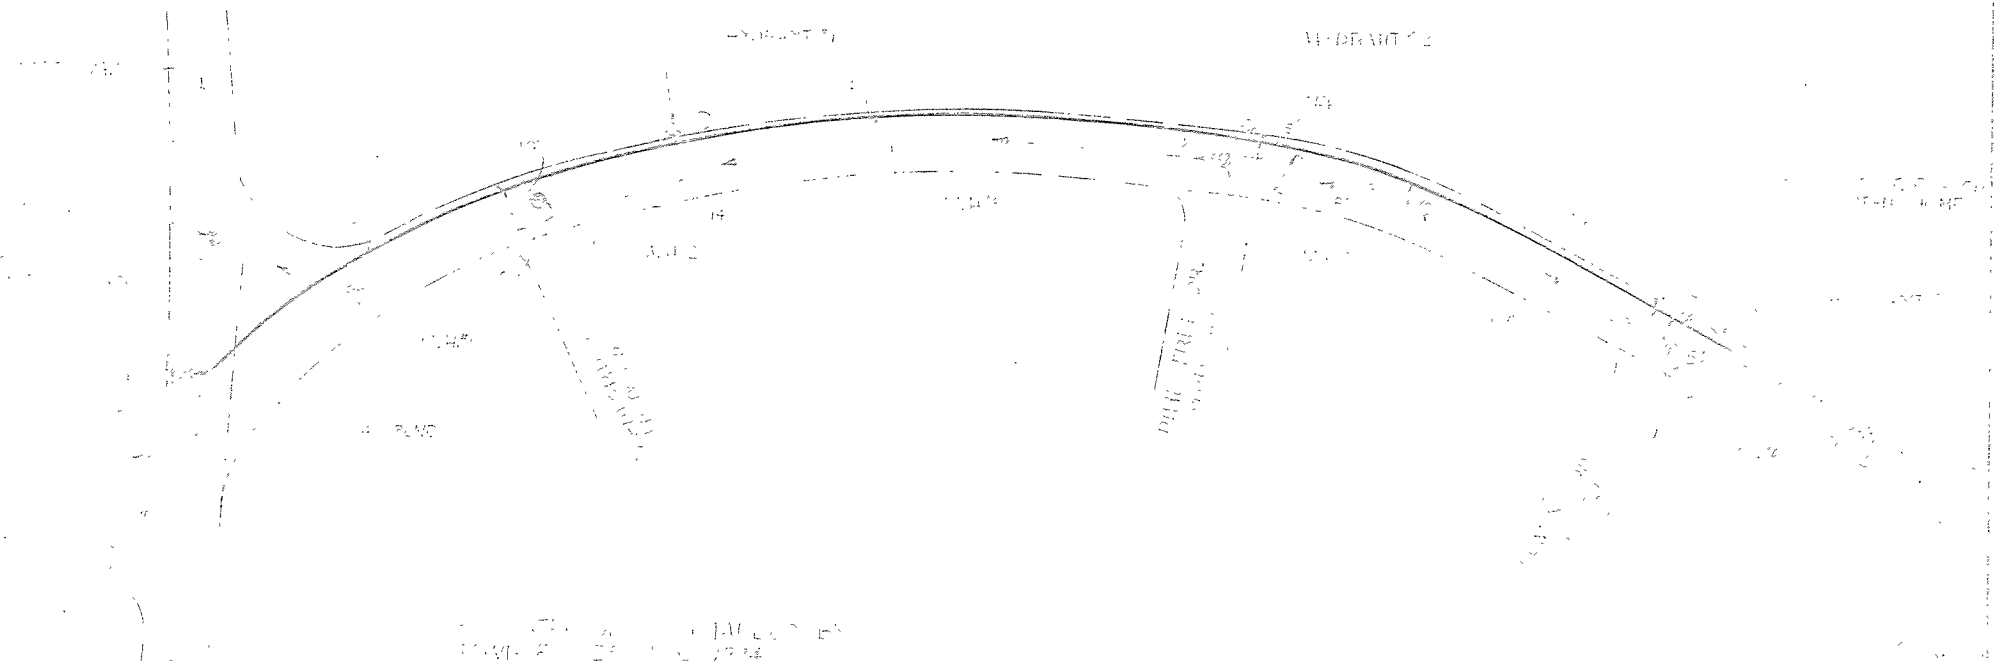

LEGEND

- | | |
|---------|------------|
| — | WATER MAIN |
| - - - | SEWER MAIN |
| - . - . | RAILROAD |
| × | TRAIL |
| ○ | MANHOLE |
| + | VALVE |
| □ | HYDRANT |