
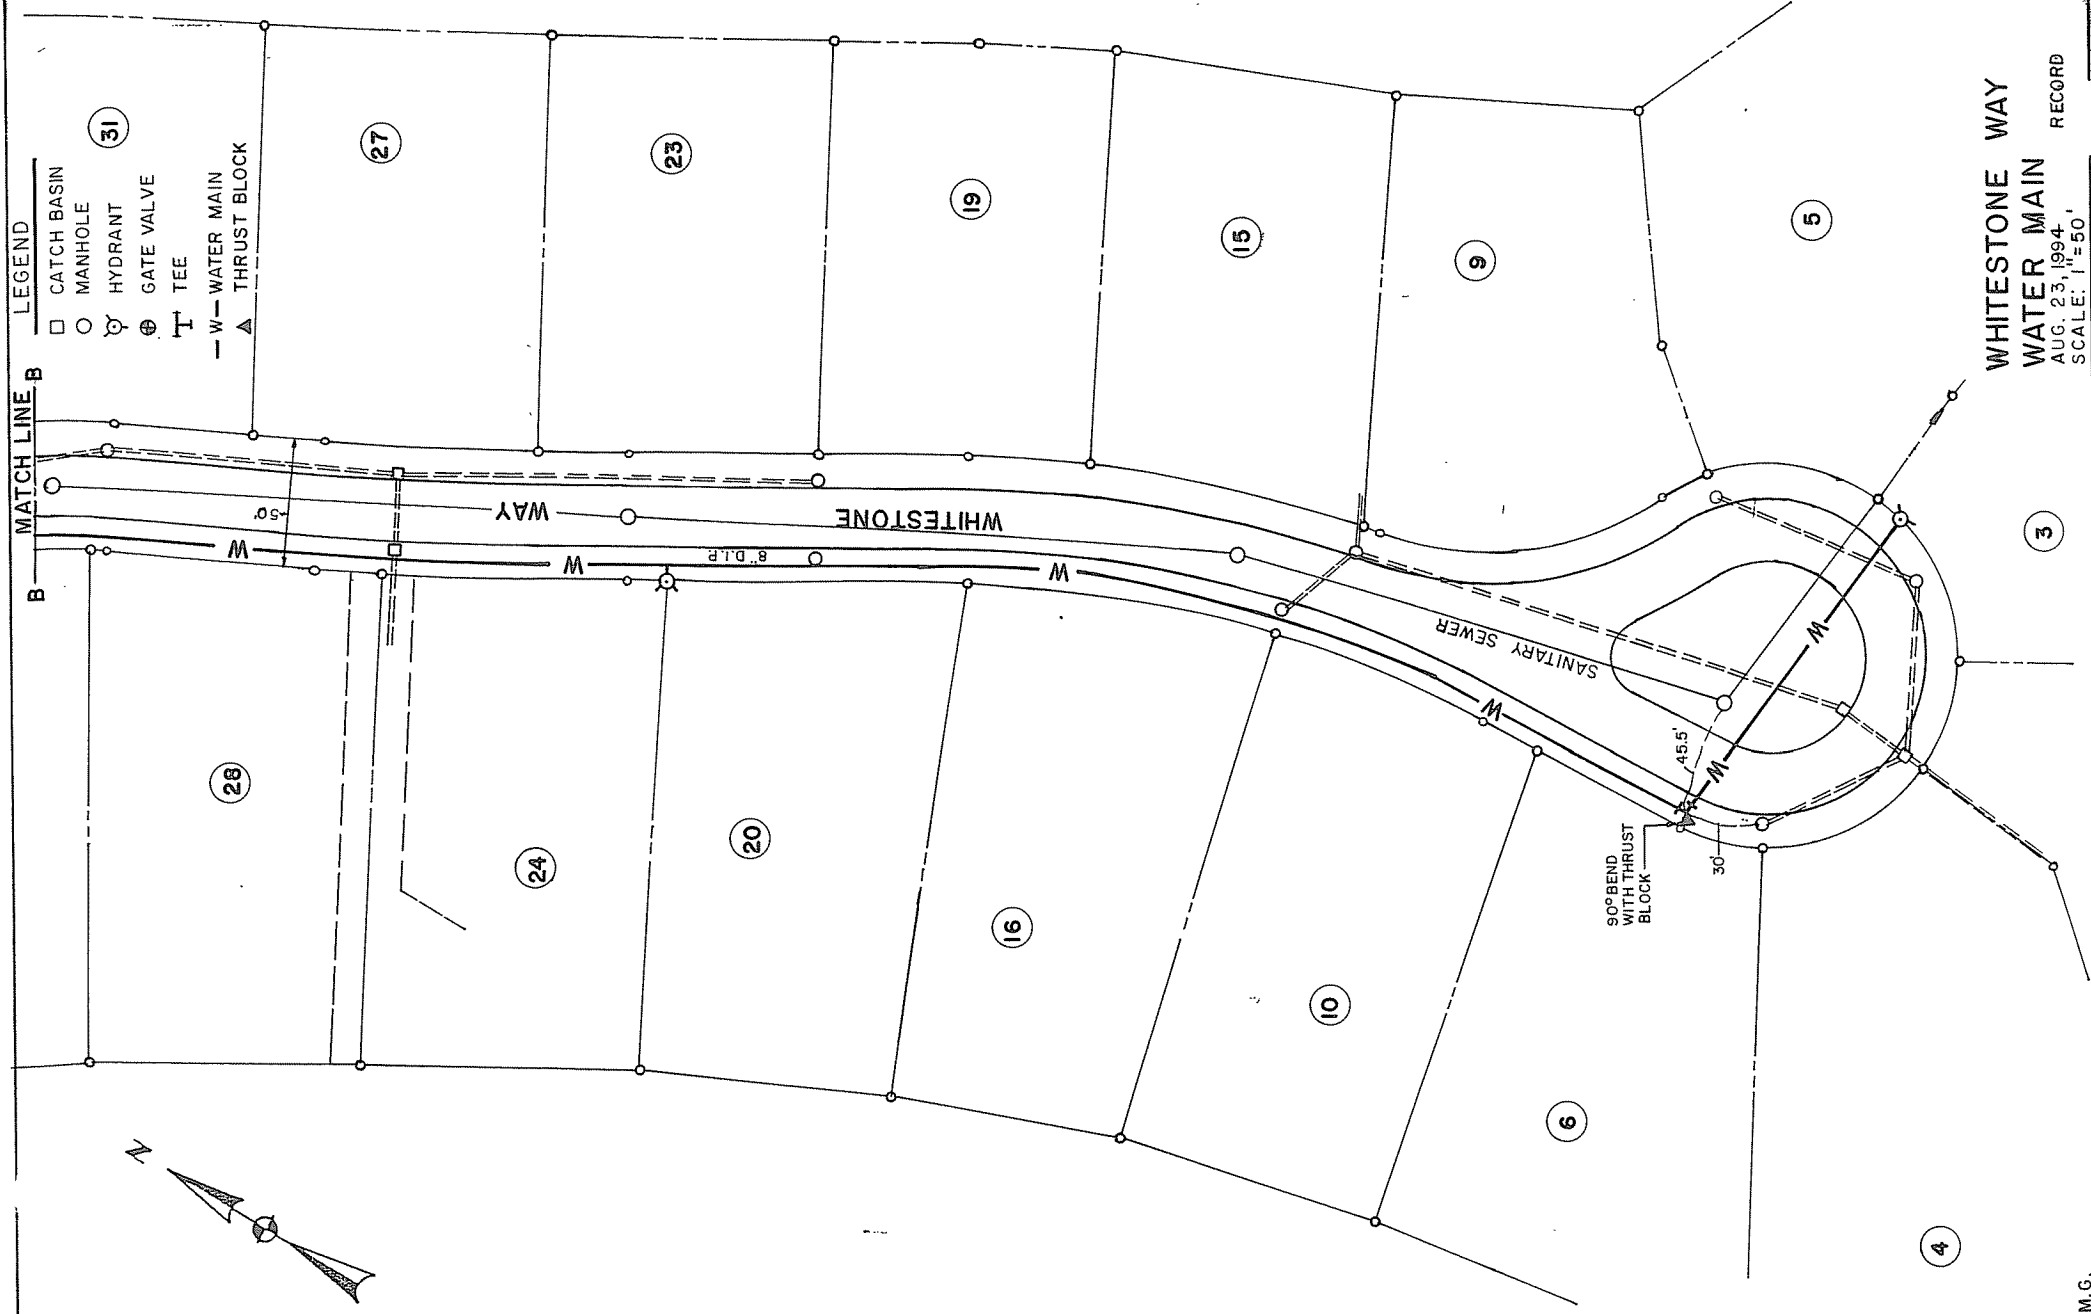


LEGEND

- CATCH BASIN
- MANHOLE
- ⊗ HYDRANT
- ⊕ GATE VALVE
- ⊥ TEE
- W — WATER MAIN
- ▲ THRUST BLOCK

MATCH LINE B

B

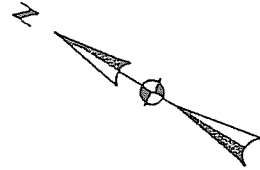

WHITESTONE WAY
WATER MAIN

AUG. 23, 1994
SCALE: 1" = 50'

M.G.

Printed on 11/11/94

RECORD