


LEGEND

- CATCH BASIN
- MANHOLE
- ⊙ HYDRANT
- ⊕ GATE VALVE
- ⊥ TEE
- △ THRUST BLOCK
- W— WATER MAIN
- SS— SANITARY SEWER
- ST--- STORM SEWER

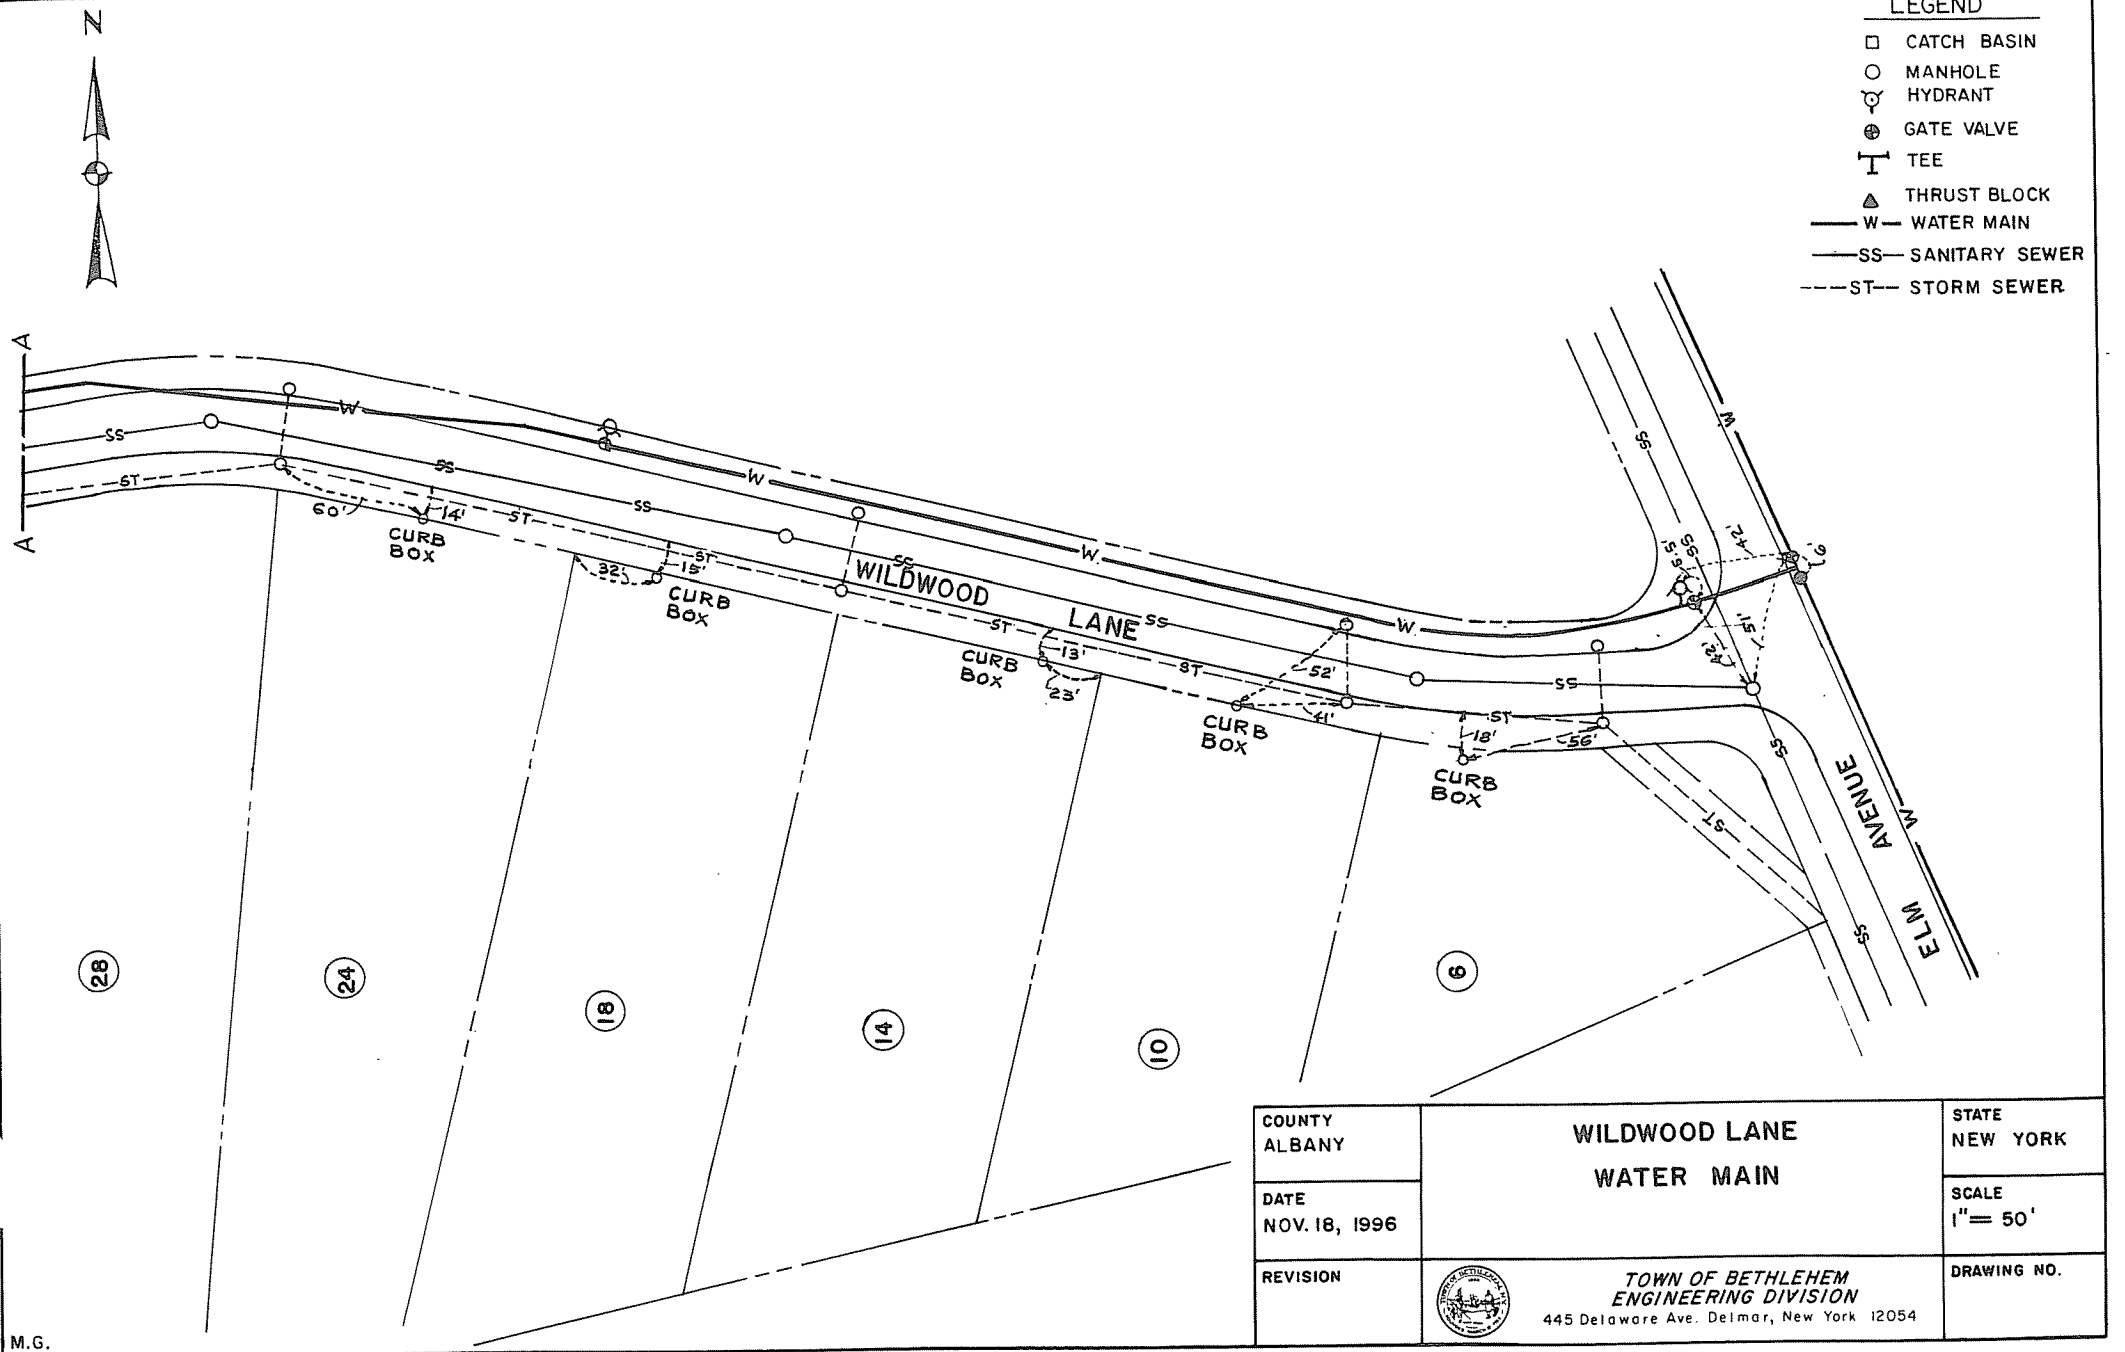

COUNTY ALBANY	WILDWOOD LANE WATER MAIN	STATE NEW YORK
DATE NOV. 18, 1996		SCALE 1" = 50'
REVISION	 TOWN OF BETHLEHEM ENGINEERING DIVISION 445 Delaware Ave. Delmar, New York 12054	DRAWING NO.