
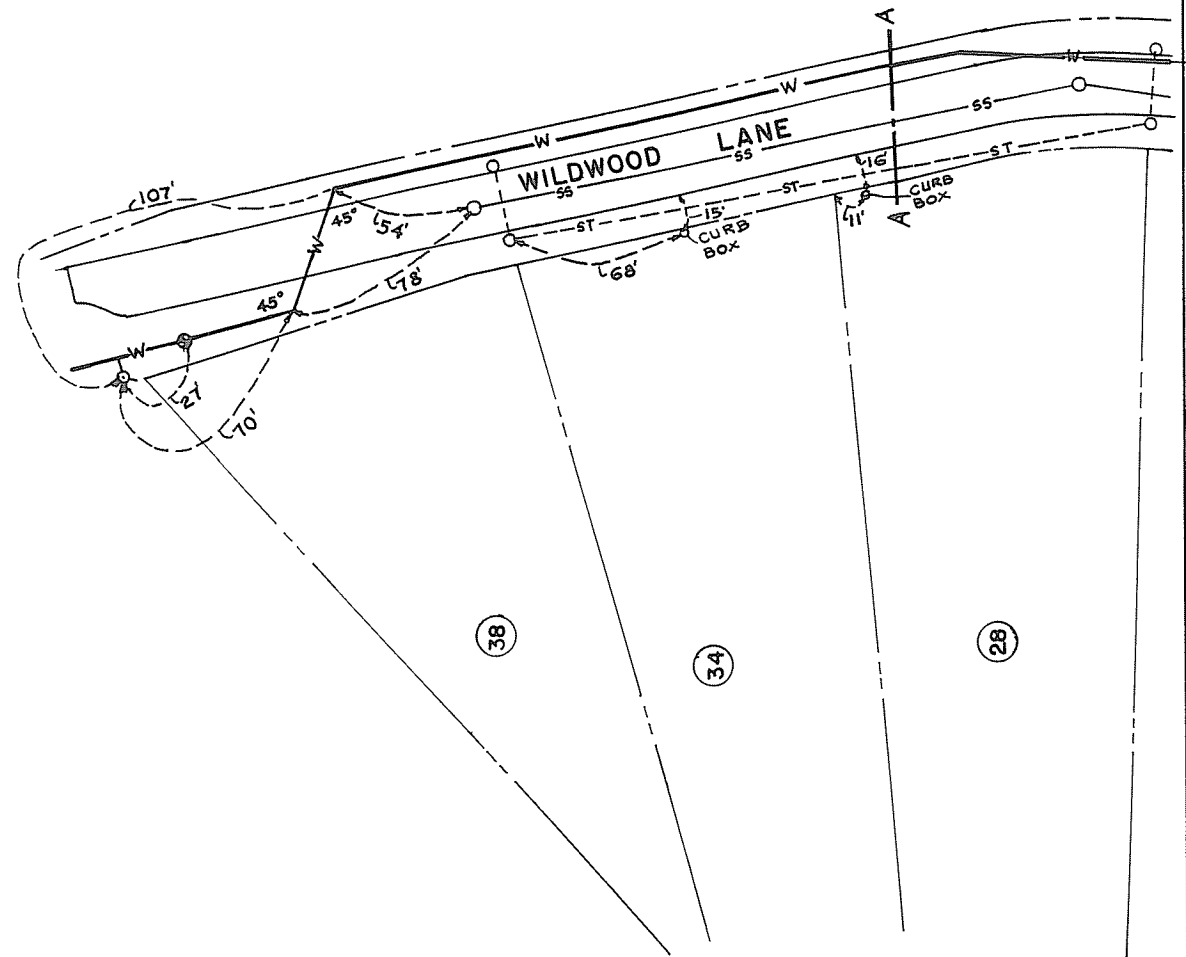


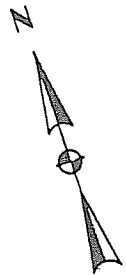

LEGEND

- CATCH BASIN
- MANHOLE
- ⊕ HYDRANT
- ⊕ GATE VALVE
- ⊕ TEE
- ▲ THRUST BLOCK
- W — WATER MAIN
- SS — SANITARY SEWER
- - - ST - - STORM SEWER

M.G.

COUNTY ALBANY	WILDWOOD LANE WATER MAIN	STATE NEW YORK
DATE NOV. 18, 1996		SCALE 1" = 50'
REVISION	 TOWN OF BETHLEHEM ENGINEERING DIVISION 445 Delaware Ave. Delmar, New York 12054	DRAWING NO.