


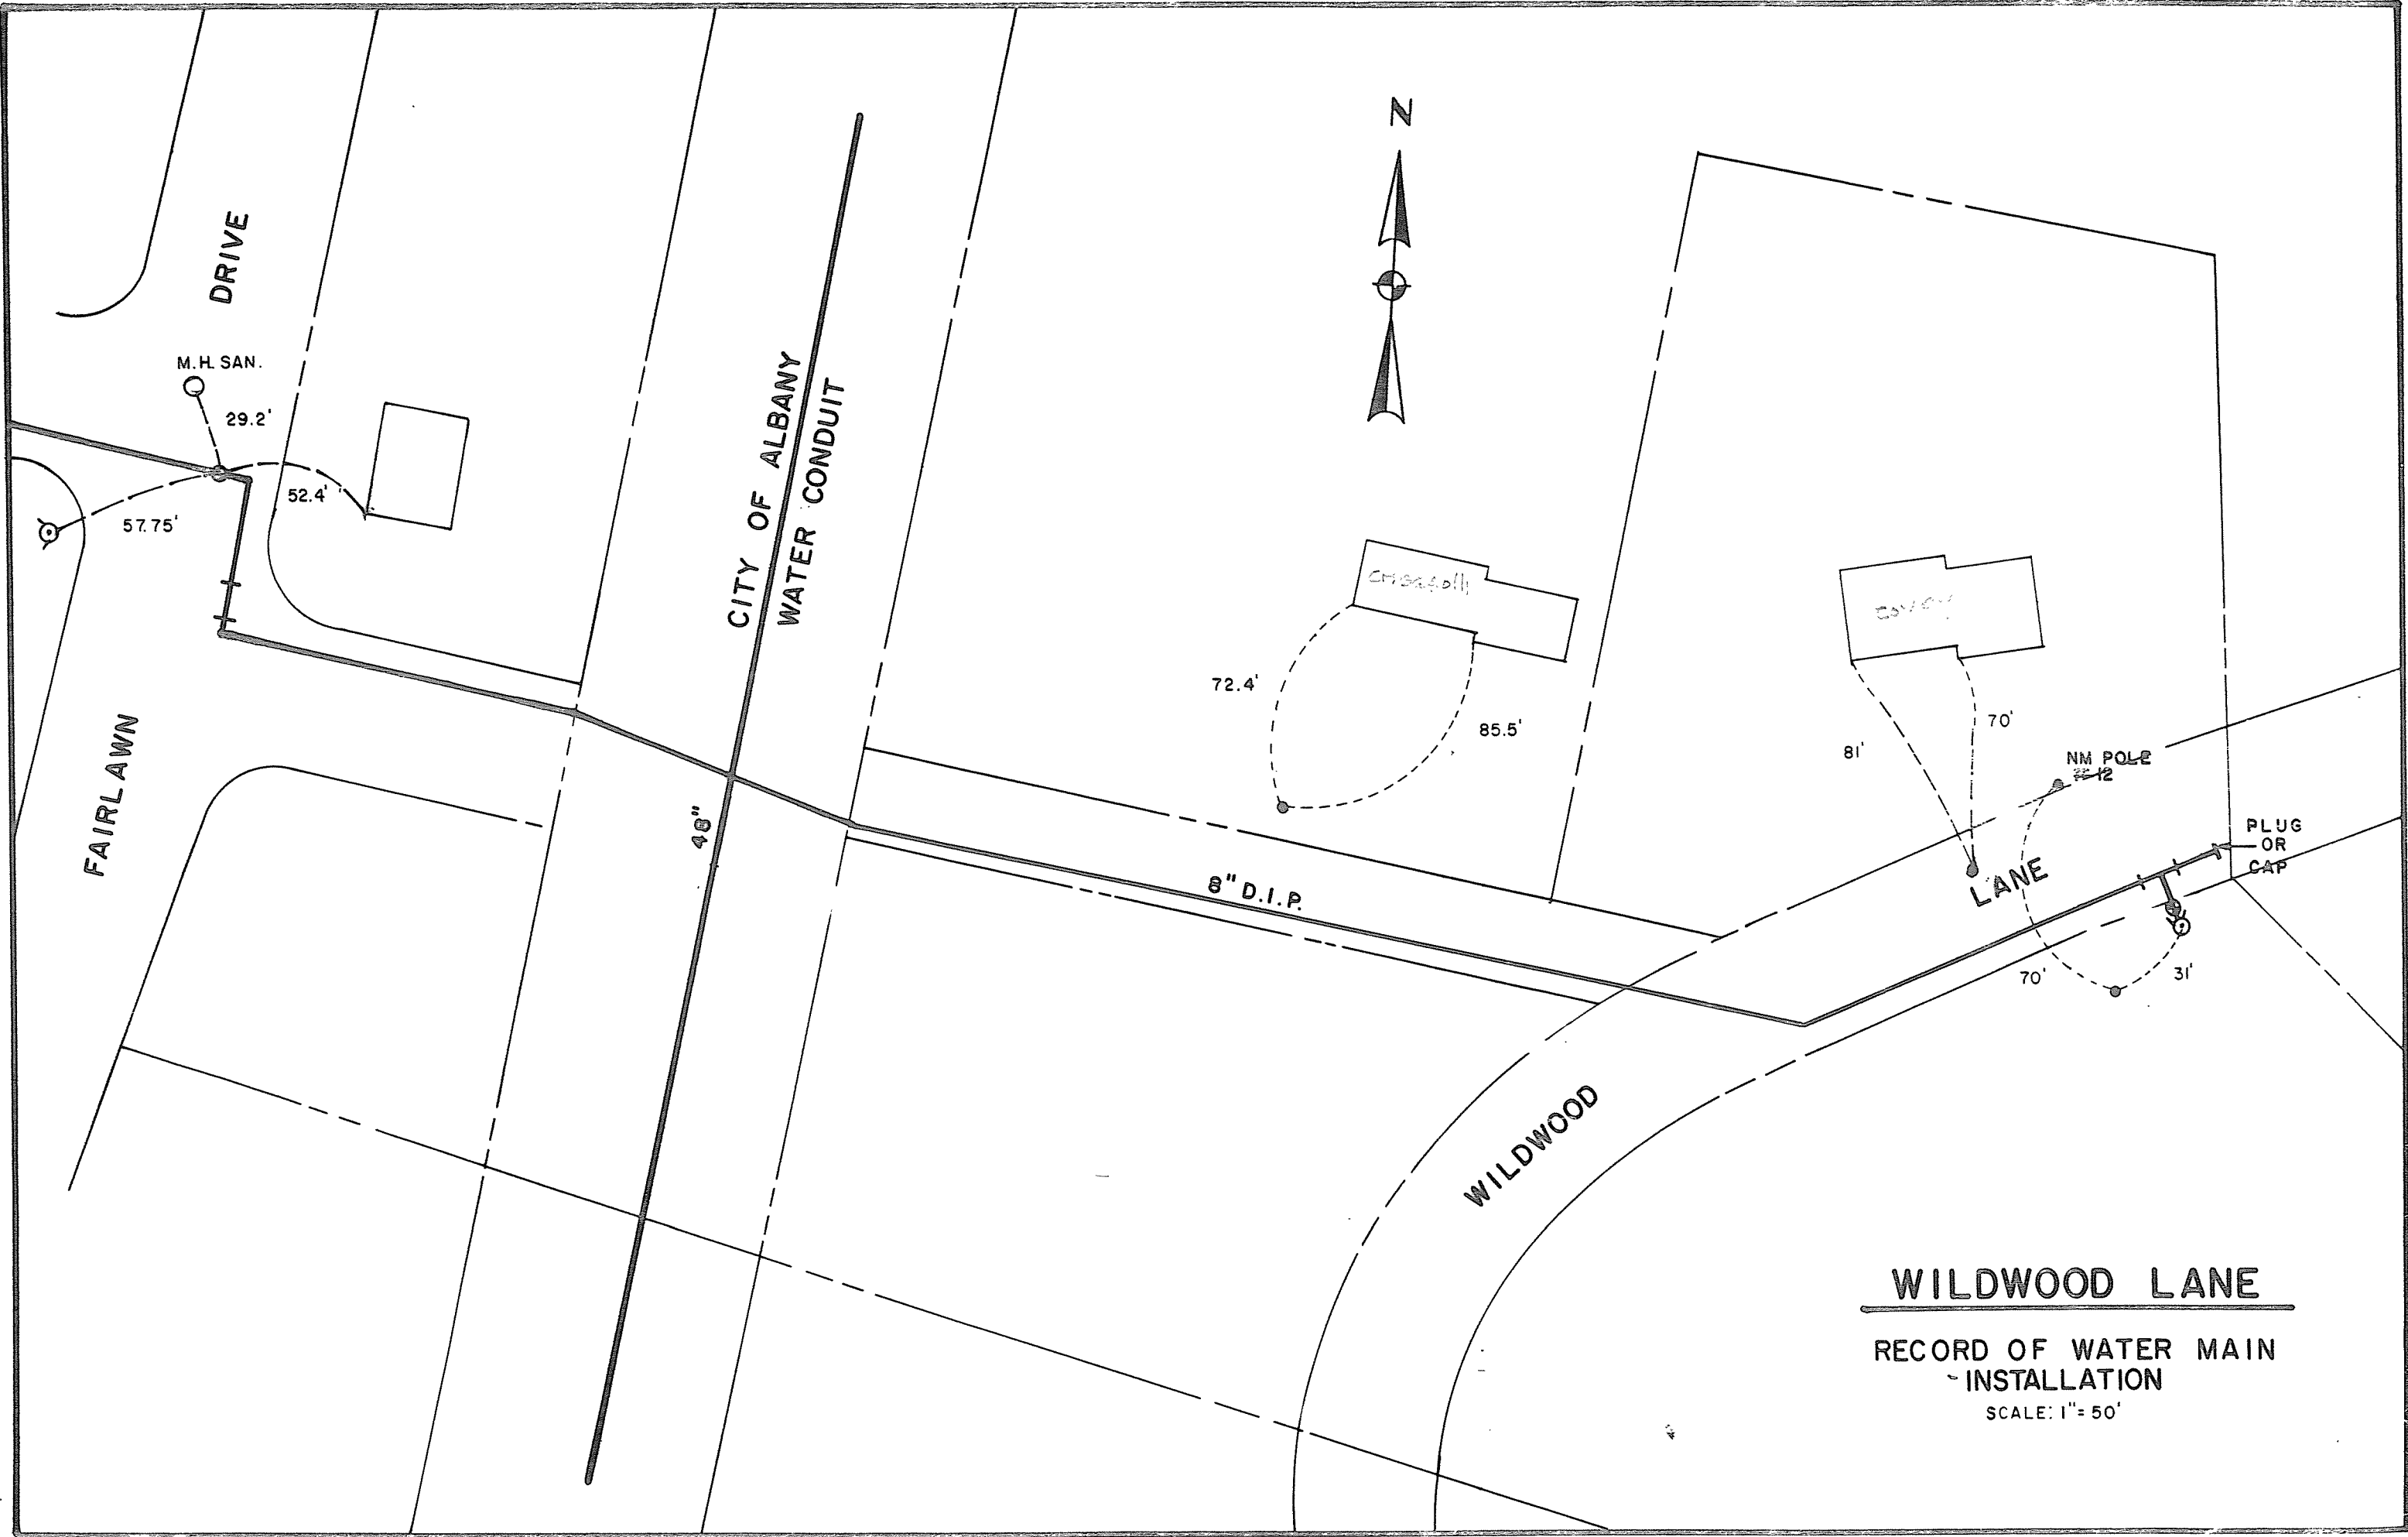

WILDWOOD LANE

**RECORD OF WATER MAIN
INSTALLATION**

SCALE: 1" = 50'