

TIES

	Stn.	C.B.
1	27.9	6'
2	31	9'
3	30.5	8'

PATROON PLACE

6" D.G.V. & HYDRANT

8" D.G.V.S

SANITARY SEWER MANHOLE

8" D.I.P.

6' TYPICAL


8" D.G.V.'S CATCH BASIN

SANITARY SEWER MANHOLE

WILHELMINA WAY

8" D.I.P.

6' TYPICAL

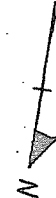

WINDMILL DRIVE

6" D.G.V. & HYD.

MATCH TO SHEET #2

MATCH TO SHEET #3

MATCH TO SHEET #3

HAGUE BLVD.

DOWERSKILL VILLAGE
WATER DISTRICT NO. 1
TOWN OF BETHLEHEM
RECORD OF INSTALLATIONS
Scale: 1"=50' Dec. 1975
J. Kenneth Fraser & Associates, P. C.
Consulting Engineers Rensselaer, N.Y.

60-7

WINDMILL DRIVE
WILHELMINA WAY.