
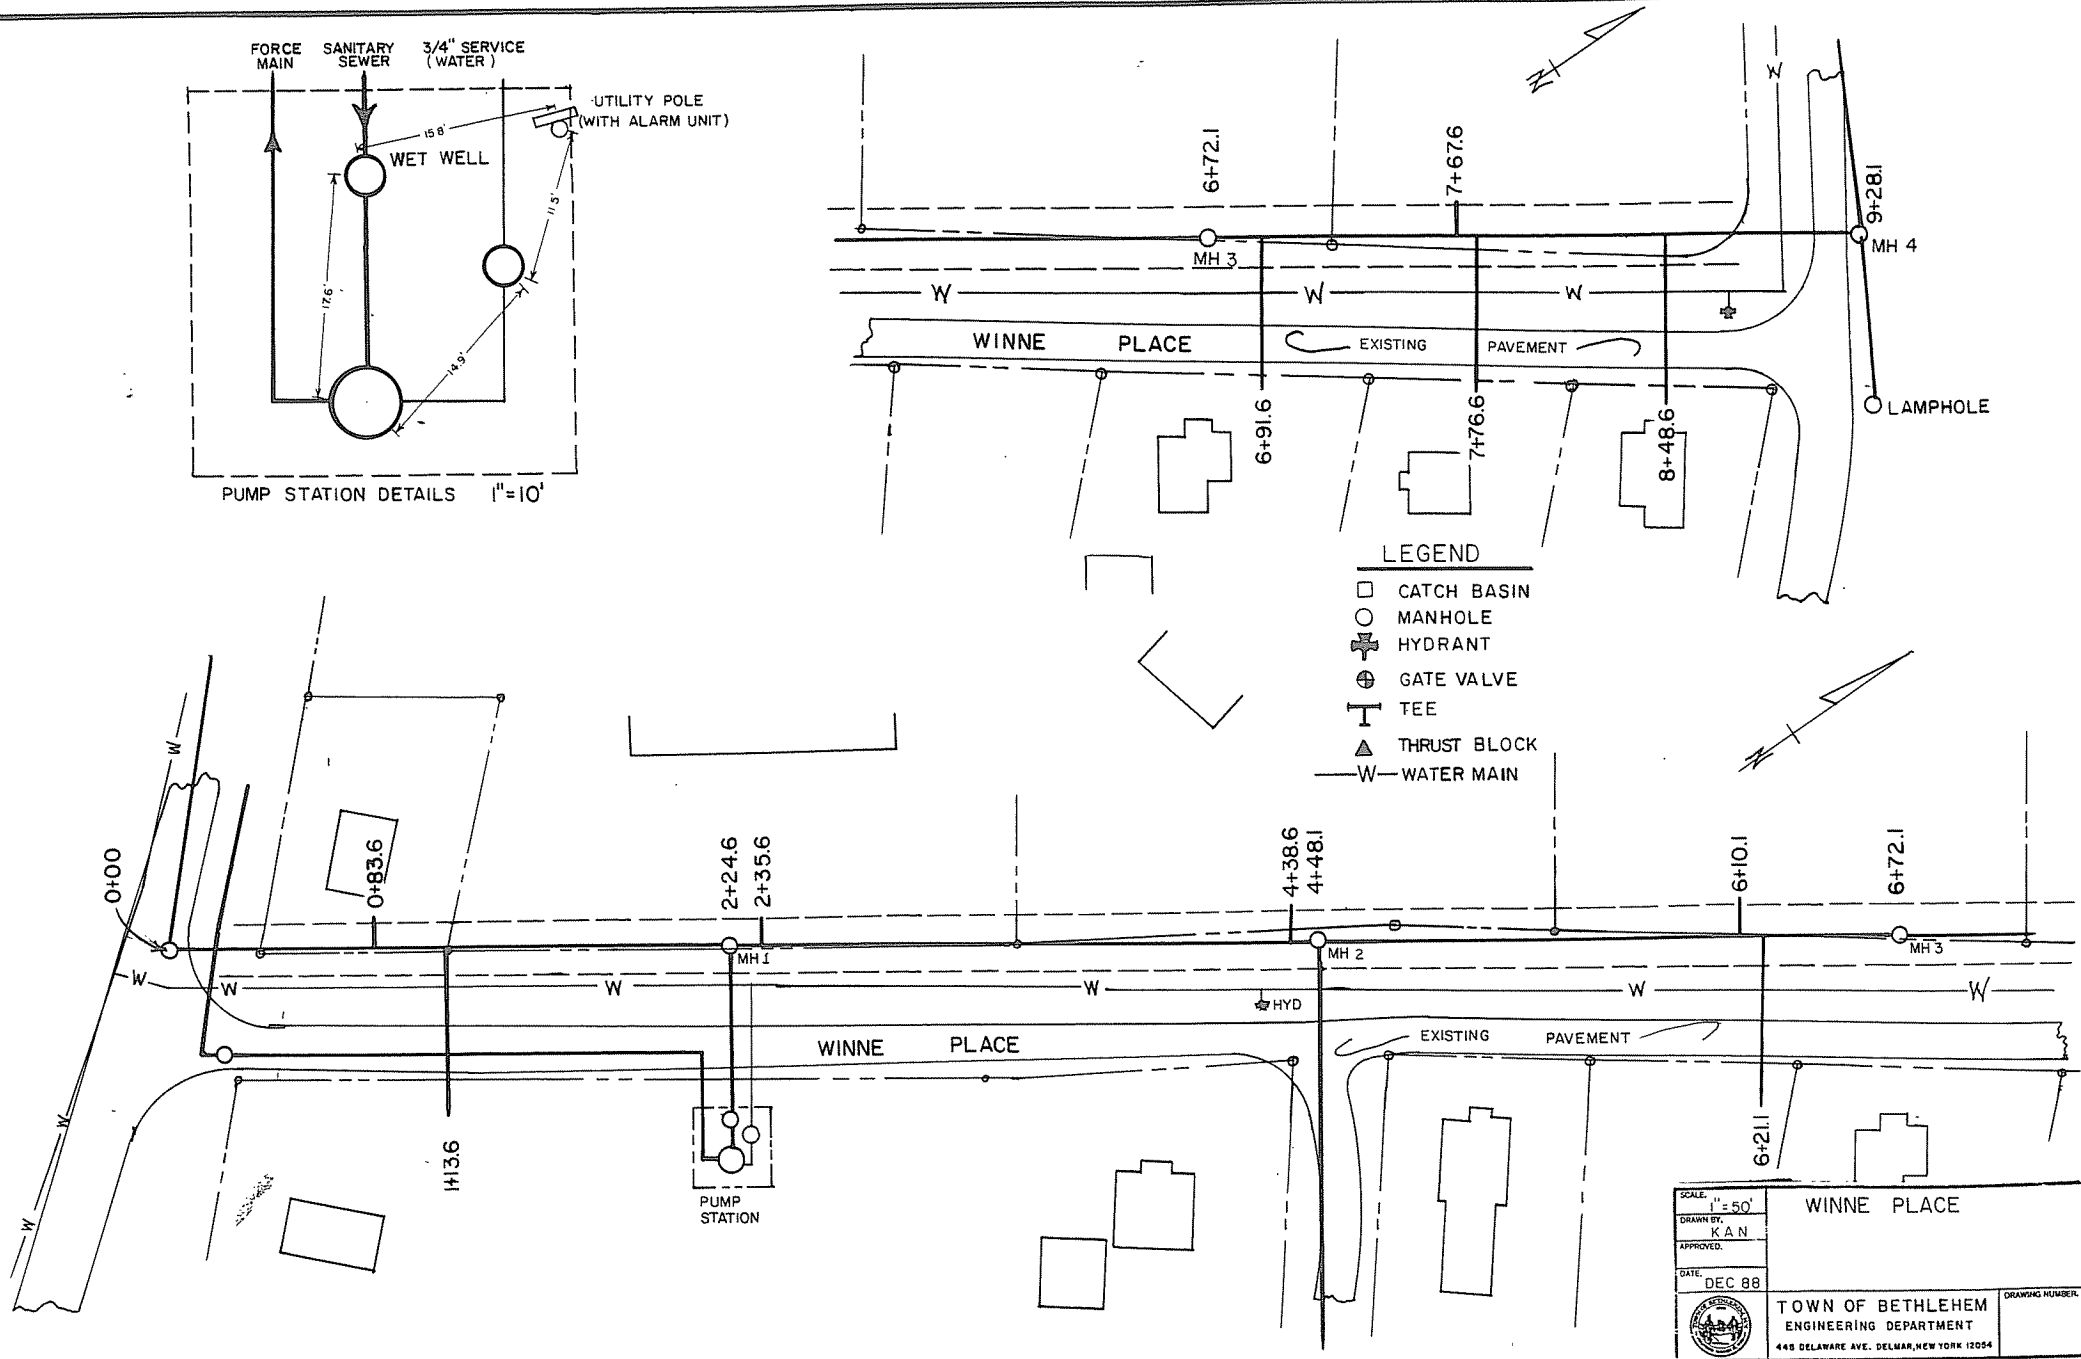


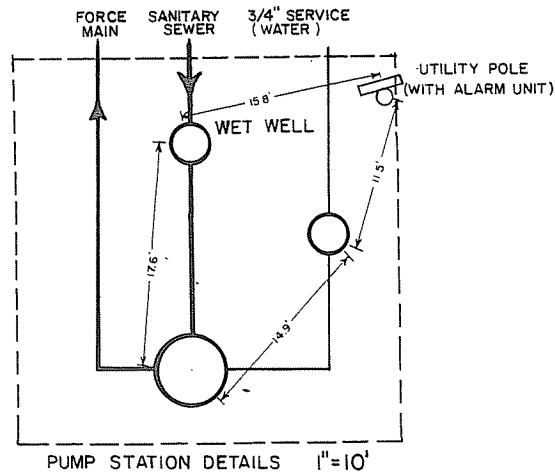

LEGEND

- CATCH BASIN
- MANHOLE
- ⊕ HYDRANT
- ⊕ GATE VALVE
- ⊕ TEE
- ▲ THRUST BLOCK
- W — WATER MAIN

SCALE: 1"=50'		WINNE PLACE	
DRAWN BY: KAN		TOWN OF BETHLEHEM ENGINEERING DEPARTMENT 445 DELAWARE AVE. DELMAR, NEW YORK 12054	
APPROVED:			
DATE: DEC 88			
DRAWING NUMBER:			