

WINNE ROAD
WATER DISTRICT NO. I
TOWN OF BETHLEHEM


RECORD OF INSTALLATION
TOWN OF BETHLEHEM ENGINEERING
DEPARTMENT

SCALE: 1" = 50' FEBRUARY, 1982

DWN. BY: PDH

N

JORDAN BLVD.

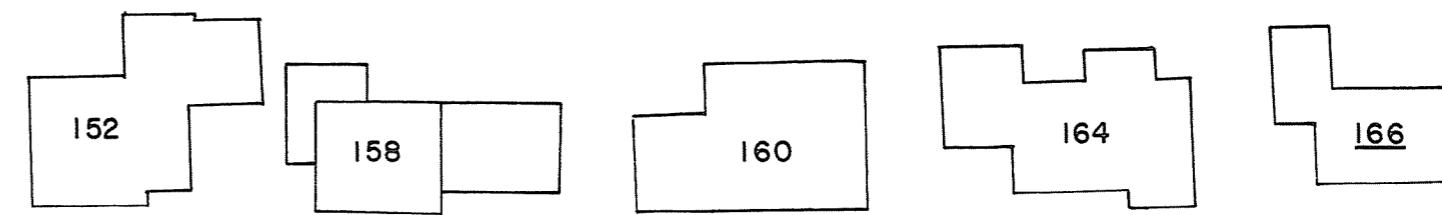

WINNE ROAD

JORDAN BLVD.

