


WINNE ROAD
WATER DISTRICT NO.1
TOWN OF BETHLEHEM
RECORD OF INSTALLATION
TOWN OF BETHLEHEM ENGINEERING
DEPARTMENT
SCALE: 1" = 50' FEBRUARY, 1982
DWN. BY: PDH



WINNE

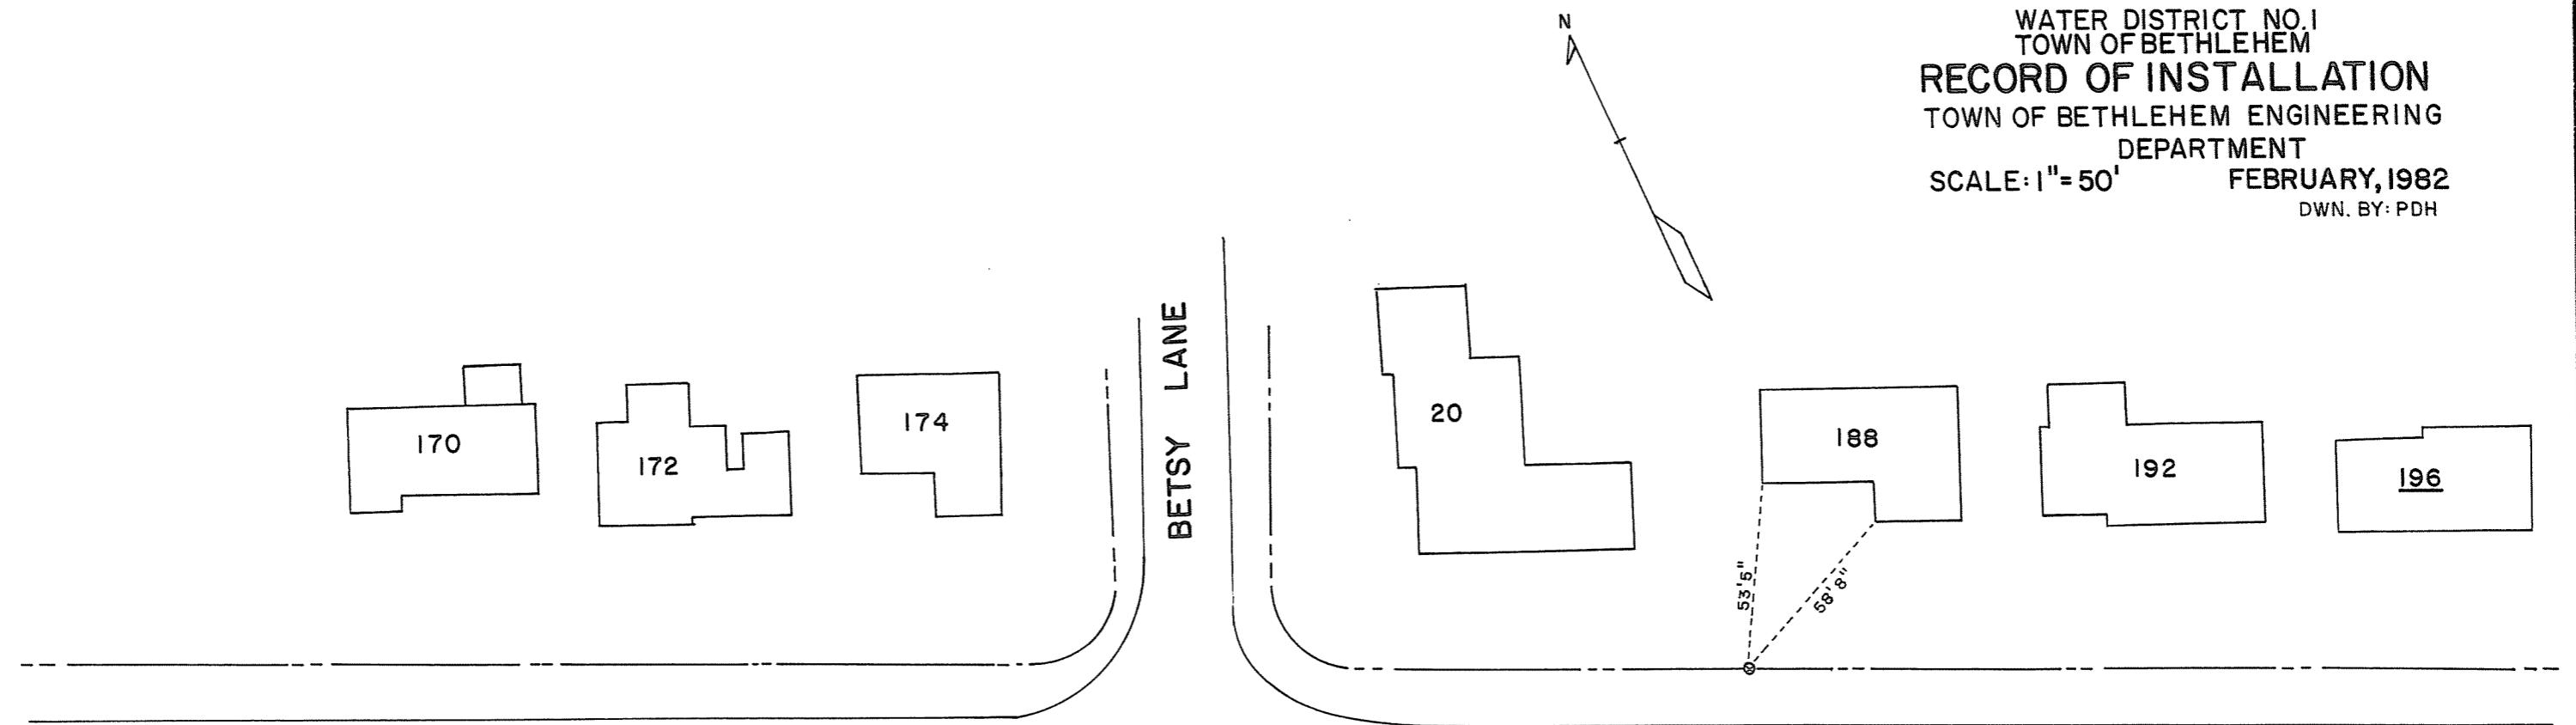