

WINNE ROAD

WATER DISTRICT NO 1

TOWN OF BETHLEHEM


RECORD OF INSTALLATION

TOWN OF BETHLEHEM ENGINEERING DEPT

SCALE 1"=100'

OCTOBER, 1984

DWN BY JES

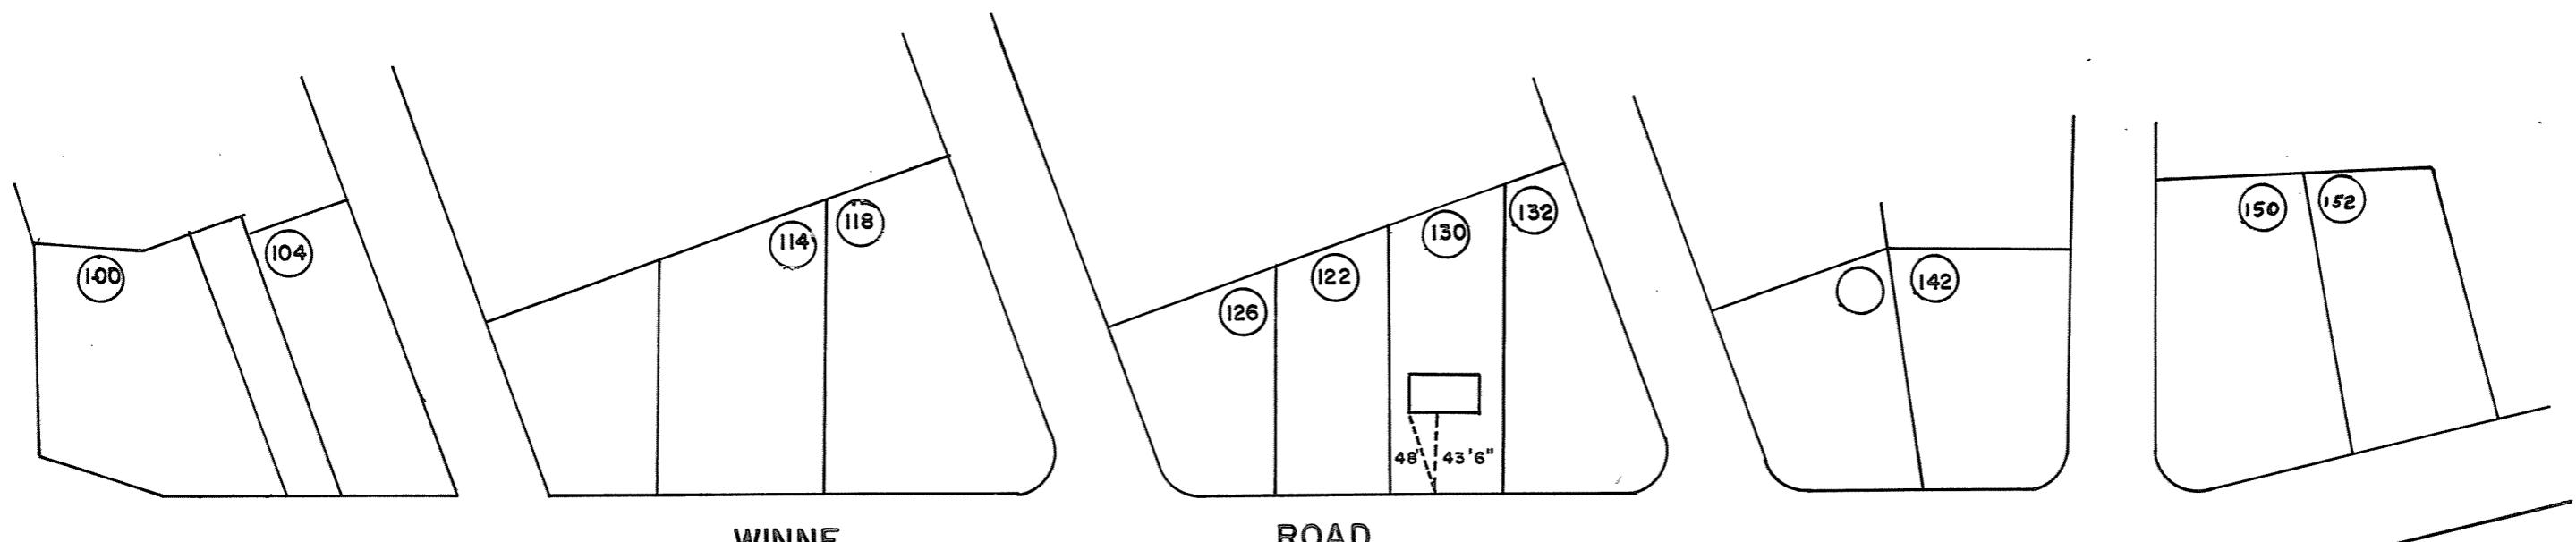

WINNE

ROAD

