



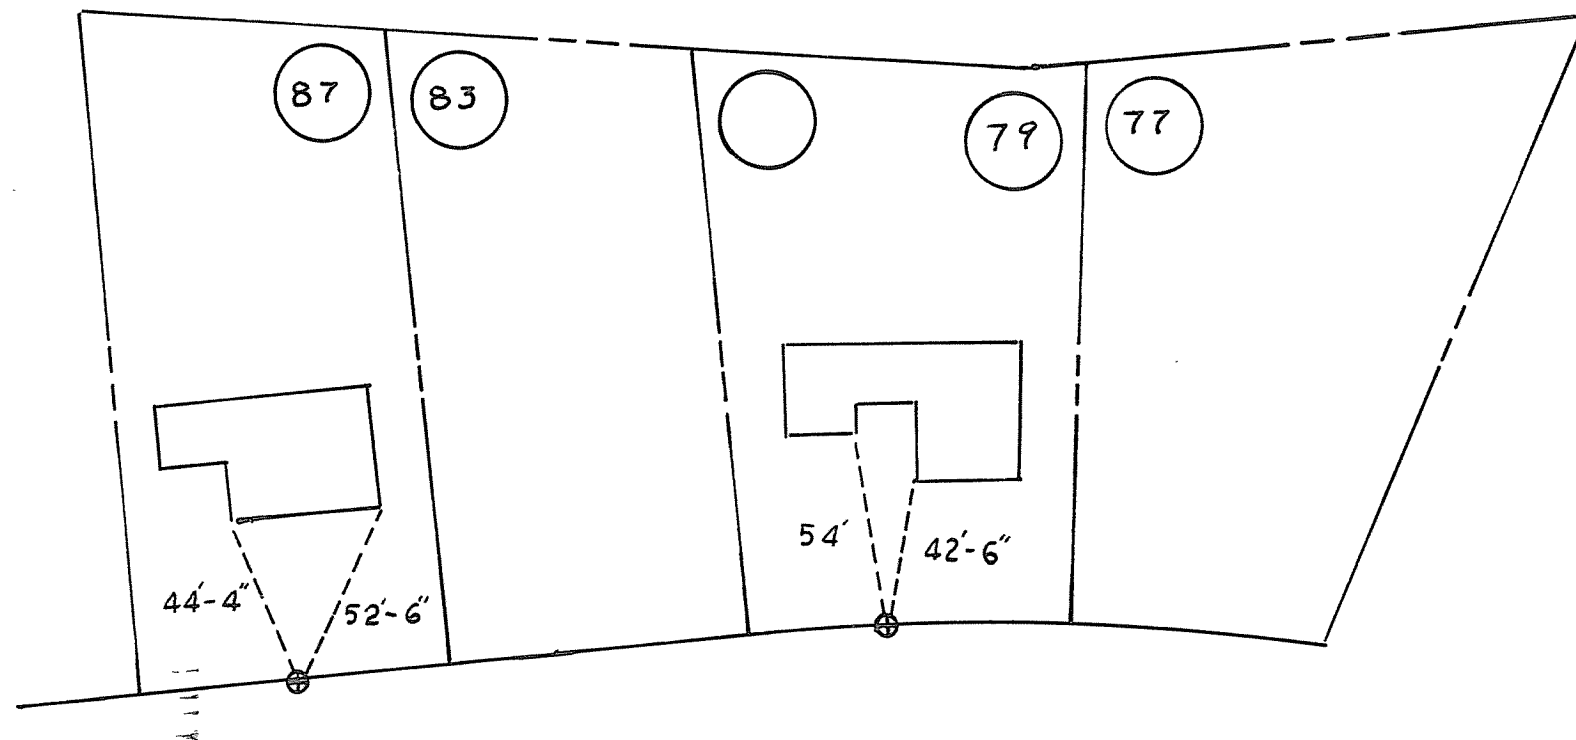

WISCONSIN AVENUE

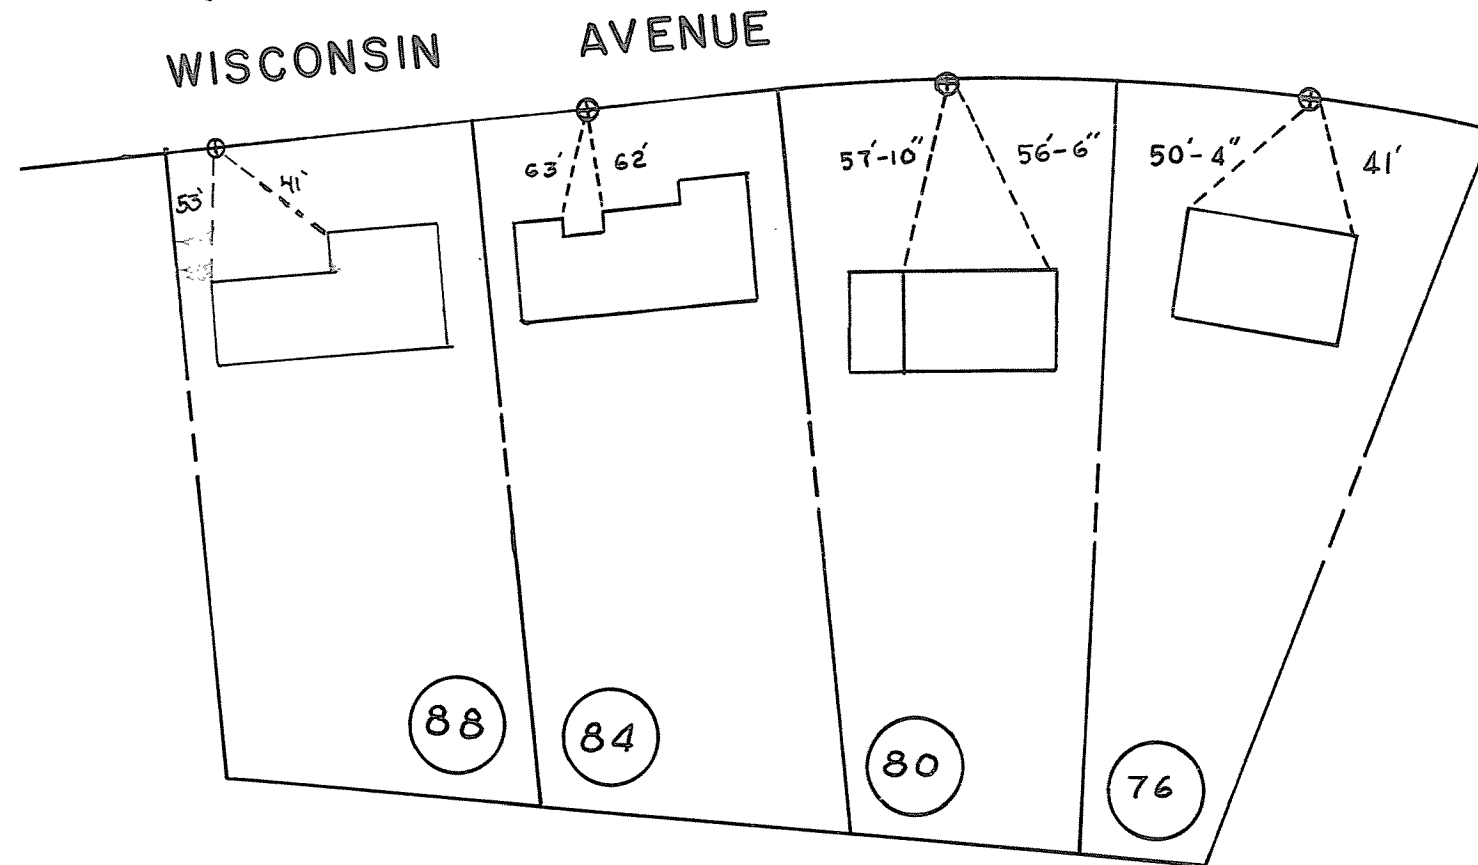

|                          |                                                                                           |
|--------------------------|-------------------------------------------------------------------------------------------|
| SCALE<br><b>1" = 50'</b> |                                                                                           |
| DRAWN BY<br><b>R E B</b> |                                                                                           |
| APPROVED.                |                                                                                           |
| DATE.                    |                                                                                           |
|                          | TOWN OF BETHEL, MAINE<br>ENGINEERING DEPARTMENT<br>FOR RECORD AND RETURN TO TOWN ENGINEER |