



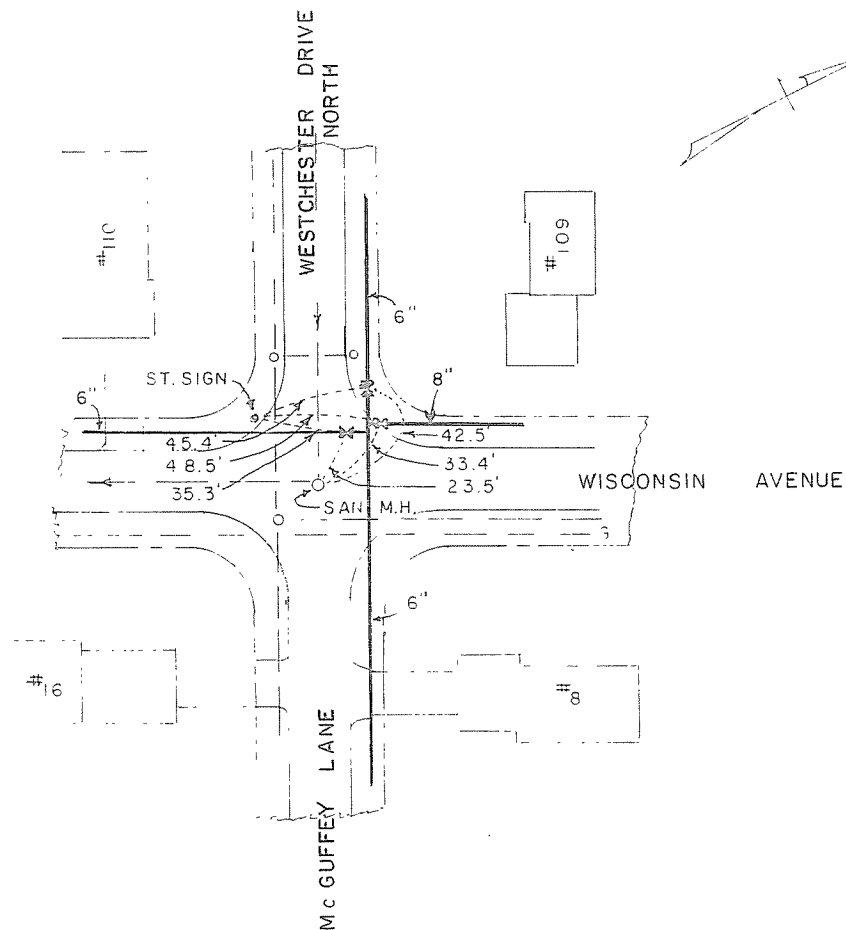

LEGEND

PROPERTY LINE - - - -
 WATER LINE ————

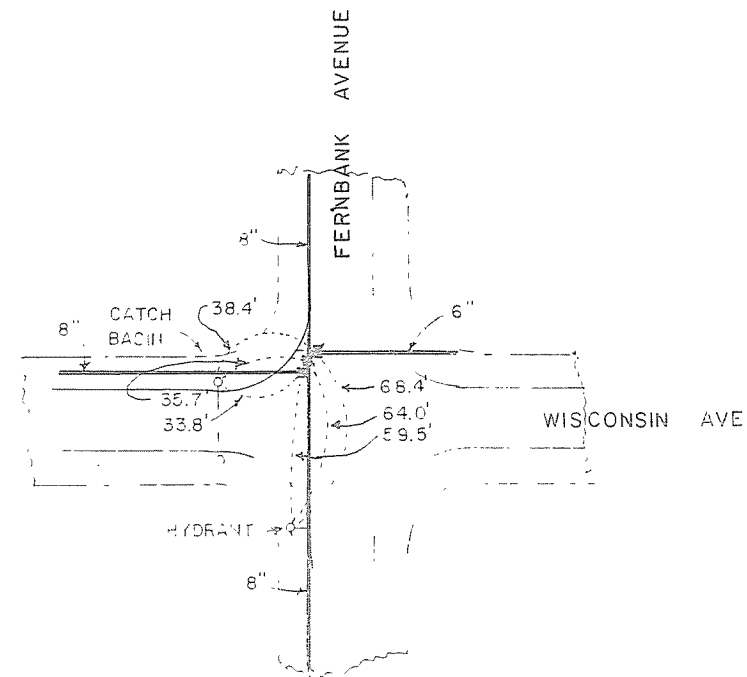

WISCONSIN AVENUE
 WATER DISTRICT NO. 1
 TOWN OF BETHLEHEM

RECORD OF INSTALLATIONS
 J. KENNETH FRASER & ASSOCIATES, P.C.
 CONSULTING ENGRS. RENSSELAER, N. Y.
 SCALE 1" = 50' OCTOBER 1977