


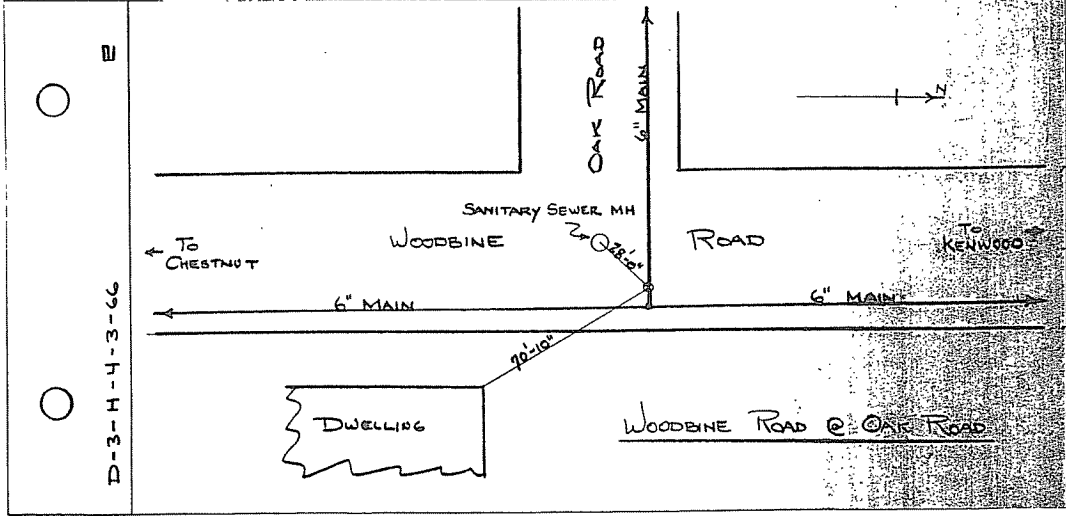

WOODBINE ROAD
WATER MAIN