


DELAWARE AVE.

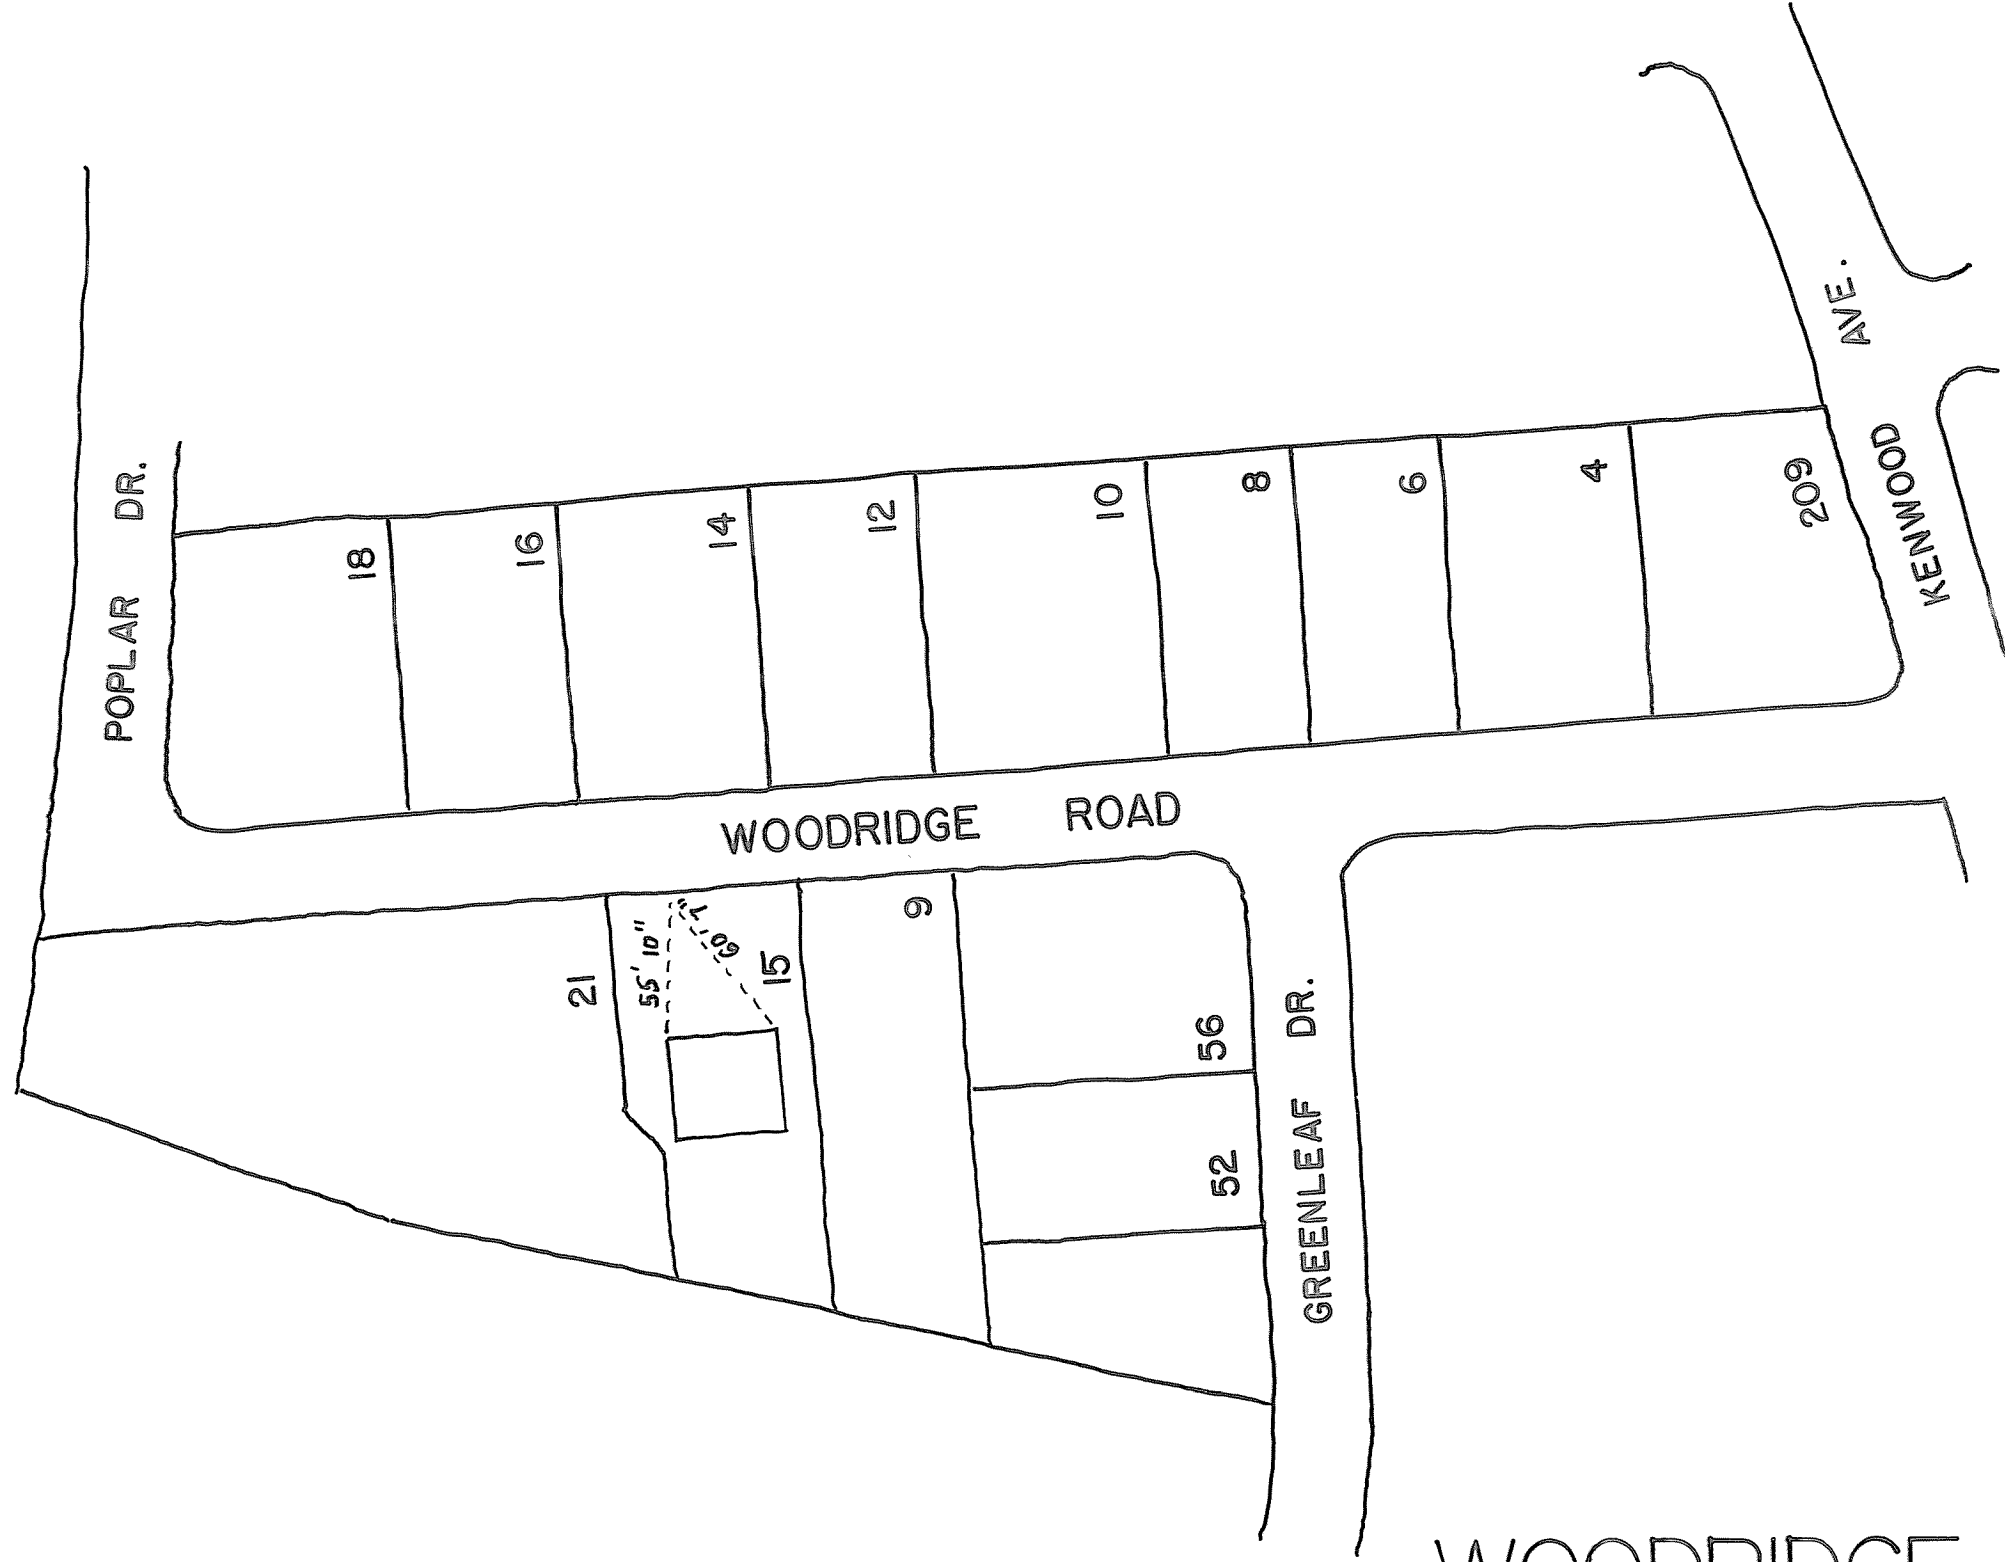

WOODRIDGE ROAD