

YORK ROAD

WATER DISTRICT NO.1

TOWN OF BETHLEHEM



RECORD OF INSTALLATION

TOWN OF BETHLEHEM DEPT.

OF ENGINEERING

SCALE: 1"=50' JUNE, 1984

DRWN. BY AW

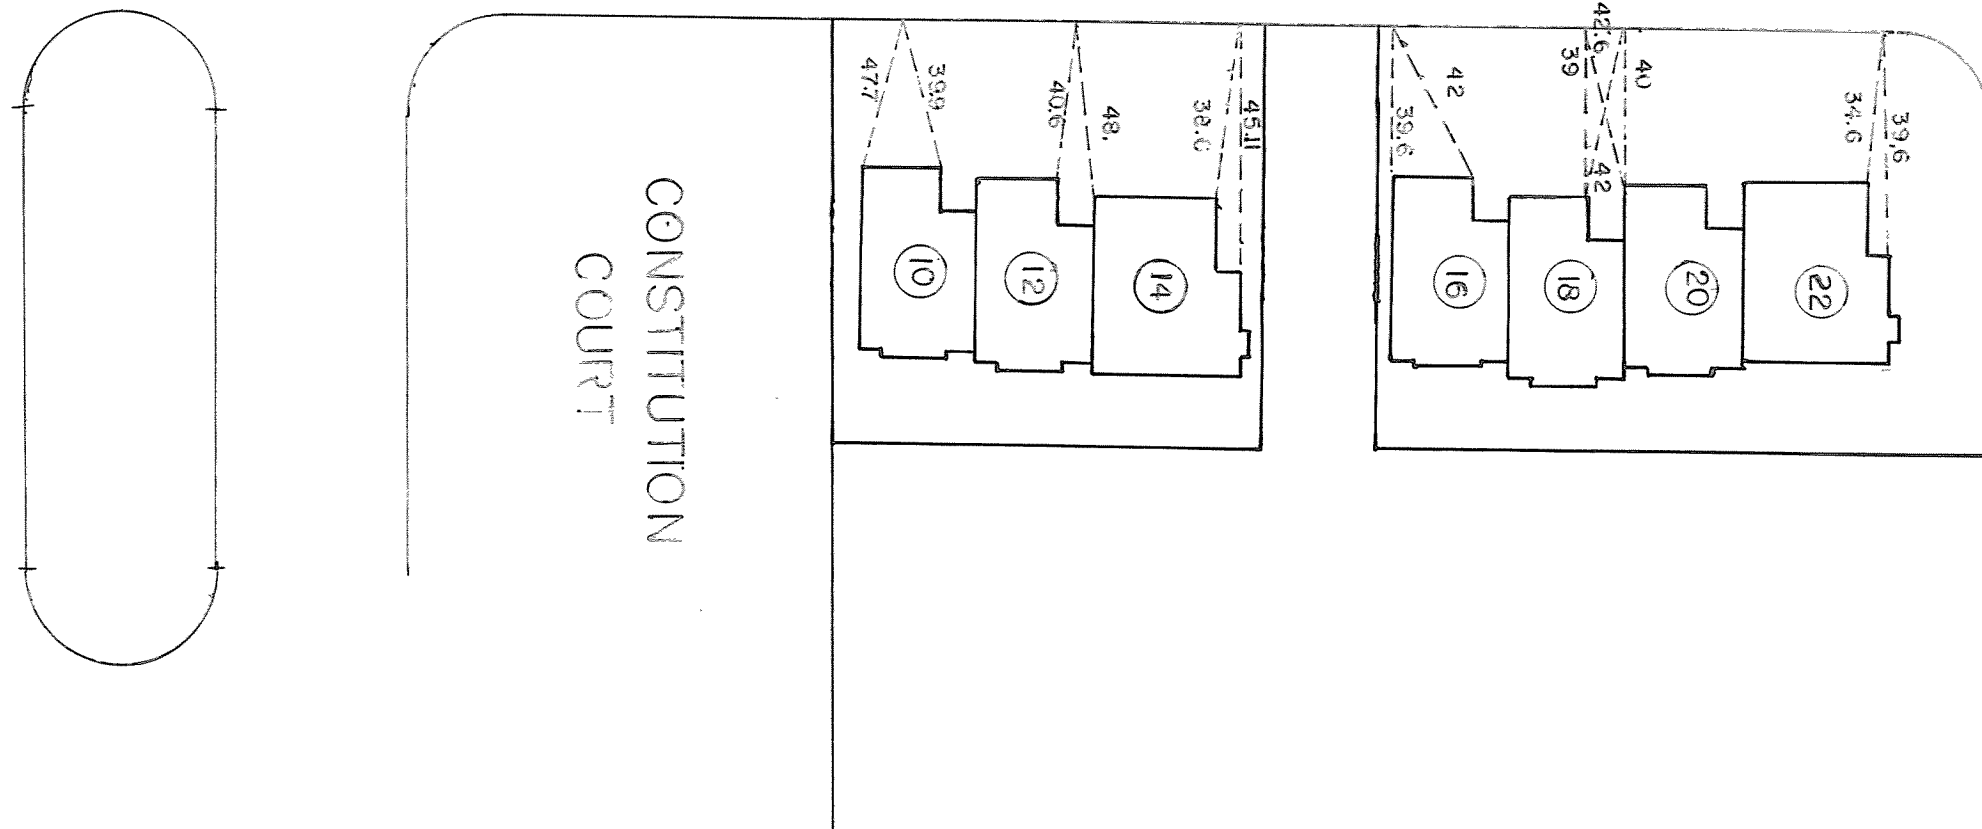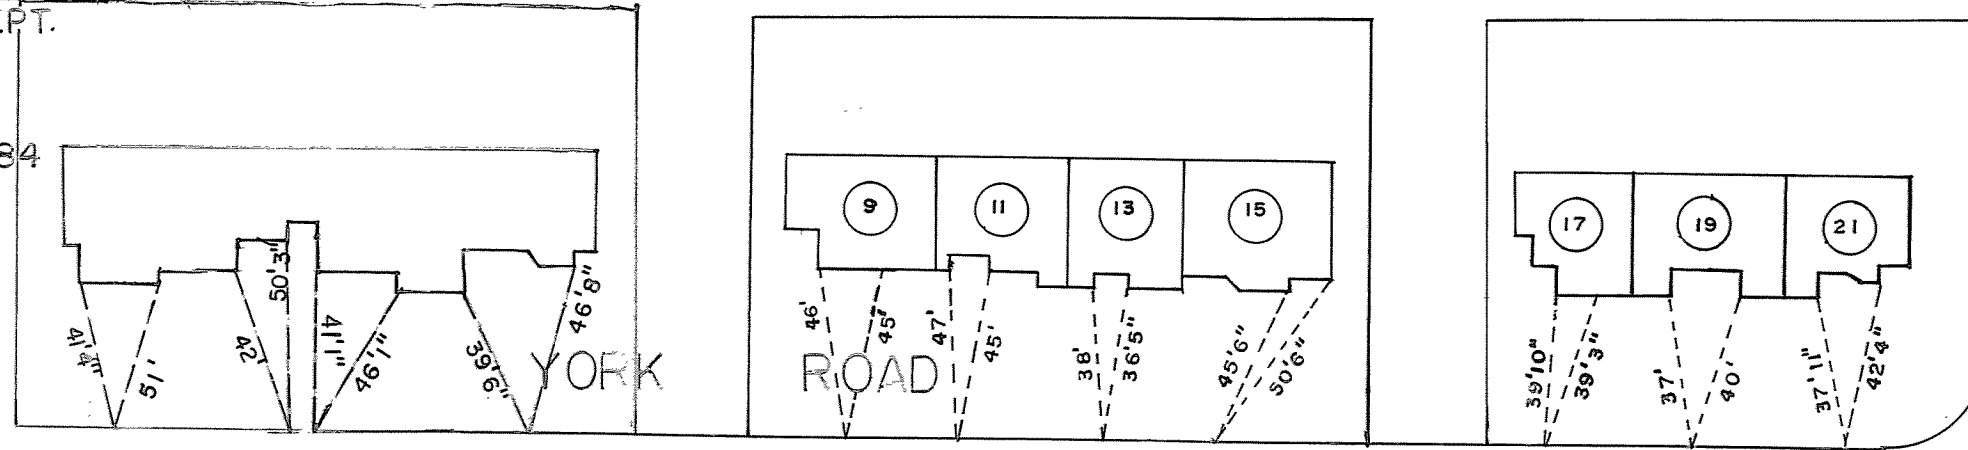

COMMONWEALTH
DRIVE