


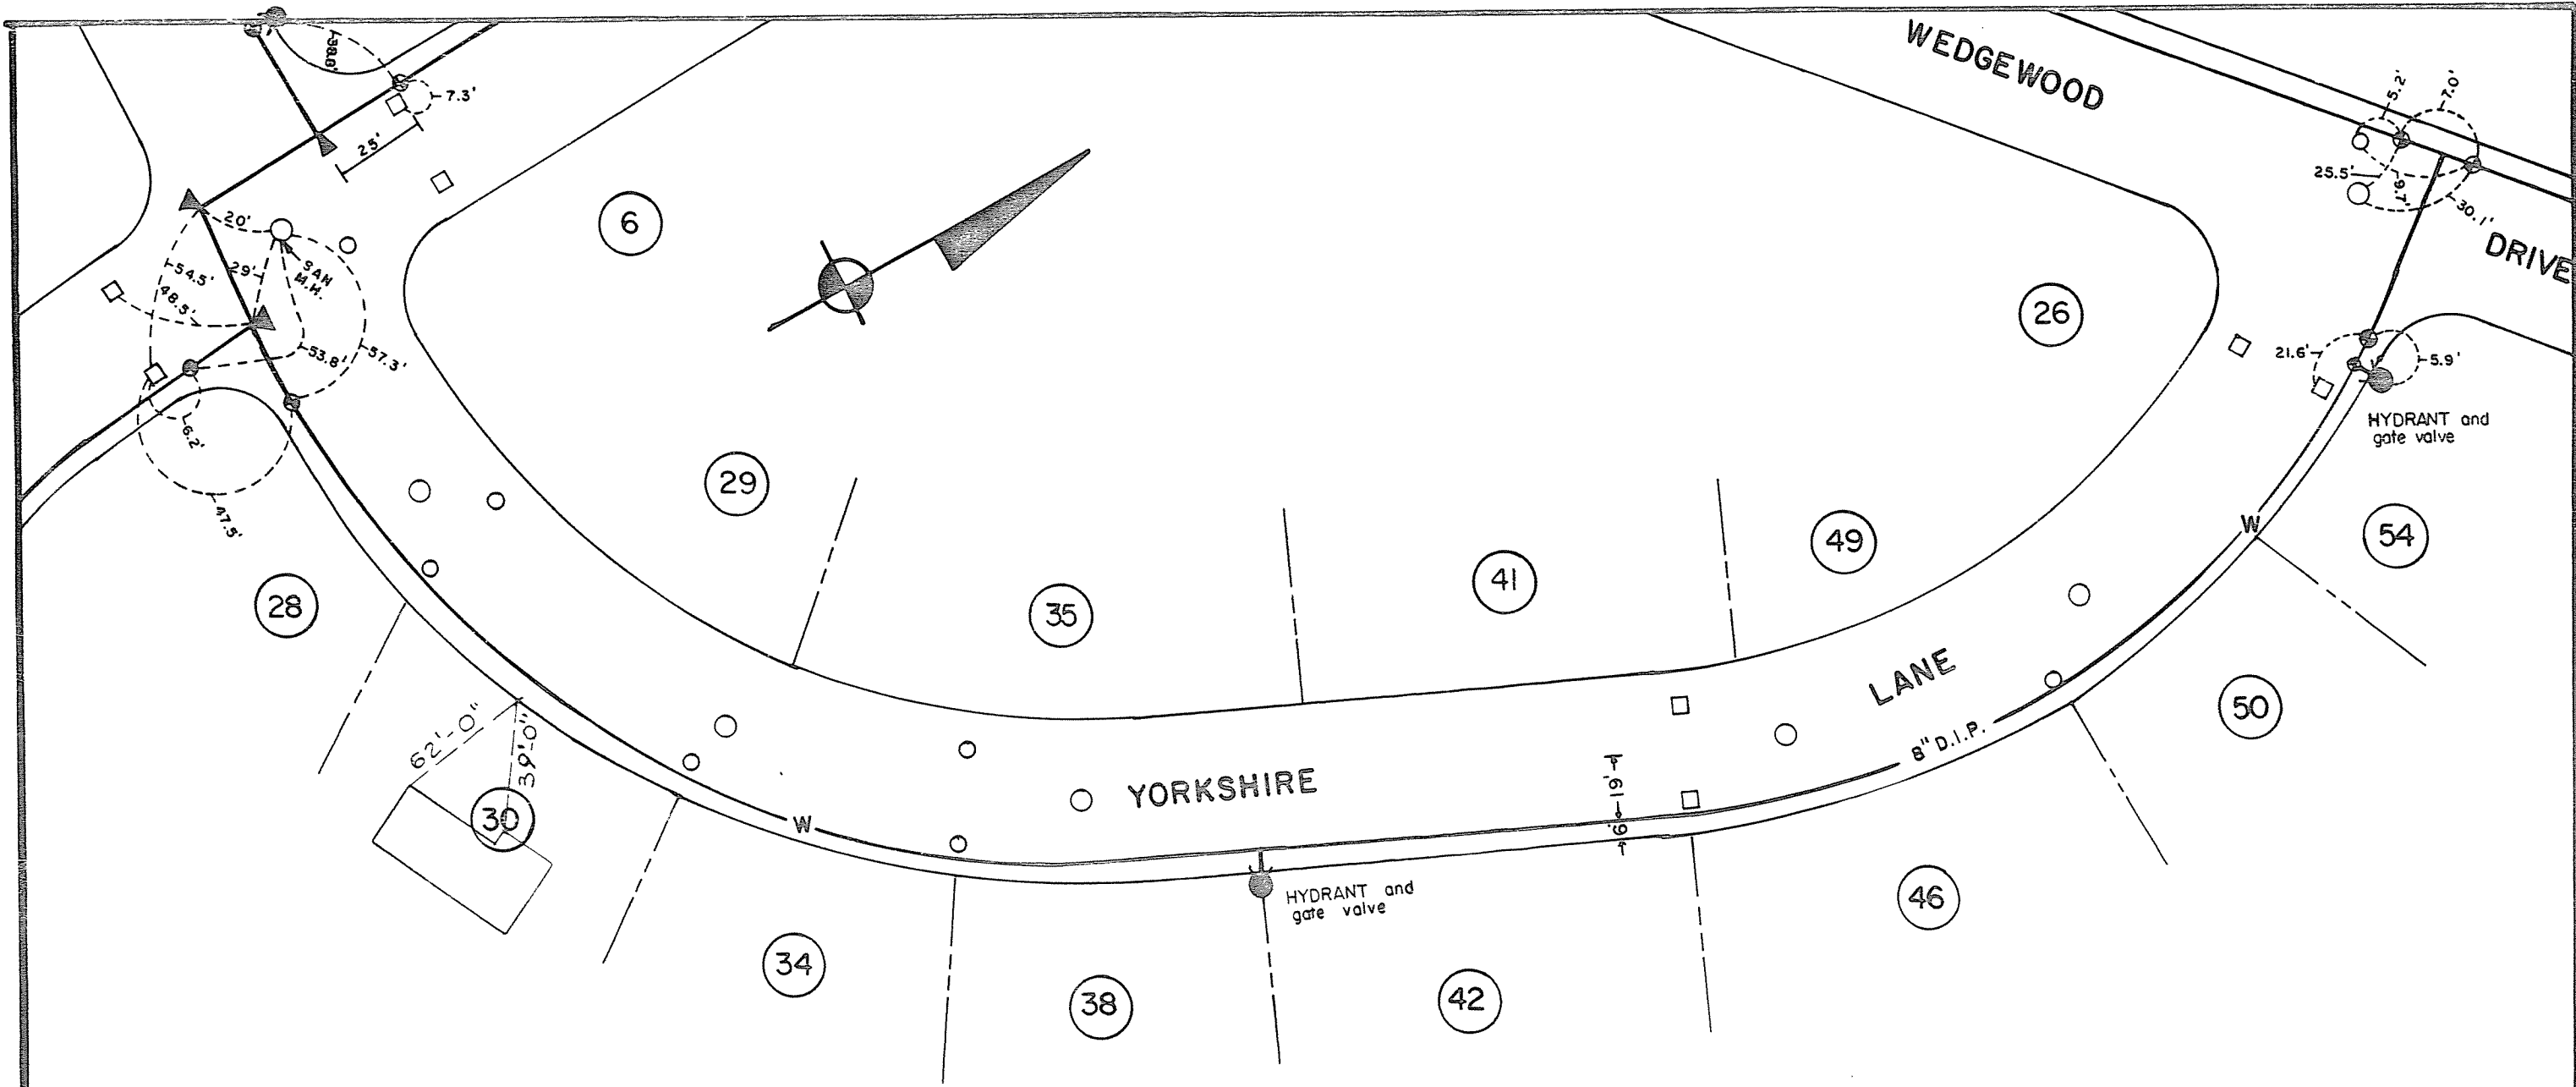

YORKSHIRE LANE
WATER MAIN LOCATIONS
SCALE 1" = 50'
AUGUST 22, 1989
TRINITY CONSTRUCTION