D252784

FED. ROAD REG. NO.	STATE	FEDERAL AID PROJECT NO.	SHEET NO.	TOTAL SHEETS
1	N.Y.	BRM-5605 (5)	66R1	113

GLENMONT - FEURA BUSH, S.H. 367

RTE 32 OVER CONRAIL

TOWNS OF BETHLEHEM & NEW SCOTLAND, ALBANY COUNTY

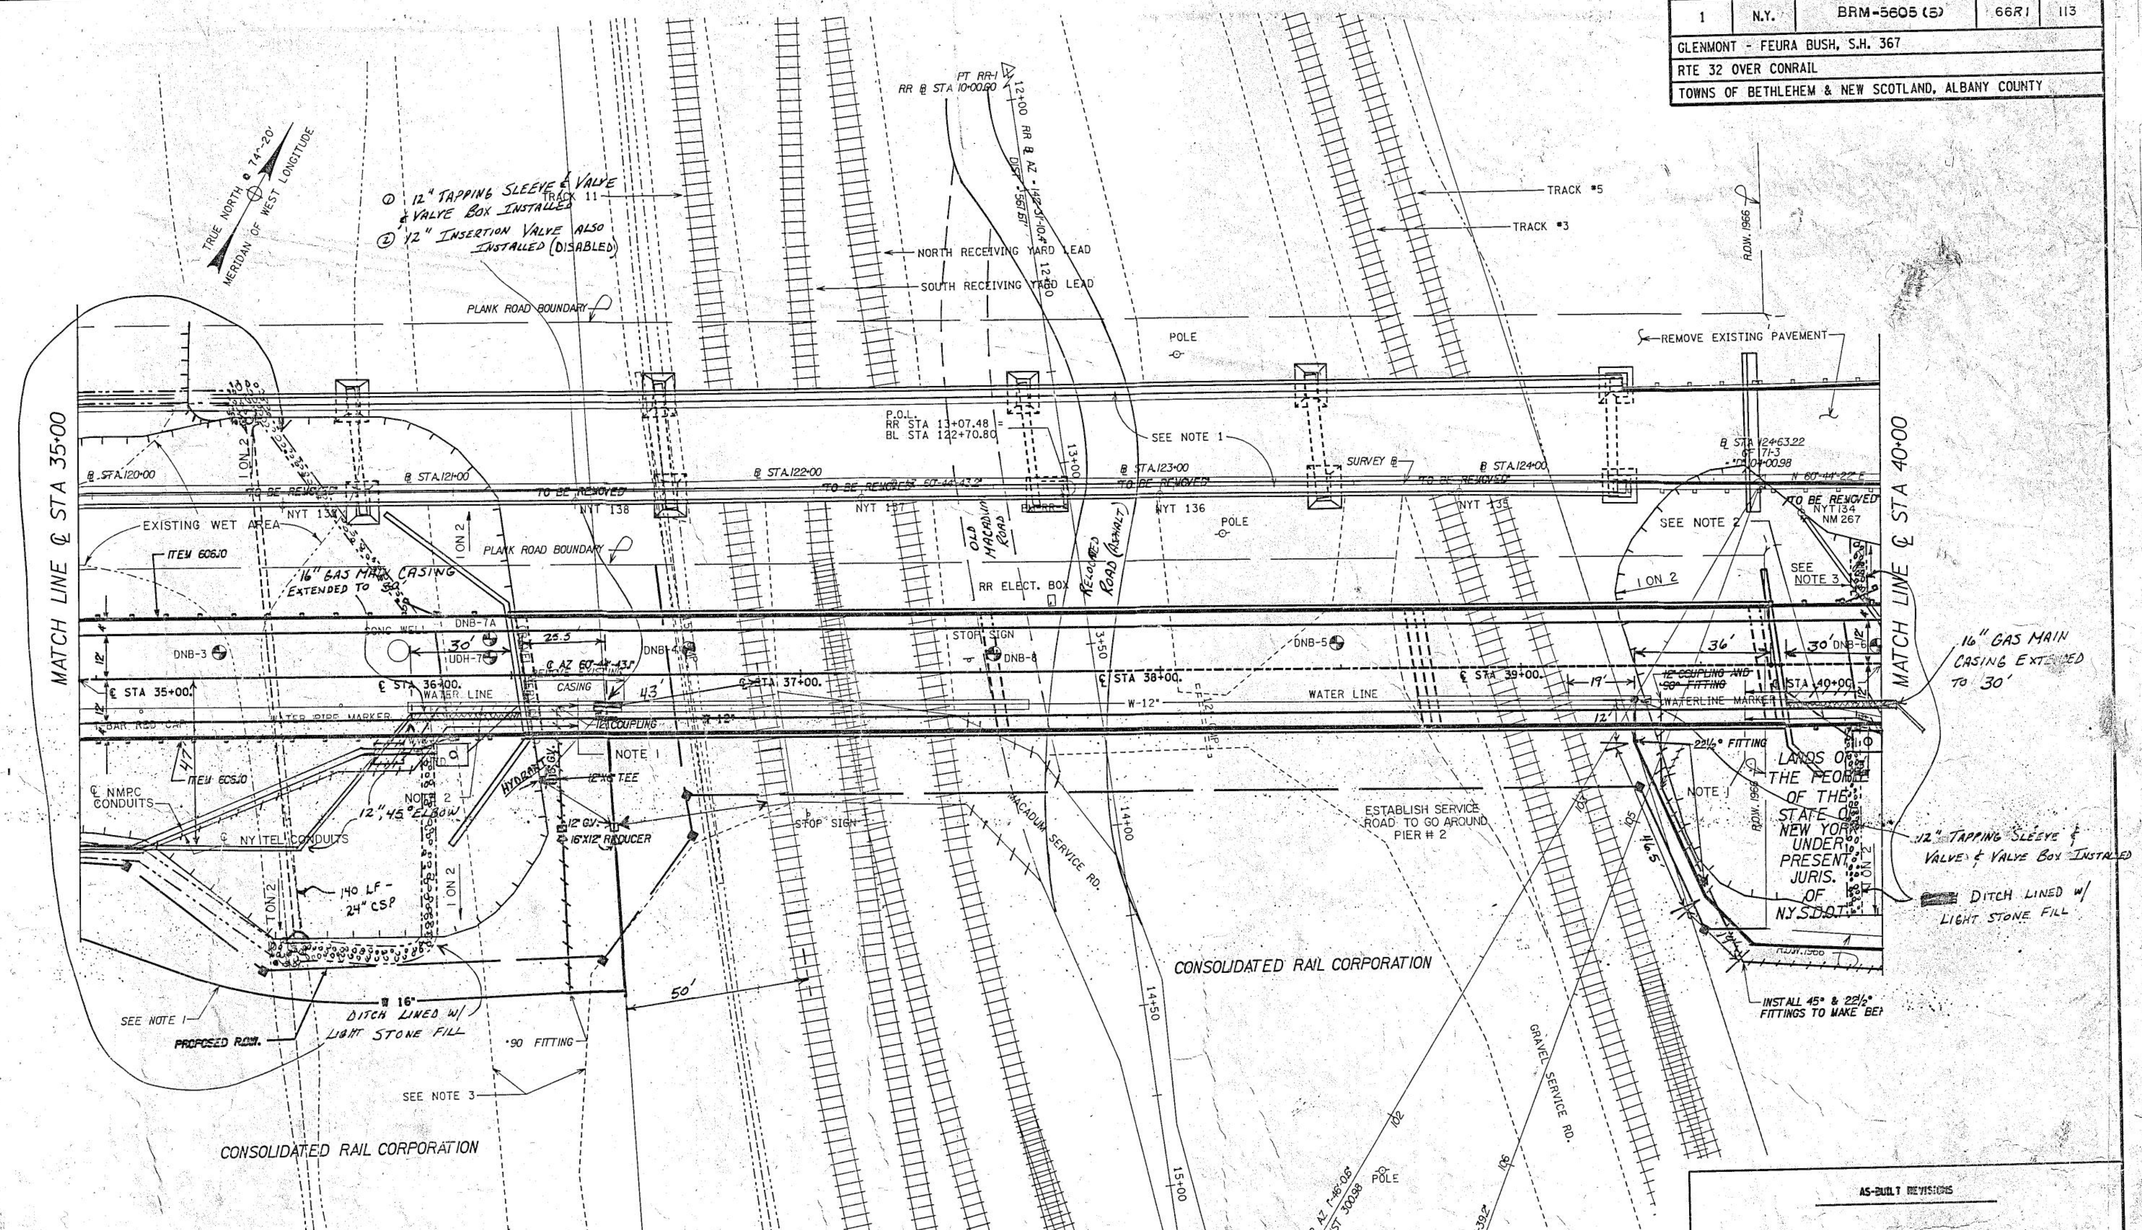

NOTES:

1. SEE BRIDGE PLANS FOR CONDUIT INSTALLATION ON STRUCTURE.
2. SEE UTILITY DETAILS (DWG UD-1) FOR CONDUIT INSTALLATION OFF STRUCTURE AND MANHOLE DETAILS.
3. A CAST IRON PIPE WILL BE INSTALLED BETWEEN THE PROPOSED UTILITY POLE AND EXISTING POLE NYT 134, TO MAINTAIN UTILITIES (NYT) ON A TEMPORARY BASIS. PIPE WILL BE INSTALLED AND WILL BE APPROXIMATELY 2' BELOW O.G.

AS-BUILT REVISIONS

SIGNATURE DATE

UTILITY & DRAINAGE PLAN

STATE OF NEW YORK
DEPARTMENT OF TRANSPORTATION

DRAWING NO.	SCALE	DATE	REGION ONE
UDP 7	1" = 20'	3/90	

"B" 110 146020P32

DATE ____ CHECKED BY ____ DRAFTED BY ____ CHECKED BY ____ ESTIMATED BY ____ CHECKED BY ____ DESIGNED BY Daniel S. Olyer IN CHARGE OF Arthur Nordsved