


GENERAL PLAN – BRIDLE PATH
CENTERLINE STATIONING 8+50 – 17+80
SCALE: 1"= 40'

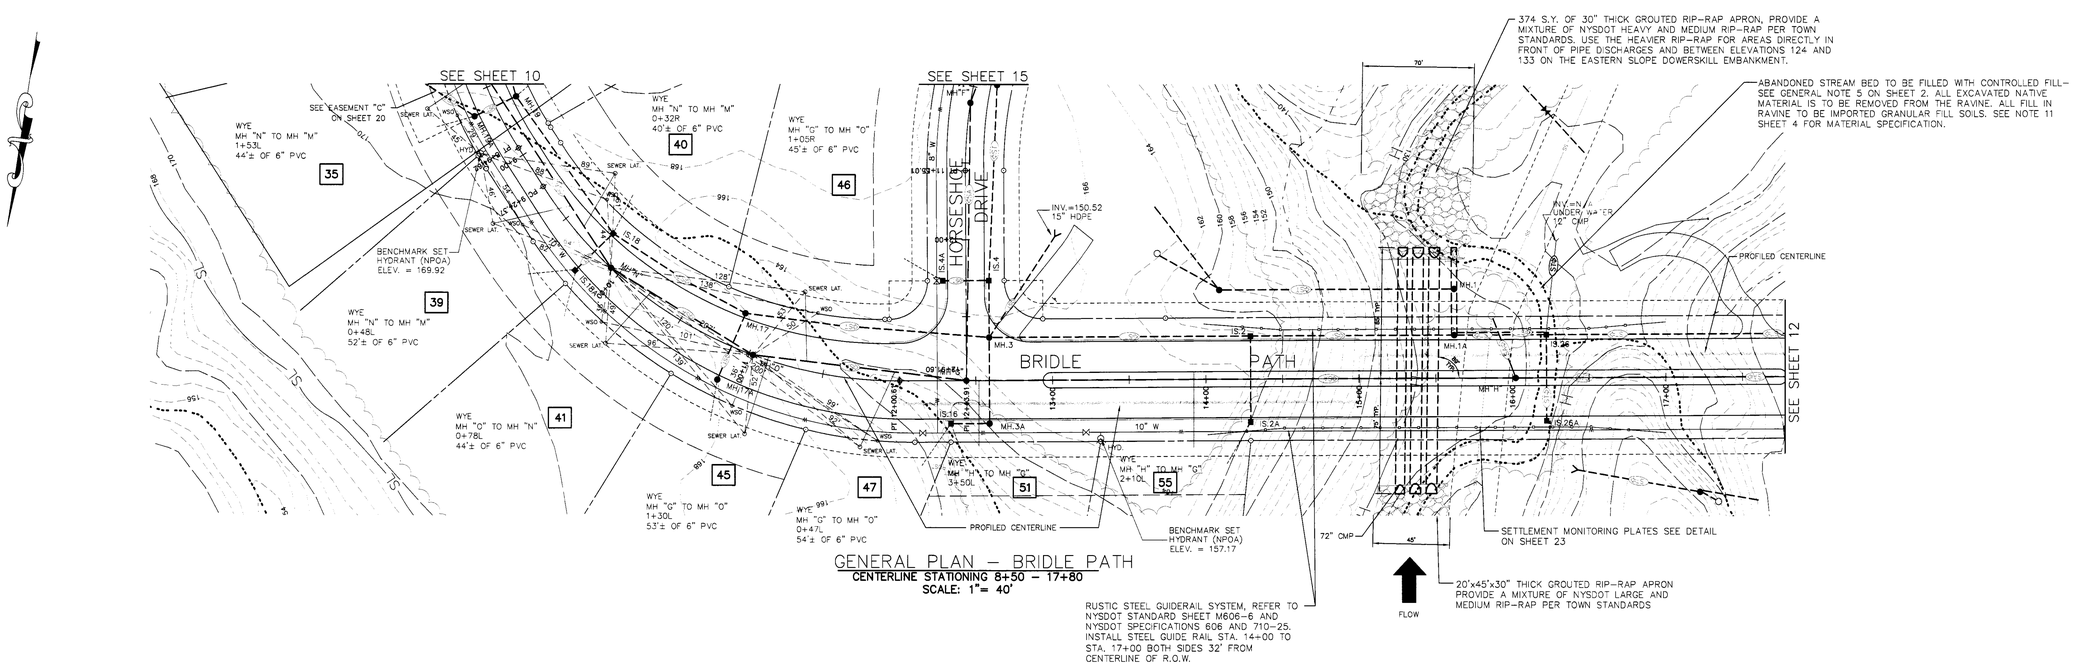


PROFILE – BRIDLE PATH
SCALE: 1"=4' VERT. / 1"=40' HORIZ.

1 2 3 4 5 6 7 8 9 10 11

## GENERAL NOTES

1. CONTRACTOR SHALL COORDINATE FINAL DOWERSKILL CULVERT(S) POSITIONS AND ELEVATIONS WITH TOWN ENGINEER PRIOR TO INSTALLATION.

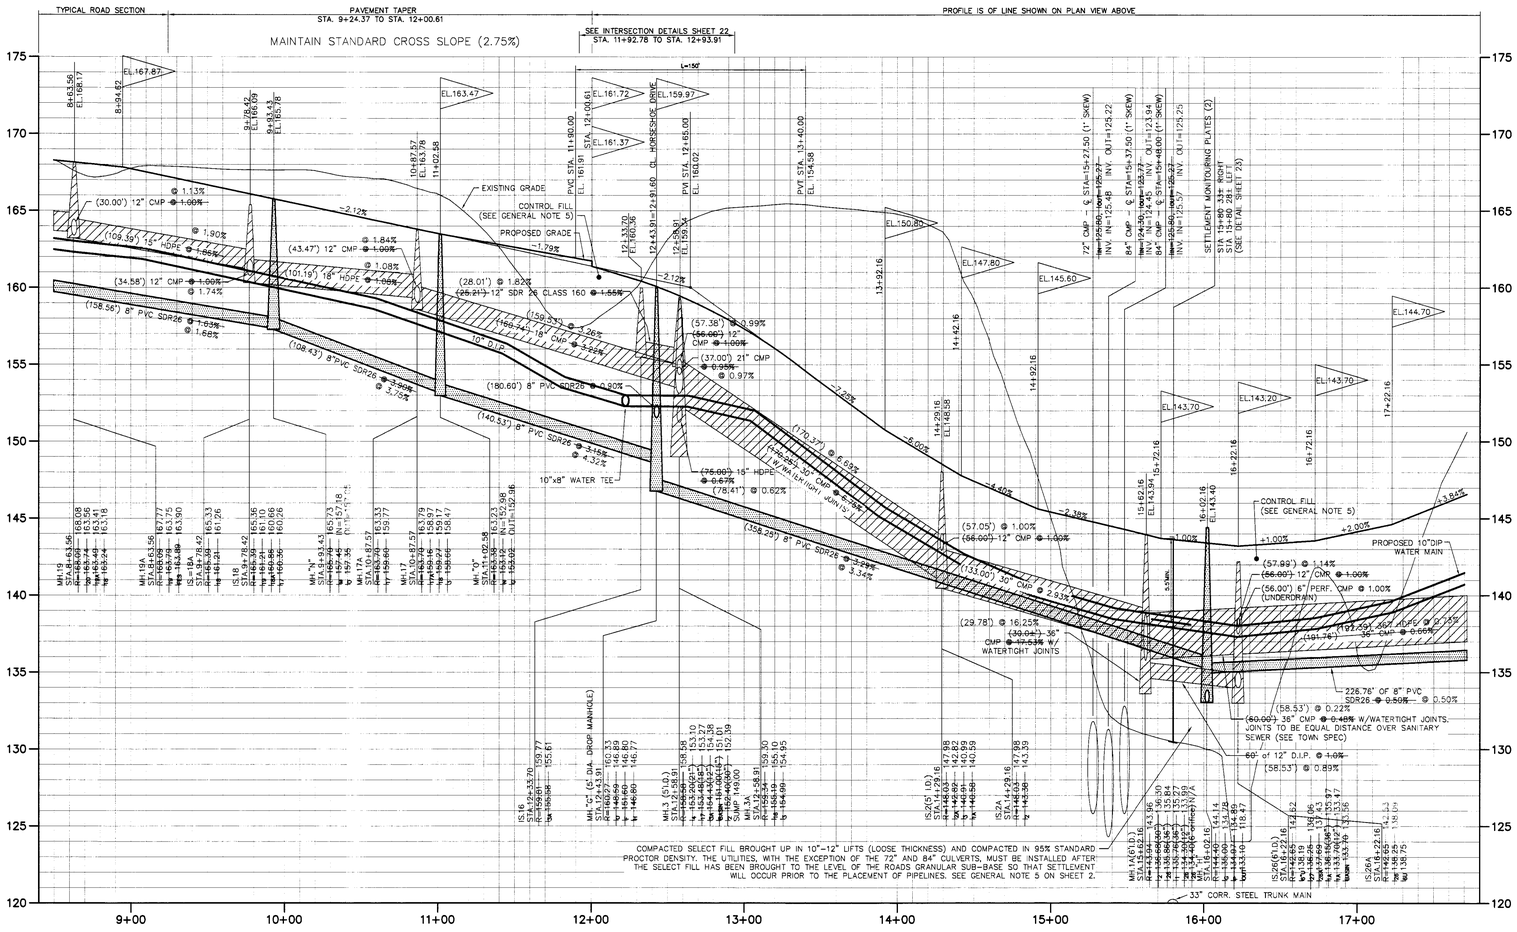UNAUTHORIZED ALTERATIONS OR ADDITIONS TO THIS DOCUMENT IS A VIOLATION OF SECTION 7209 SUBDIVISION 2 OF THE NEW YORK STATE EDUCATION LAW

REVISIONS

| DATE | BY | DESCRIPTION | SYMBOL |
|---|---|---|---|
| 6/99 | CHJ | FINAL PLAN REVISIONS | 1 |
| 10/99 | CHJ | FINAL PLAN REVISIONS | 2 |
| 5/00 | CHJ | FINAL PLAN REVISIONS | 3 |
| 12/00 | CHJ | FINAL PLAN REVISIONS | 4 |
| 1/26/01 | CHJ | FINAL PLAN REVISIONS | 5 |
| 7/01 | CHJ | ACHO REVISIONS | 6 |
| 10/04 | CHJ | FINAL PLAN REVISIONS | 7 |
| 1/06 | CHJ | MISCELLANEOUS | 8 |
| 3/06 | CHJ | MISCELLANEOUS | 9 |
| 4/06 | CHJ | MISCELLANEOUS REVISIONS | 10 |
| 6/28/06 | CHJ | REVISED PER TOWN COMMENTS | 11 |

EDWARD W. BOUTELLE AND SON
CIVIL ENGINEERS AND SURVEYORS
423 KENWOOD AVENUE
DELMAR, NEW YORK
TEL. 518) 439-9981 FAX.(518) 439-9982
A DIVISION OF J. KENNETH FRASER AND ASSOCIATES, PE, LS, LA, P.C.

**FINAL PLAN AMENDED**

# CARRIAGE HILL SUBDIVISION

**MAP OF LANDS OF**

CHARLEW CONSTRUCTION CORP.

TOWN OF BETHLEHEM COUNTY OF ALBANY
STATE OF NEW YORK

SCALE: AS NOTED

PROJ. SURVEYOR: CHJ
DRAWN BY: TWK
ASSEMBLED BY: TWK
CHECKED BY: CHJ

PROJECT NO.: 99-020
CAD FILE NAME: 4103-011

SHEET TITLE:
PLAN & PROFILE
BRIDLE PATH STA. 8+50 – 17+80

DATE NOVEMBER 1995

SHEET 11 OF 31

RECORD DRAWING

ALL INFORMATION SHOWN IN RED ON THESE DRAWINGS REPRESENT RECORD INFORMATION OBTAINED BY THE FIELD CREWS OF C.T. MALE ASSOCIATES, P.C. DURING THE MONTH OF DECEMBER 2006. ADDITIONAL FIELD LOCATIONS OBTAINED IN MARCH 2007 AND OCTOBER 2008.

0 INCHES 1 2
4561 TOWN OF BETHLEHEM

COPYRIGHT 1999 J. KENNETH FRASER AND ASSOCIATES, P.C.