


FED. ROAD REG. NO.	STATE	FEDERAL AID PROJECT NO.	SHEET NO.	TOTAL SHEETS
I	N.Y.			
GLENMONT - FEURA BUSH				
S.H. NO. 367				
ALBANY COUNTY, P.I.N. 1460.20				

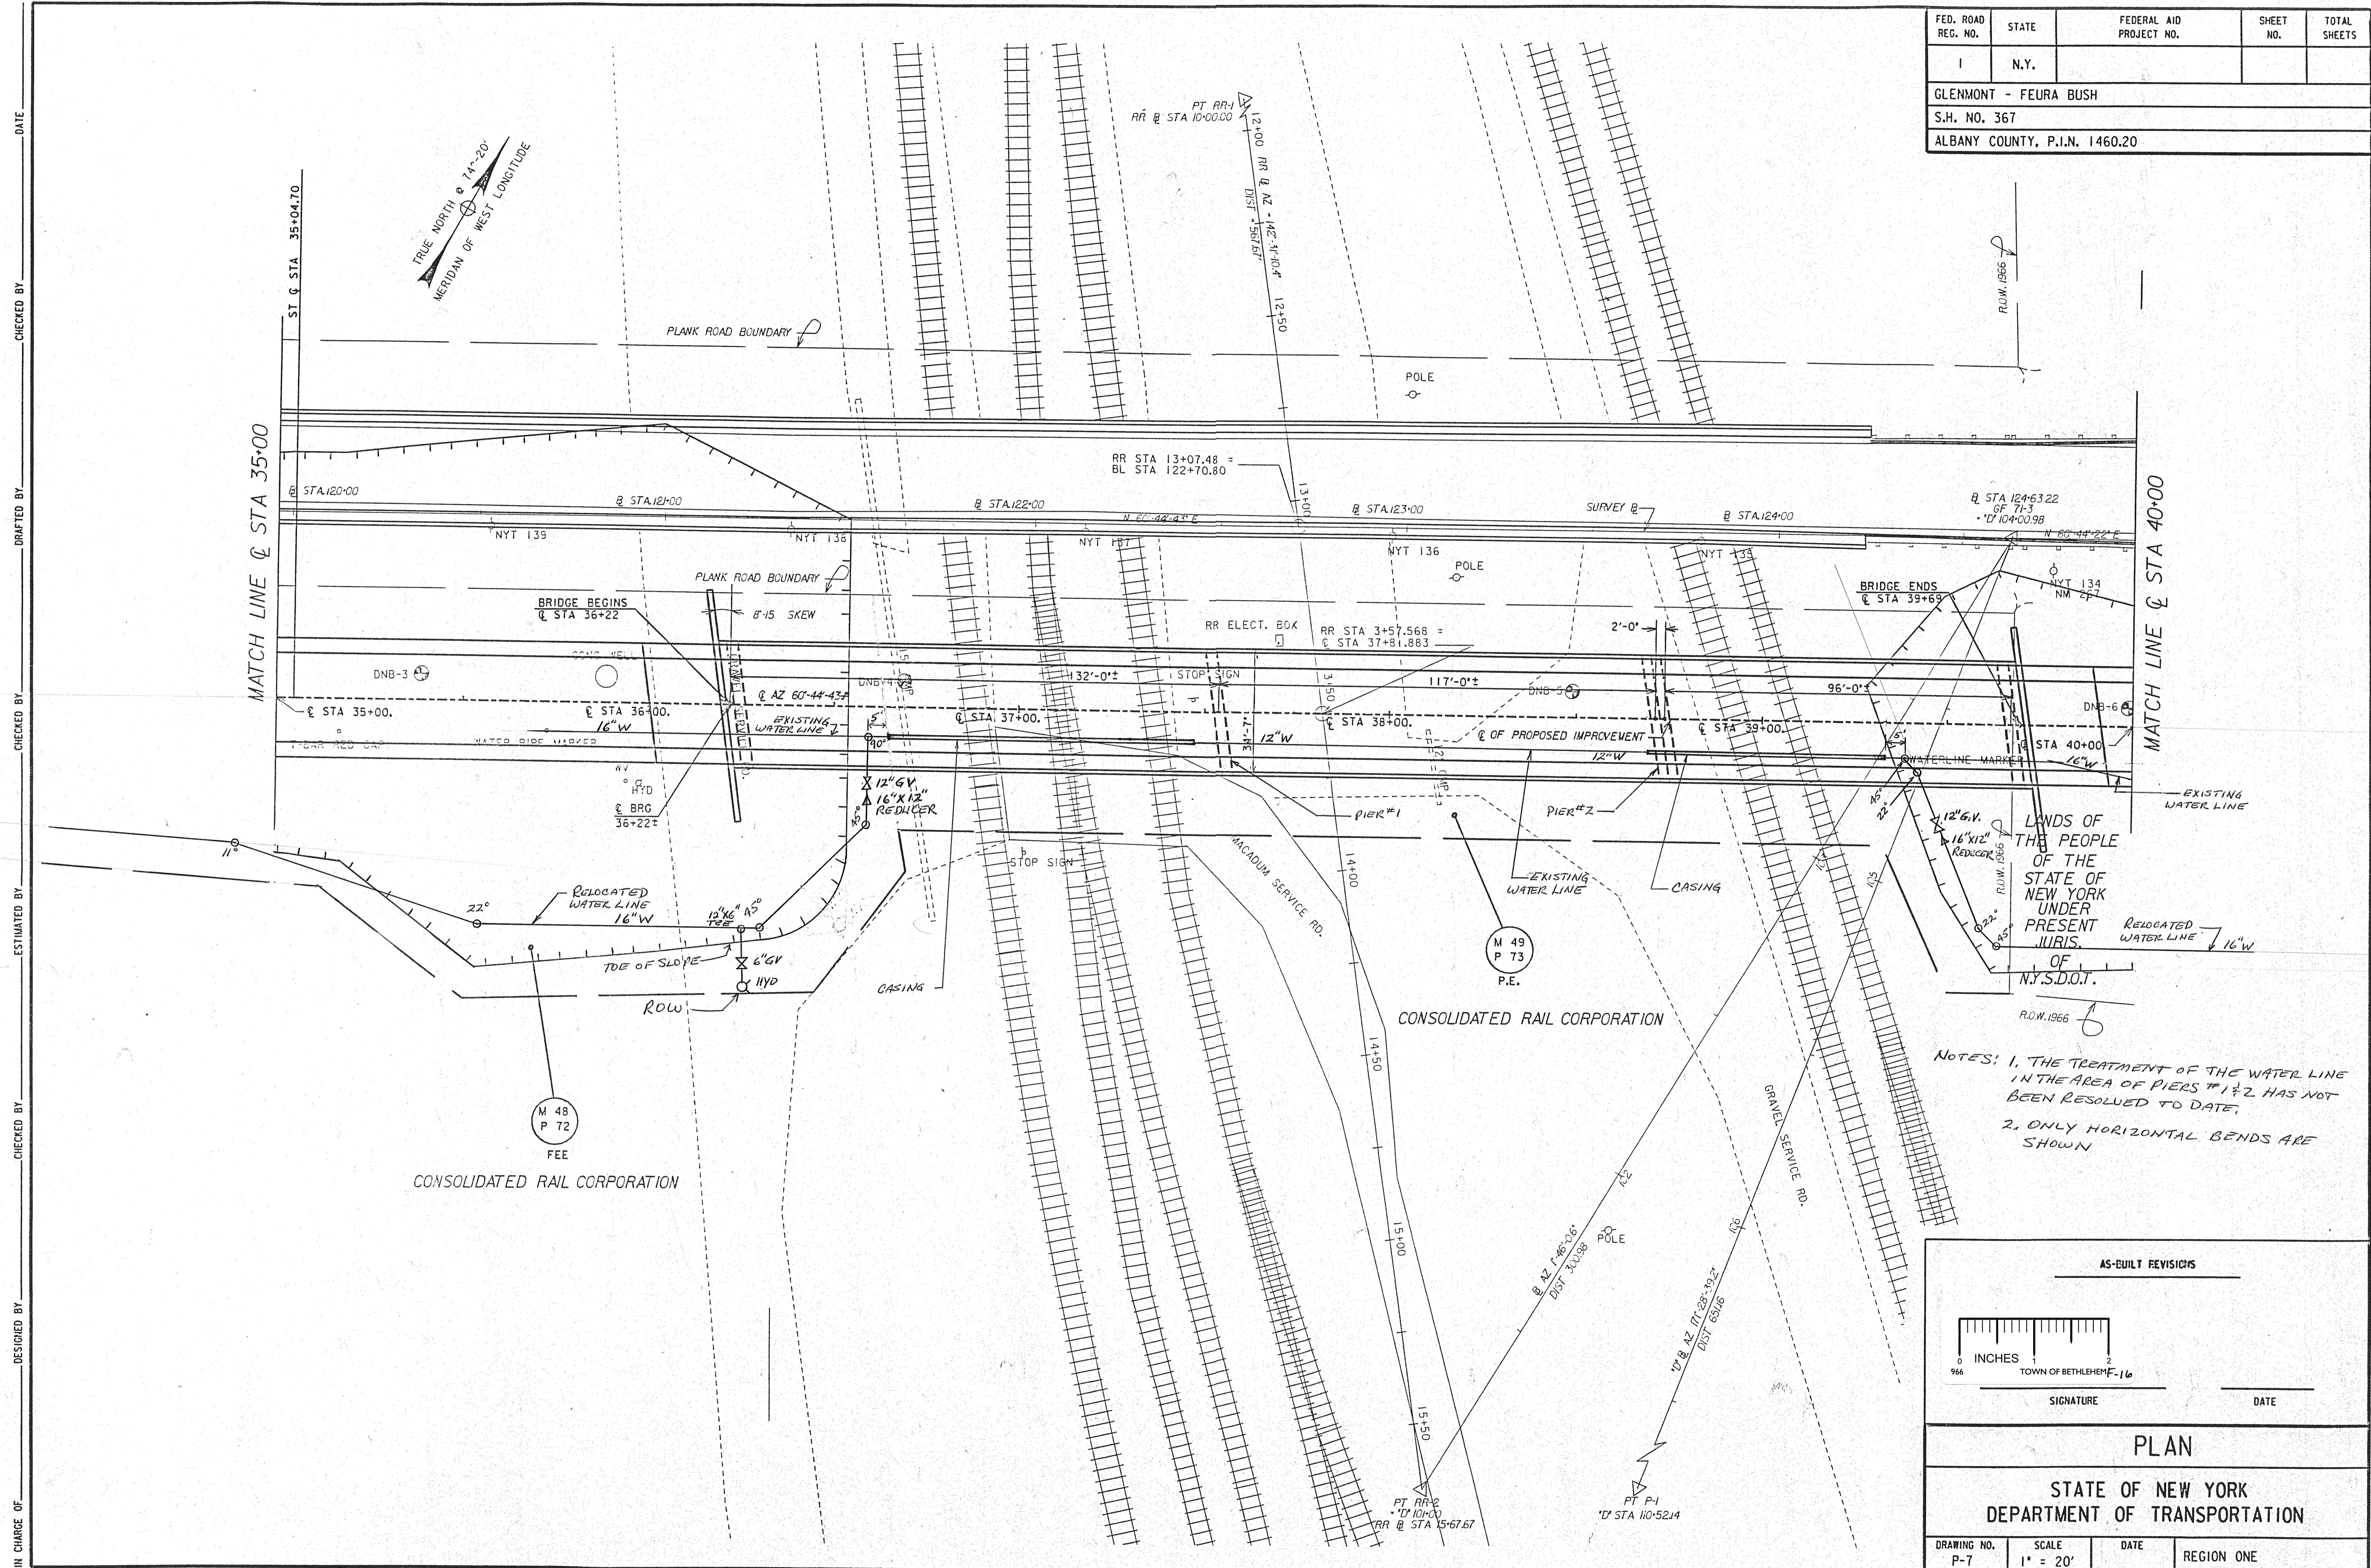

IN CHARGE OF _____ DESIGNED BY _____ CHECKED BY _____ ESTIMATED BY _____ DRAFTED BY _____ CHECKED BY _____ DATE _____

NOTES: 1. THE TREATMENT OF THE WATER LINE IN THE AREA OF PIERS #1 & 2 HAS NOT BEEN RESOLVED TO DATE.
 2. ONLY HORIZONTAL BENDS ARE SHOWN

AS-BUILT REVISIONS

0 1 2
 INCHES
 TOWN OF BETHLEHEM F-16

SIGNATURE _____ DATE _____

PLAN

STATE OF NEW YORK
DEPARTMENT OF TRANSPORTATION

DRAWING NO. P-7	SCALE 1" = 20'	DATE	REGION ONE
--------------------	-------------------	------	------------