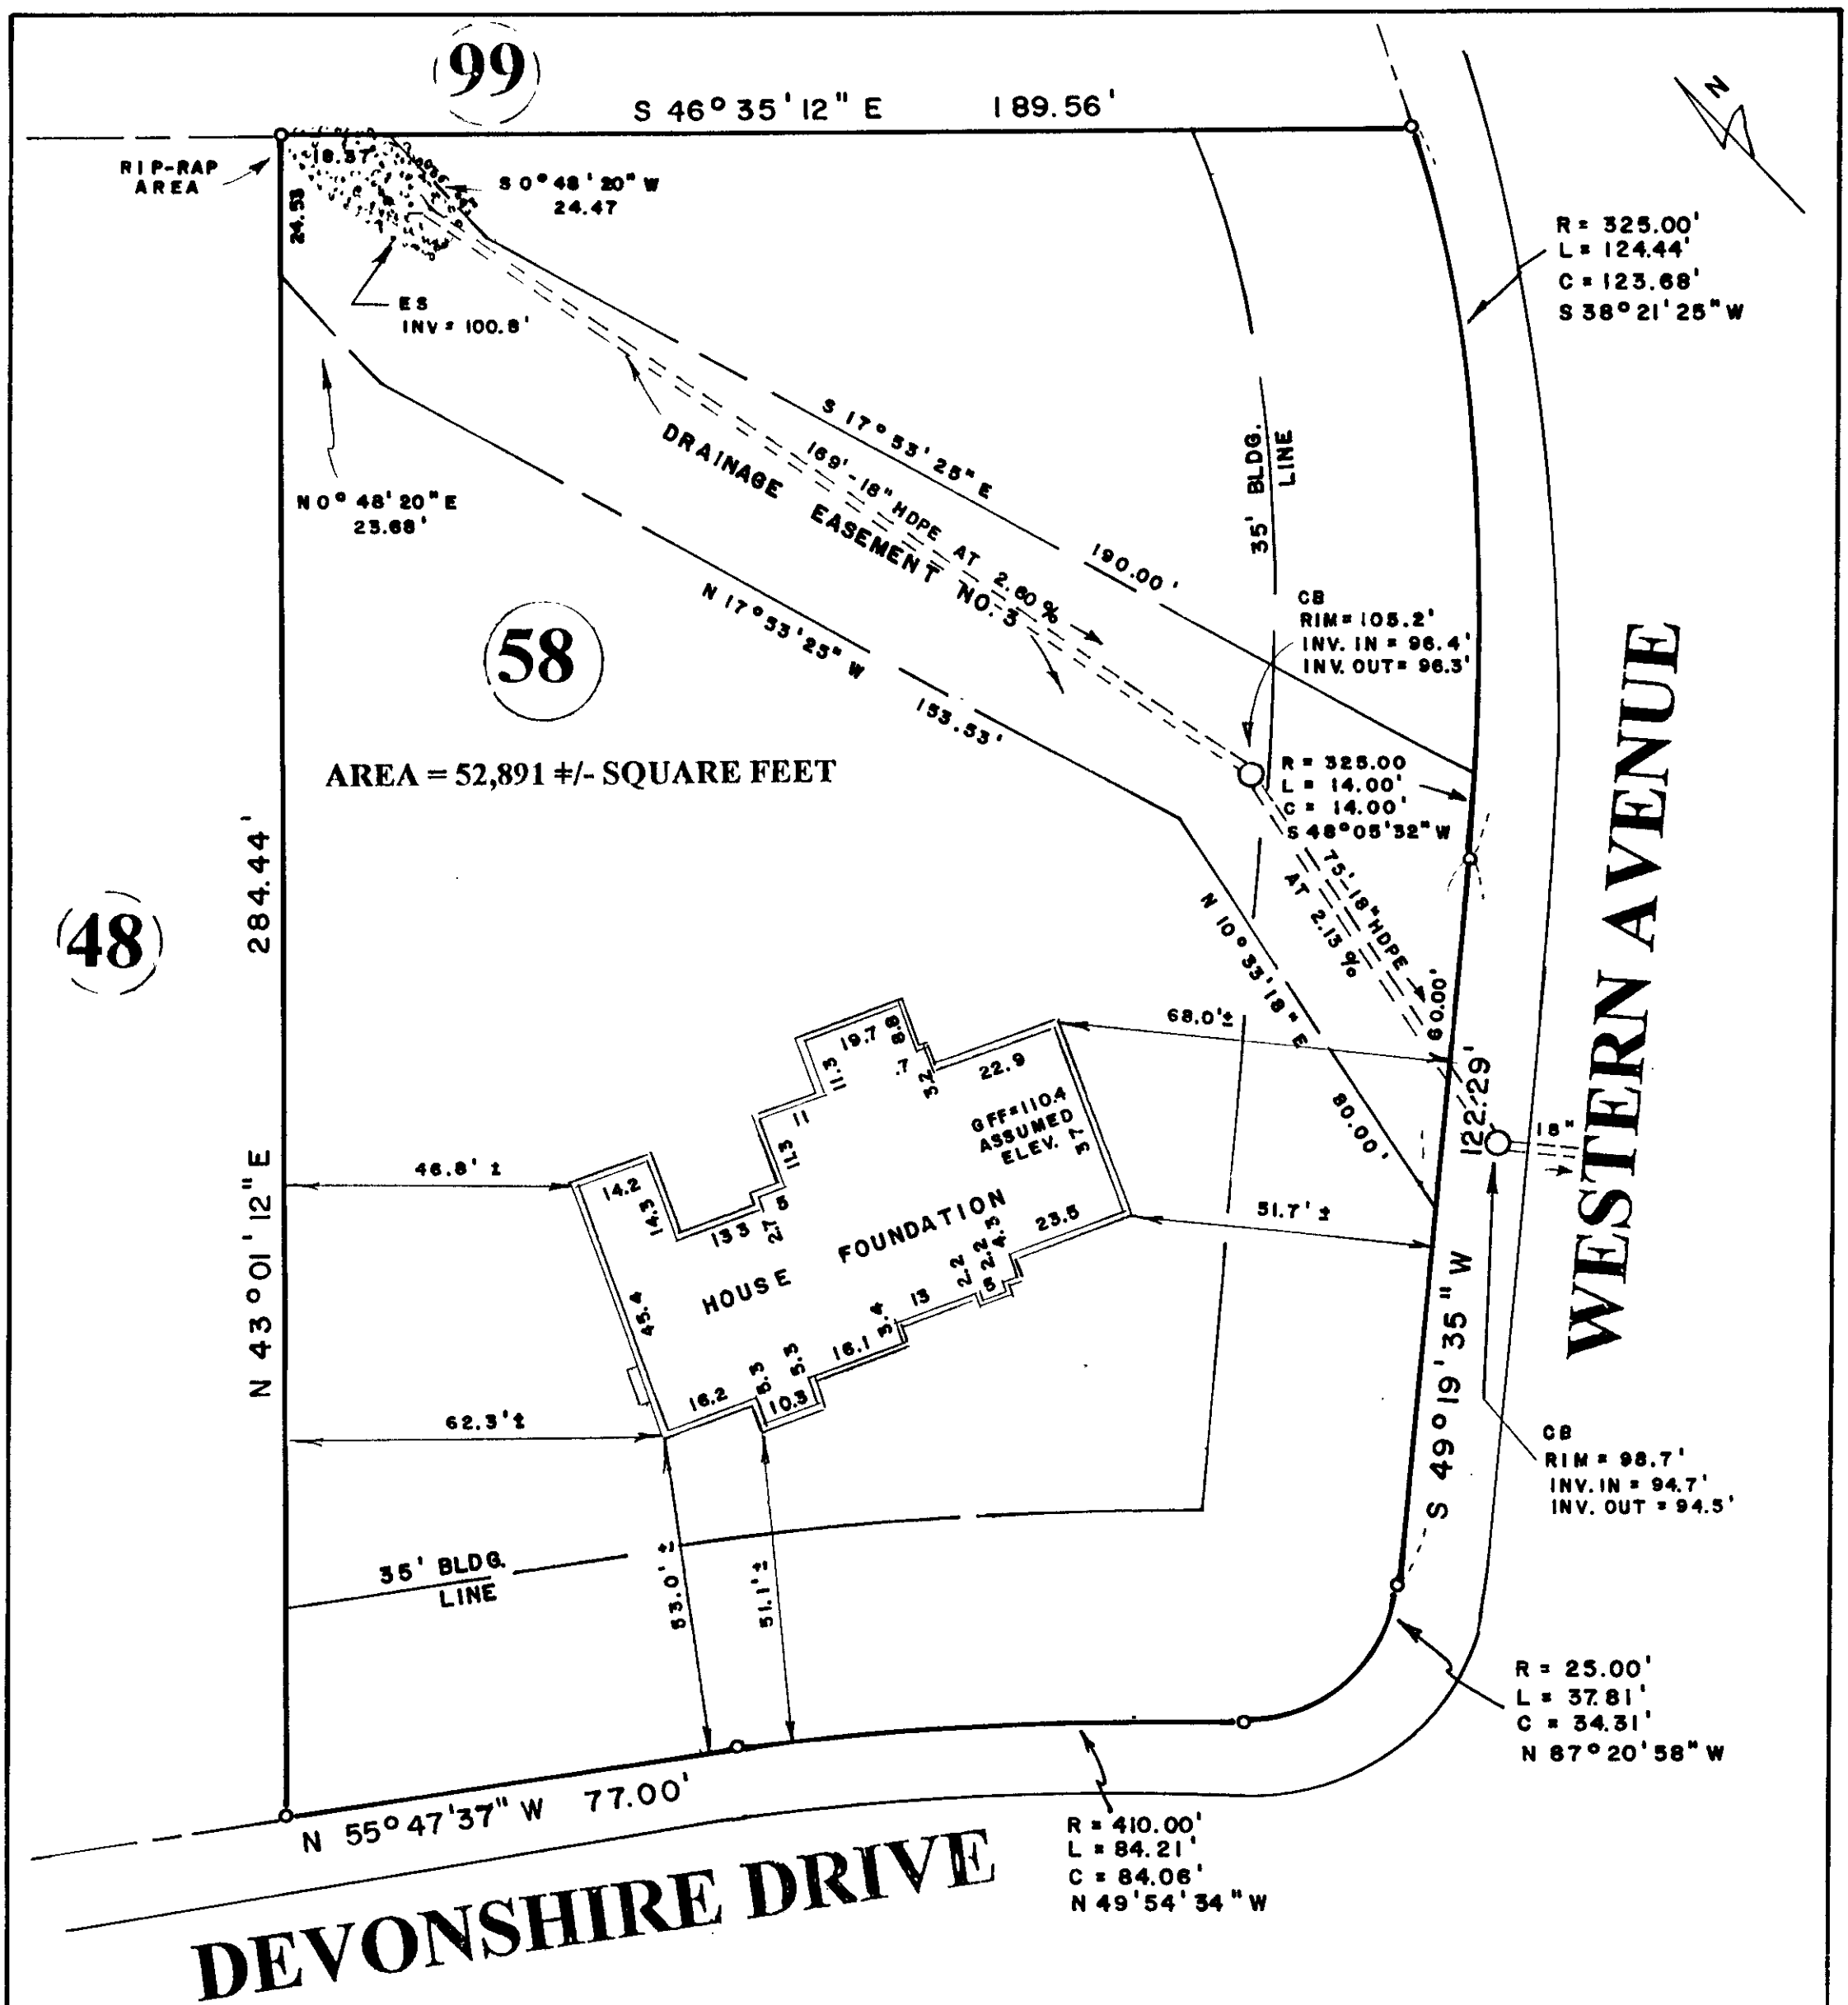

REFERENCE MAP:
"SUBDIVISION DEVONSHIRE HILLS", DATED MARCH 9, 1989 BY C.T. MALE ASSOCIATES, P.C. AND FILED AT THE ALBANY COUNTY CLERKS OFFICE AUGUST 22, 1991 IN DRAWER NO. 172 AS MAP NO. 9417.

STATE OF NEW YORK · R. J. SCARANO

ROBERT J. SCARANO P.L.S. 49,321

6/4/04

NO.	REVISION	BY
1	FOUNDATION LOCATION 6/23/03	RJS
2	STORM SEWER ASBUILTS 6/2/04	RJS

SURVEY AND MAP
LOT NO. 58
DEVONSHIRE DRIVE
DEVONSHIRE HILLS

TOWN OF BETHLEHEM	ALBANY COUNTY, NEW YORK
DATE: MAY 19, 2003	SCALE: 1" = 40'

DR. BY: T.A.E.
CK. BY: R.J.S.

ROBERT J. SCARANO
Consulting Civil Engineer
4 Cheshire Way
Loudonville, New York 12211