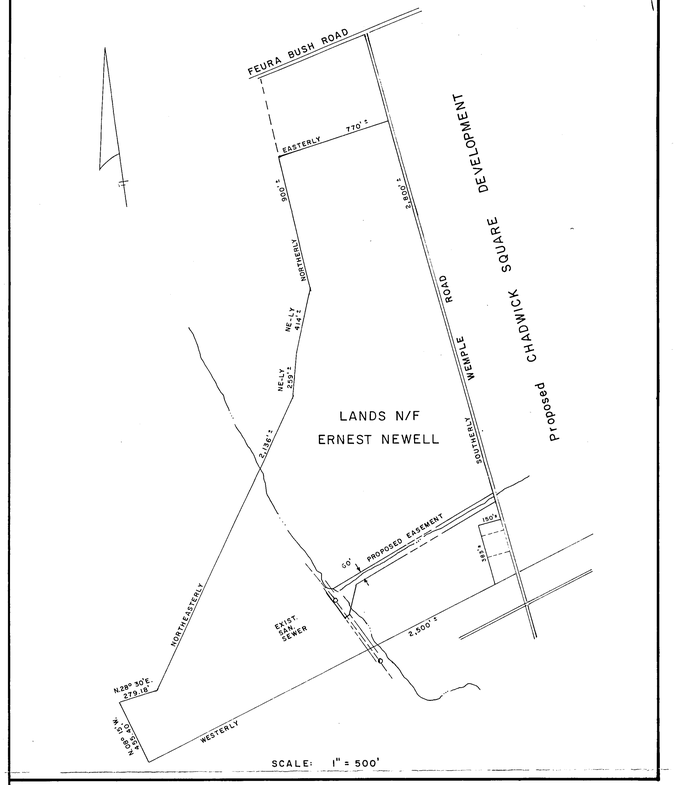

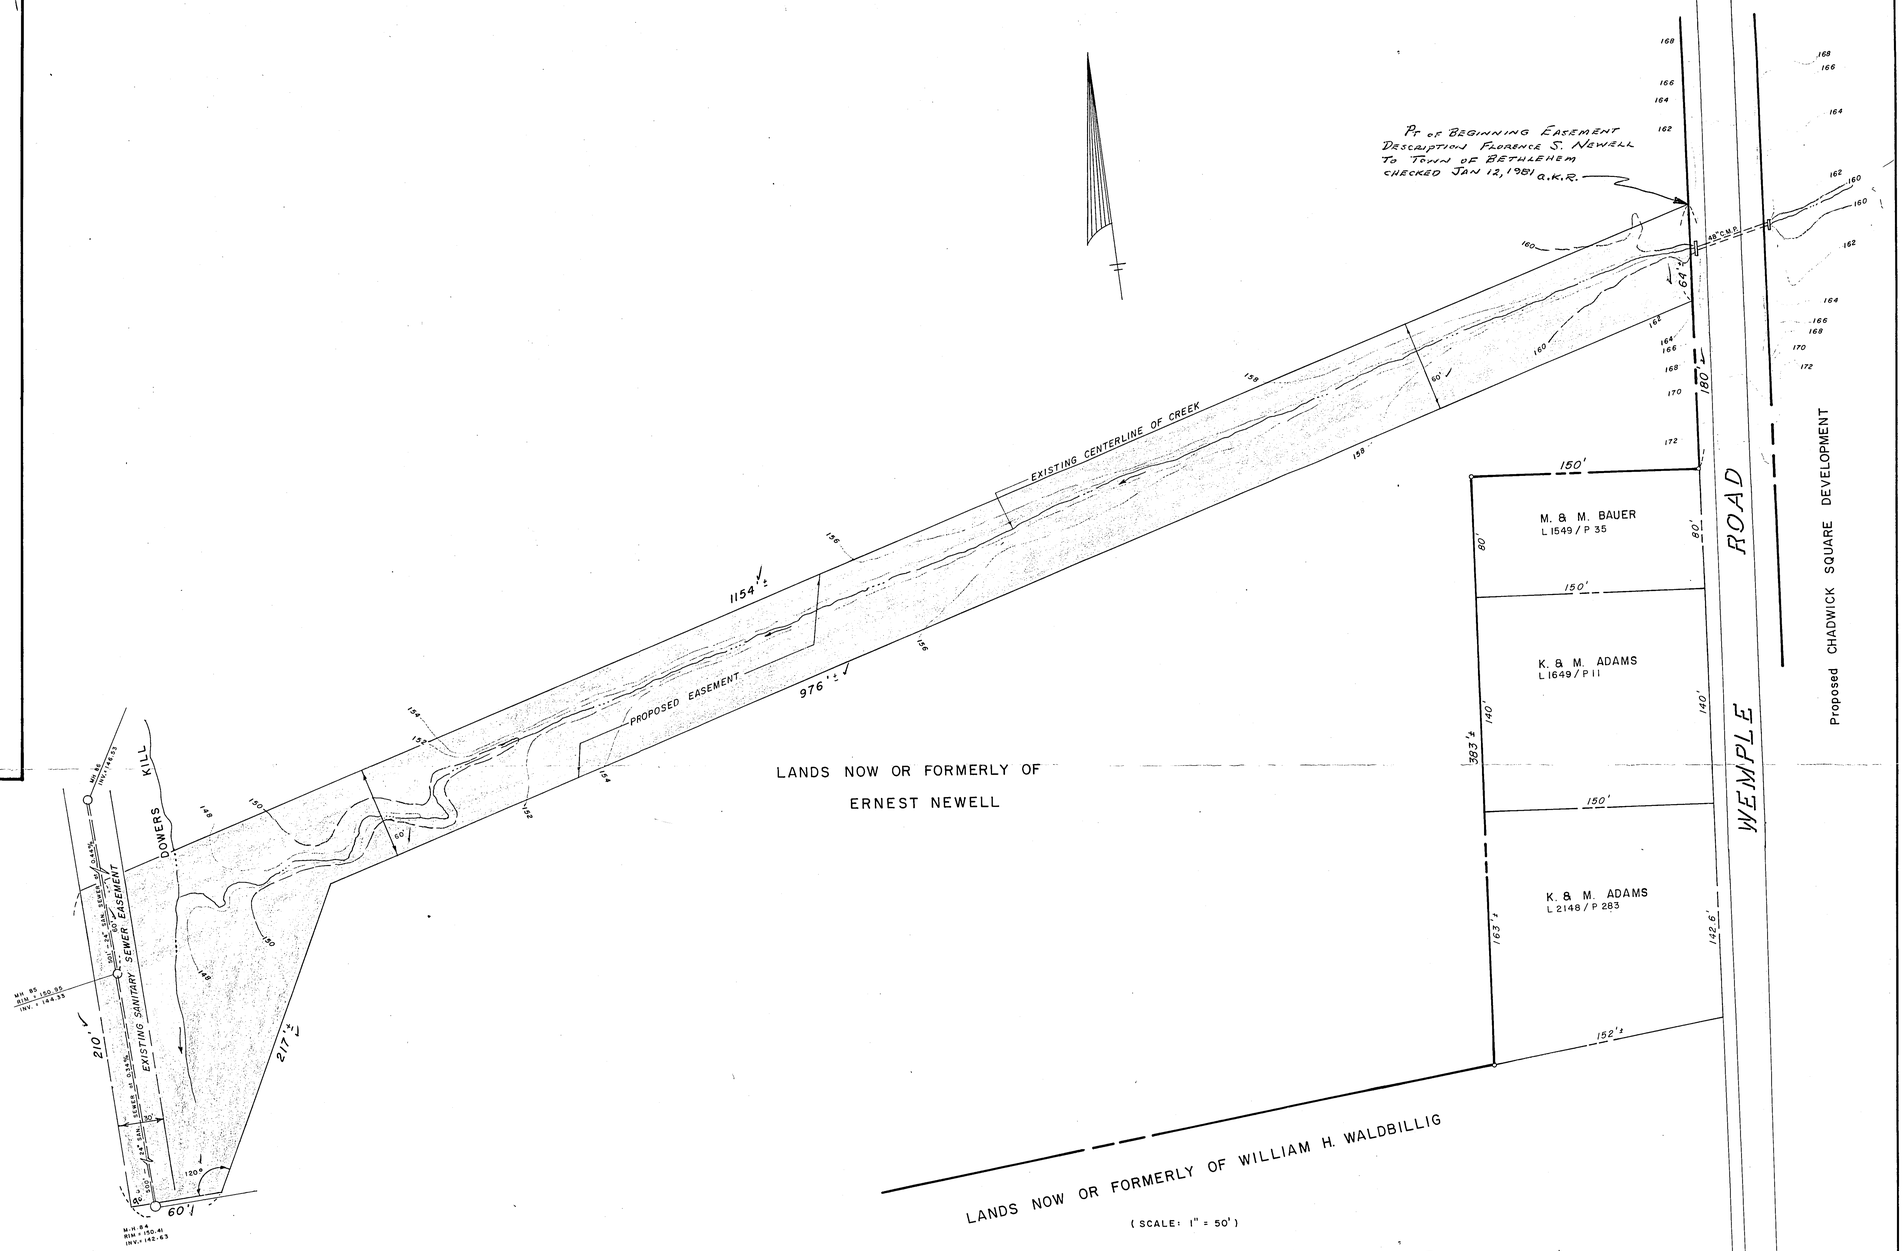

NOTE:

1. PROPERTY LINE INFORMATION USED TO PREPARE THIS MAP TAKEN FROM A MAP ENTITLED "DEED PLOTTINGS: PARCELS OF NEWELL, MAGEE, YOUNG FOR GLENMONT DEVELOPMENT CORP. [AREA SOUTH OF FEURA BUSH ROAD]" DATED JUNE 23, 1965 PREPARED BY C. T. MALE ASSOCIATES.
2. THIS MAP IS TO REPLACE A MAP ENTITLED "MAP OF A PORTION OF LANDS NOW OR FORMERLY OF ERNEST NEWELL SHOWING PROPOSED EASEMENT FOR STORM DRAINAGE & SANITARY SEWER", DATED OCTOBER 29, 1975, PREPARED BY C. T. MALE ASSOCIATES, P.C. AND FILED IN THE ALBANY COUNTY CLERK'S OFFICE AS MAP NO. 5234 IN DWR. NO. 168.

INCHES 0 1 2
3305 TOWN OF BETHLEHEM 5-02

FINAL REVISED LOCATION OF EASEMENT ACROSS NEWELL PROPERTY - WEST OF WEMPLE ROAD
CHKD JAN 12, 1981 Q.K.R.

UNAUTHORIZED ALTERATION OR ADDITION TO THIS DOCUMENT IS A VIOLATION OF SECTION 7209 SUBDIVISION 2 OF THE NEW YORK STATE EDUCATION LAW.

John G. Gay

DATE	RECORD OF WORK	Drawn	Check	Appr.
5-13-80	TIE DISTANCE CORRECTED	VAB	DJB	JGG

DRAWN BY VAB | CHECKED BY DJB

REVISED MAP OF A PORTION OF LANDS NOW OR FORMERLY OF
ERNEST NEWELL
SHOWING PROPOSED EASEMENT FOR STORM DRAINAGE & SANITARY SEWER

TOWN OF BETHLEHEM | COUNTY OF ALBANY
SCALE AS SHOWN | DATE MAY 13, 1980

C.T. MALE ASSOCIATES, P.C.
3000 TROY ROAD, SCHENECTADY, N.Y. 12309
PROFESSIONAL ENGINEERS LAND SURVEYORS LAND PLANNING CONSULTANTS

APPROVED BY JOHN G. GAY | LIC. NO. 41,014 | DWG NO. 80 - 163

PROJECT NO. 01 03 0045

Rec'd JUNE 12, 1980