\\buffalo_fs1\ALT\buffalo\projects\6613\31541\DWGS\PIPELINE\31541-100 THRU 118.dwg

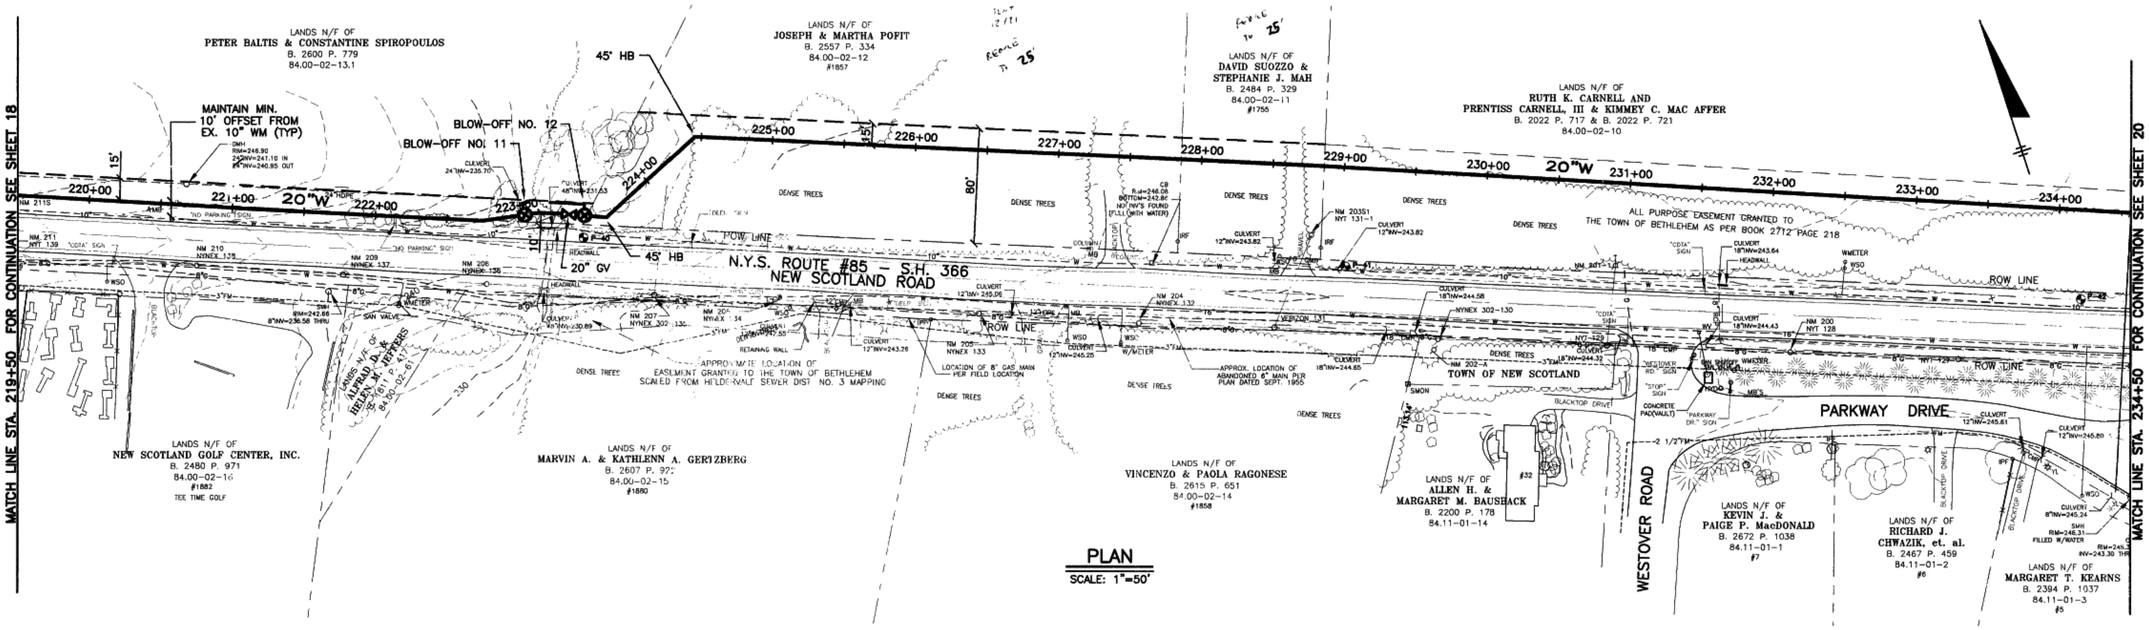

PLAN

SCALE: 1"=50'

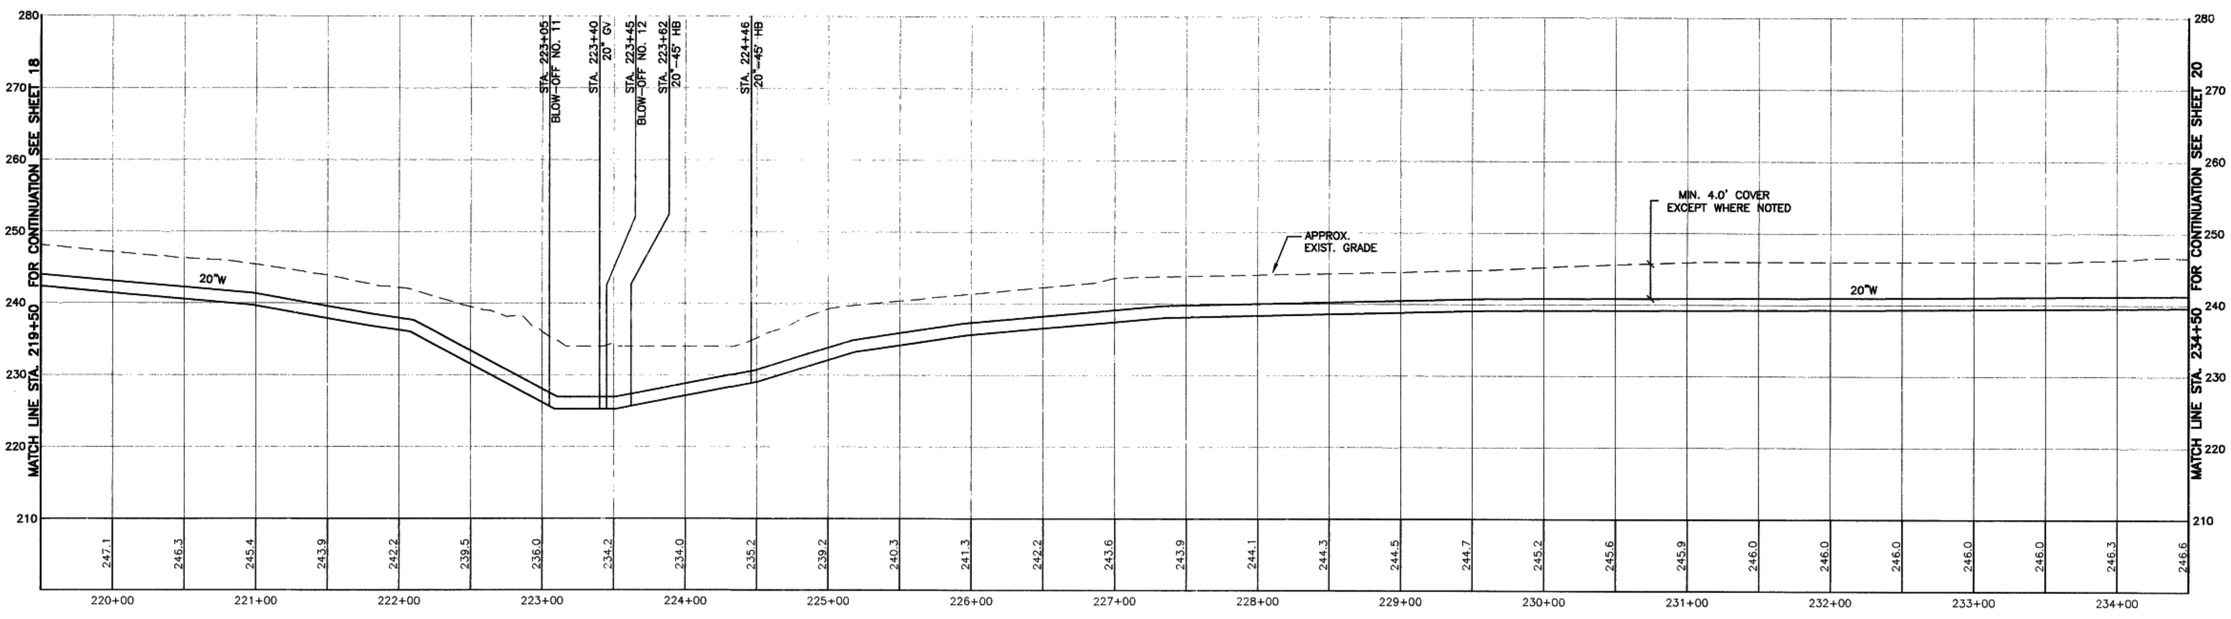

PROFILE

SCALE: (HORIZ.) 1"=50'
(VERT.) 1"=10'

IT IS A VIOLATION OF LAW FOR ANY PERSON, UNLESS ACTING UNDER THE DIRECTION OF A

THIS DRAWING WAS PREPARED AT THE SCALE INDICATED IN THE TITLE BLOCK. INACCURACIES IN THE STATED SCALE MAY BE INTRODUCED WHEN DRAWINGS