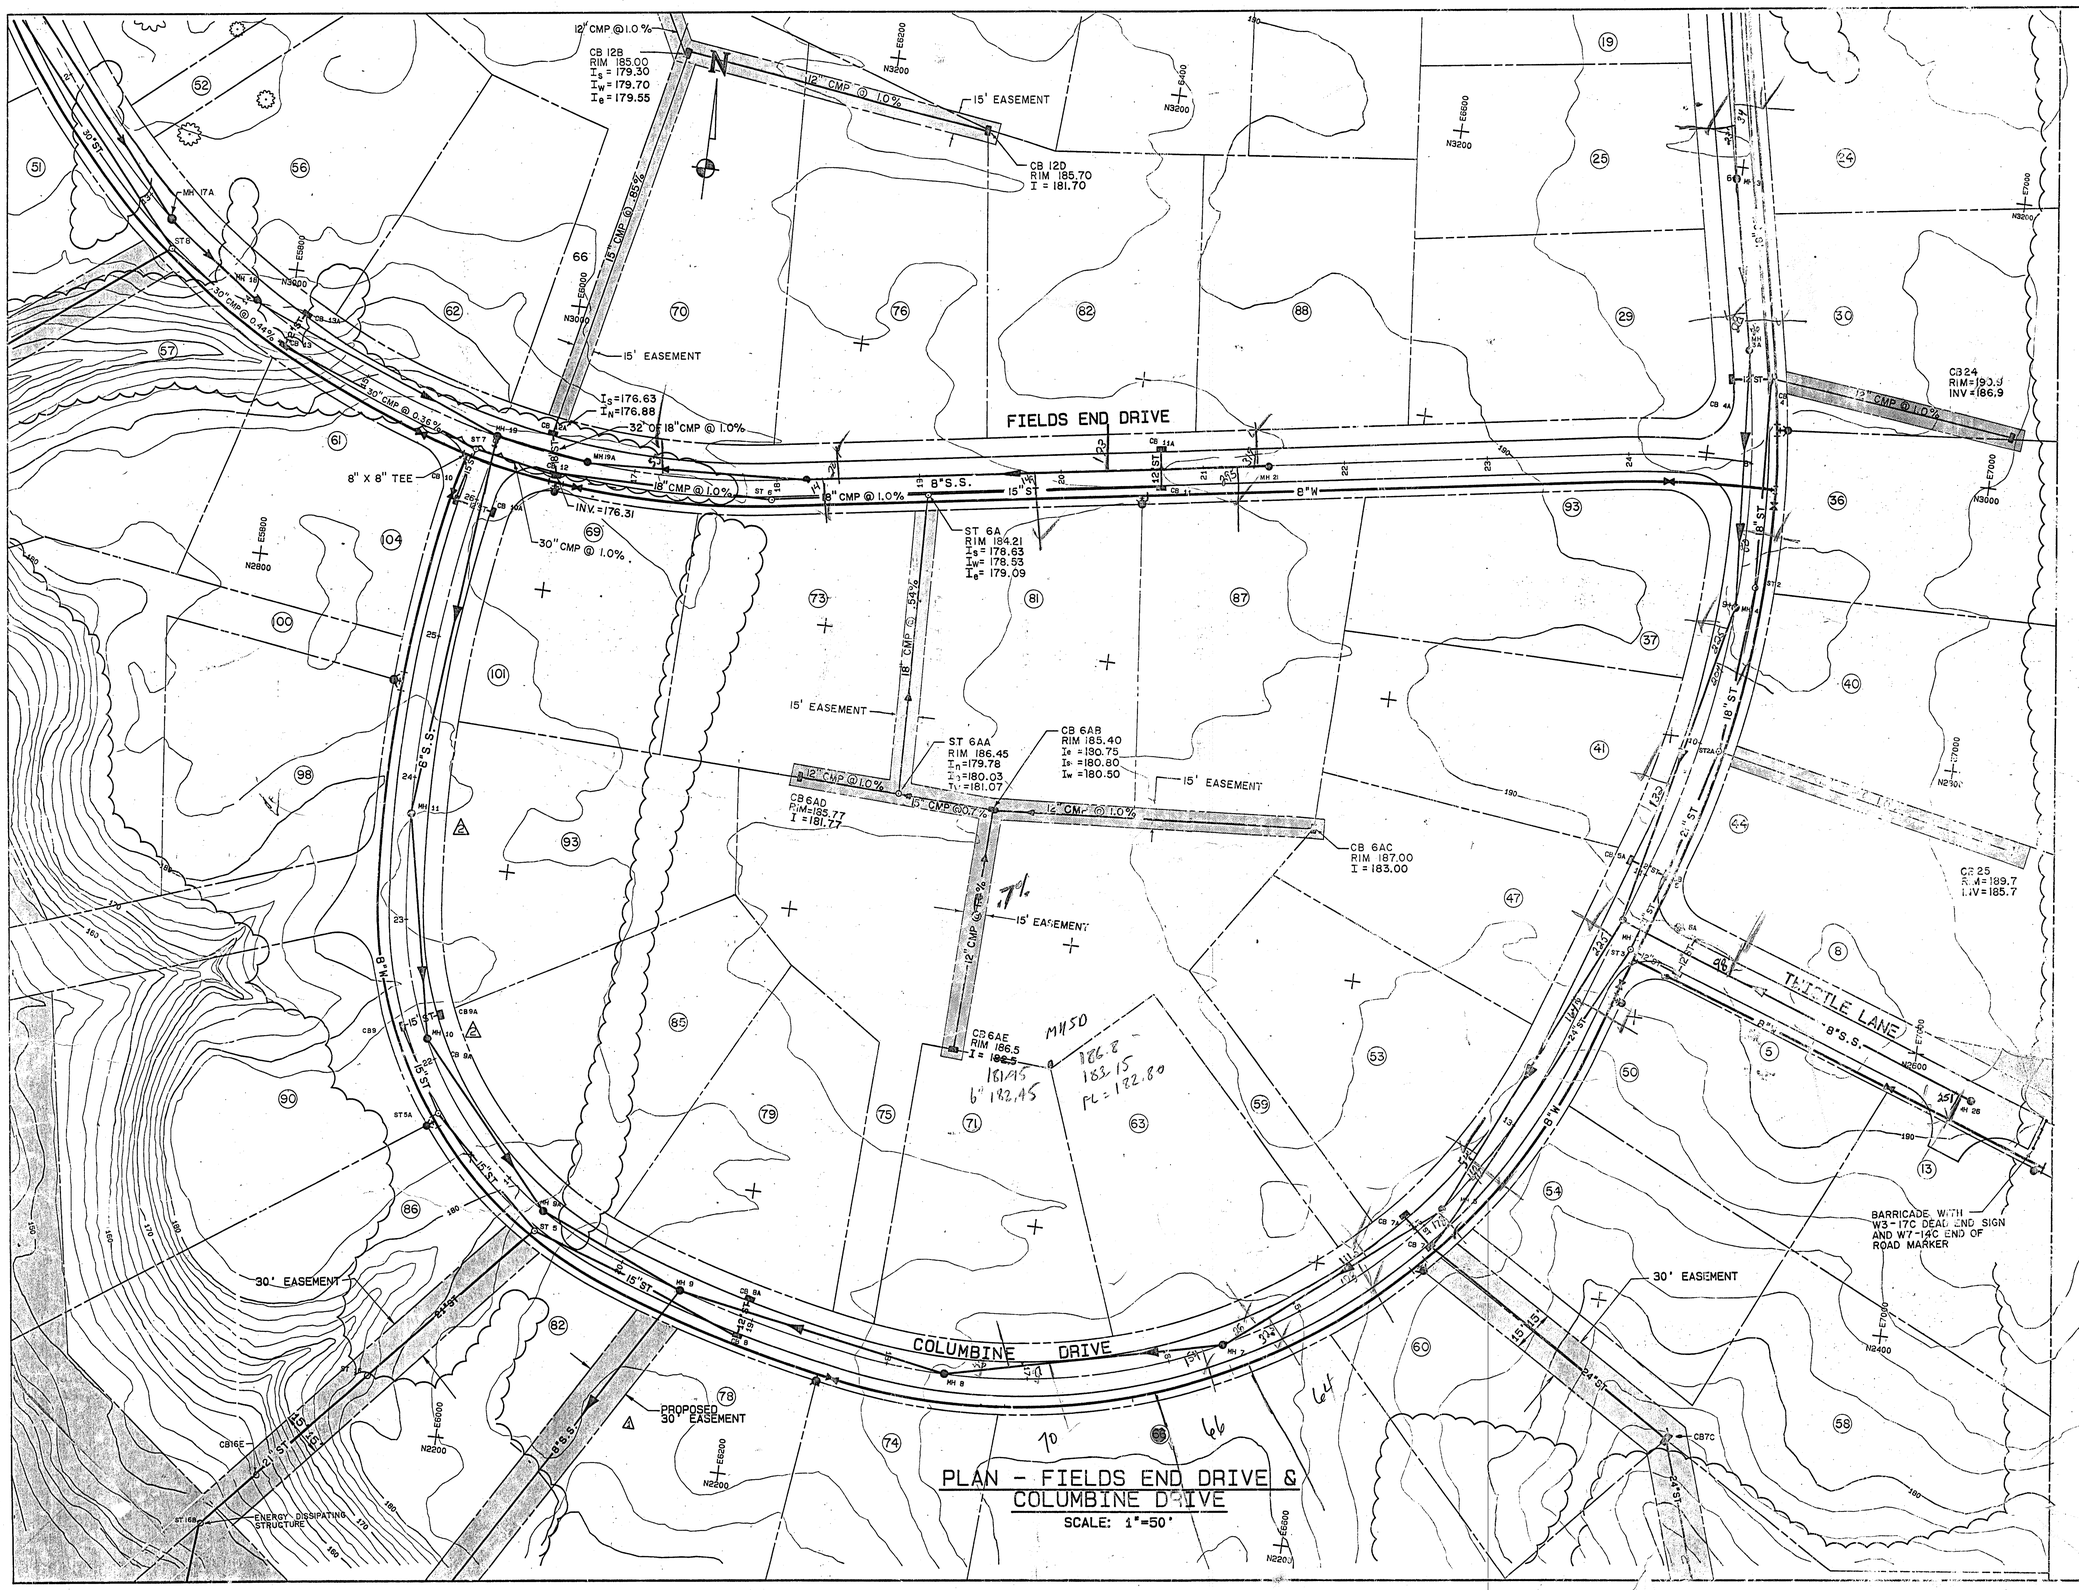

PLAN - FIELDS END DRIVE & COLUMBINE DRIVE

SCALE: 1"=50'

SCALE

0 5 1 2 3

KEY PLAN

NOTES

ALL CONSTRUCTION DISTURBANCES ON STATE OR PRIVATE LAND TO BE RESTORED BY CONTRACTOR

UNAUTHORIZED ALTERATIONS OR ADDITIONS TO THIS DOCUMENT IS A VIOLATION OF SECTION 7209 SUBDIVISION 2 OF THE NEW YORK STATE EDUCATION LAW

REVISIONS

DATE	BY	DESCRIPTION	SYMBOL
6/87	JB	PROPERTY LINE FINAL CORRECTIONS	NONE
8/87	TM	ADDED OFF SITE SEWER AND EASEMENT	1
11/87	JB	MOVED MH 10 AND MH 11	2
12/89	JB	UTILITIES EDITED PER FINAL GRADING	
3/12/90	JB	FINAL REVISIONS	NONE

J. KENNETH FRASER AND ASSOCIATES, P.C

CONSULTING ENGINEERS

RENSSELAER, NEW YORK

R & R ASSOCIATES

THE MEADOWS SUBDIVISION

TOWN OF BETHLEHEM NEW YORK

0 INCHES 1 2

1284 TOWN OF BETHLEHEM W-27

SCALE: AS NOTED

STATE OF NEW YORK — JAMES K. FRASER JR. — LICENSED PROFESSIONAL ENGINEER — 42124

PROJ. ENG'R: JFB

DRAWN BY: HLM

ASSEMBLED BY: EJS

CHECKED BY: JKF

REF. NO. 238645.00F

SHEET TITLE: PLAN- FIELDS END DRIVE & COLUMBINE DR

DATE: JANUARY 1987

SHEET 6