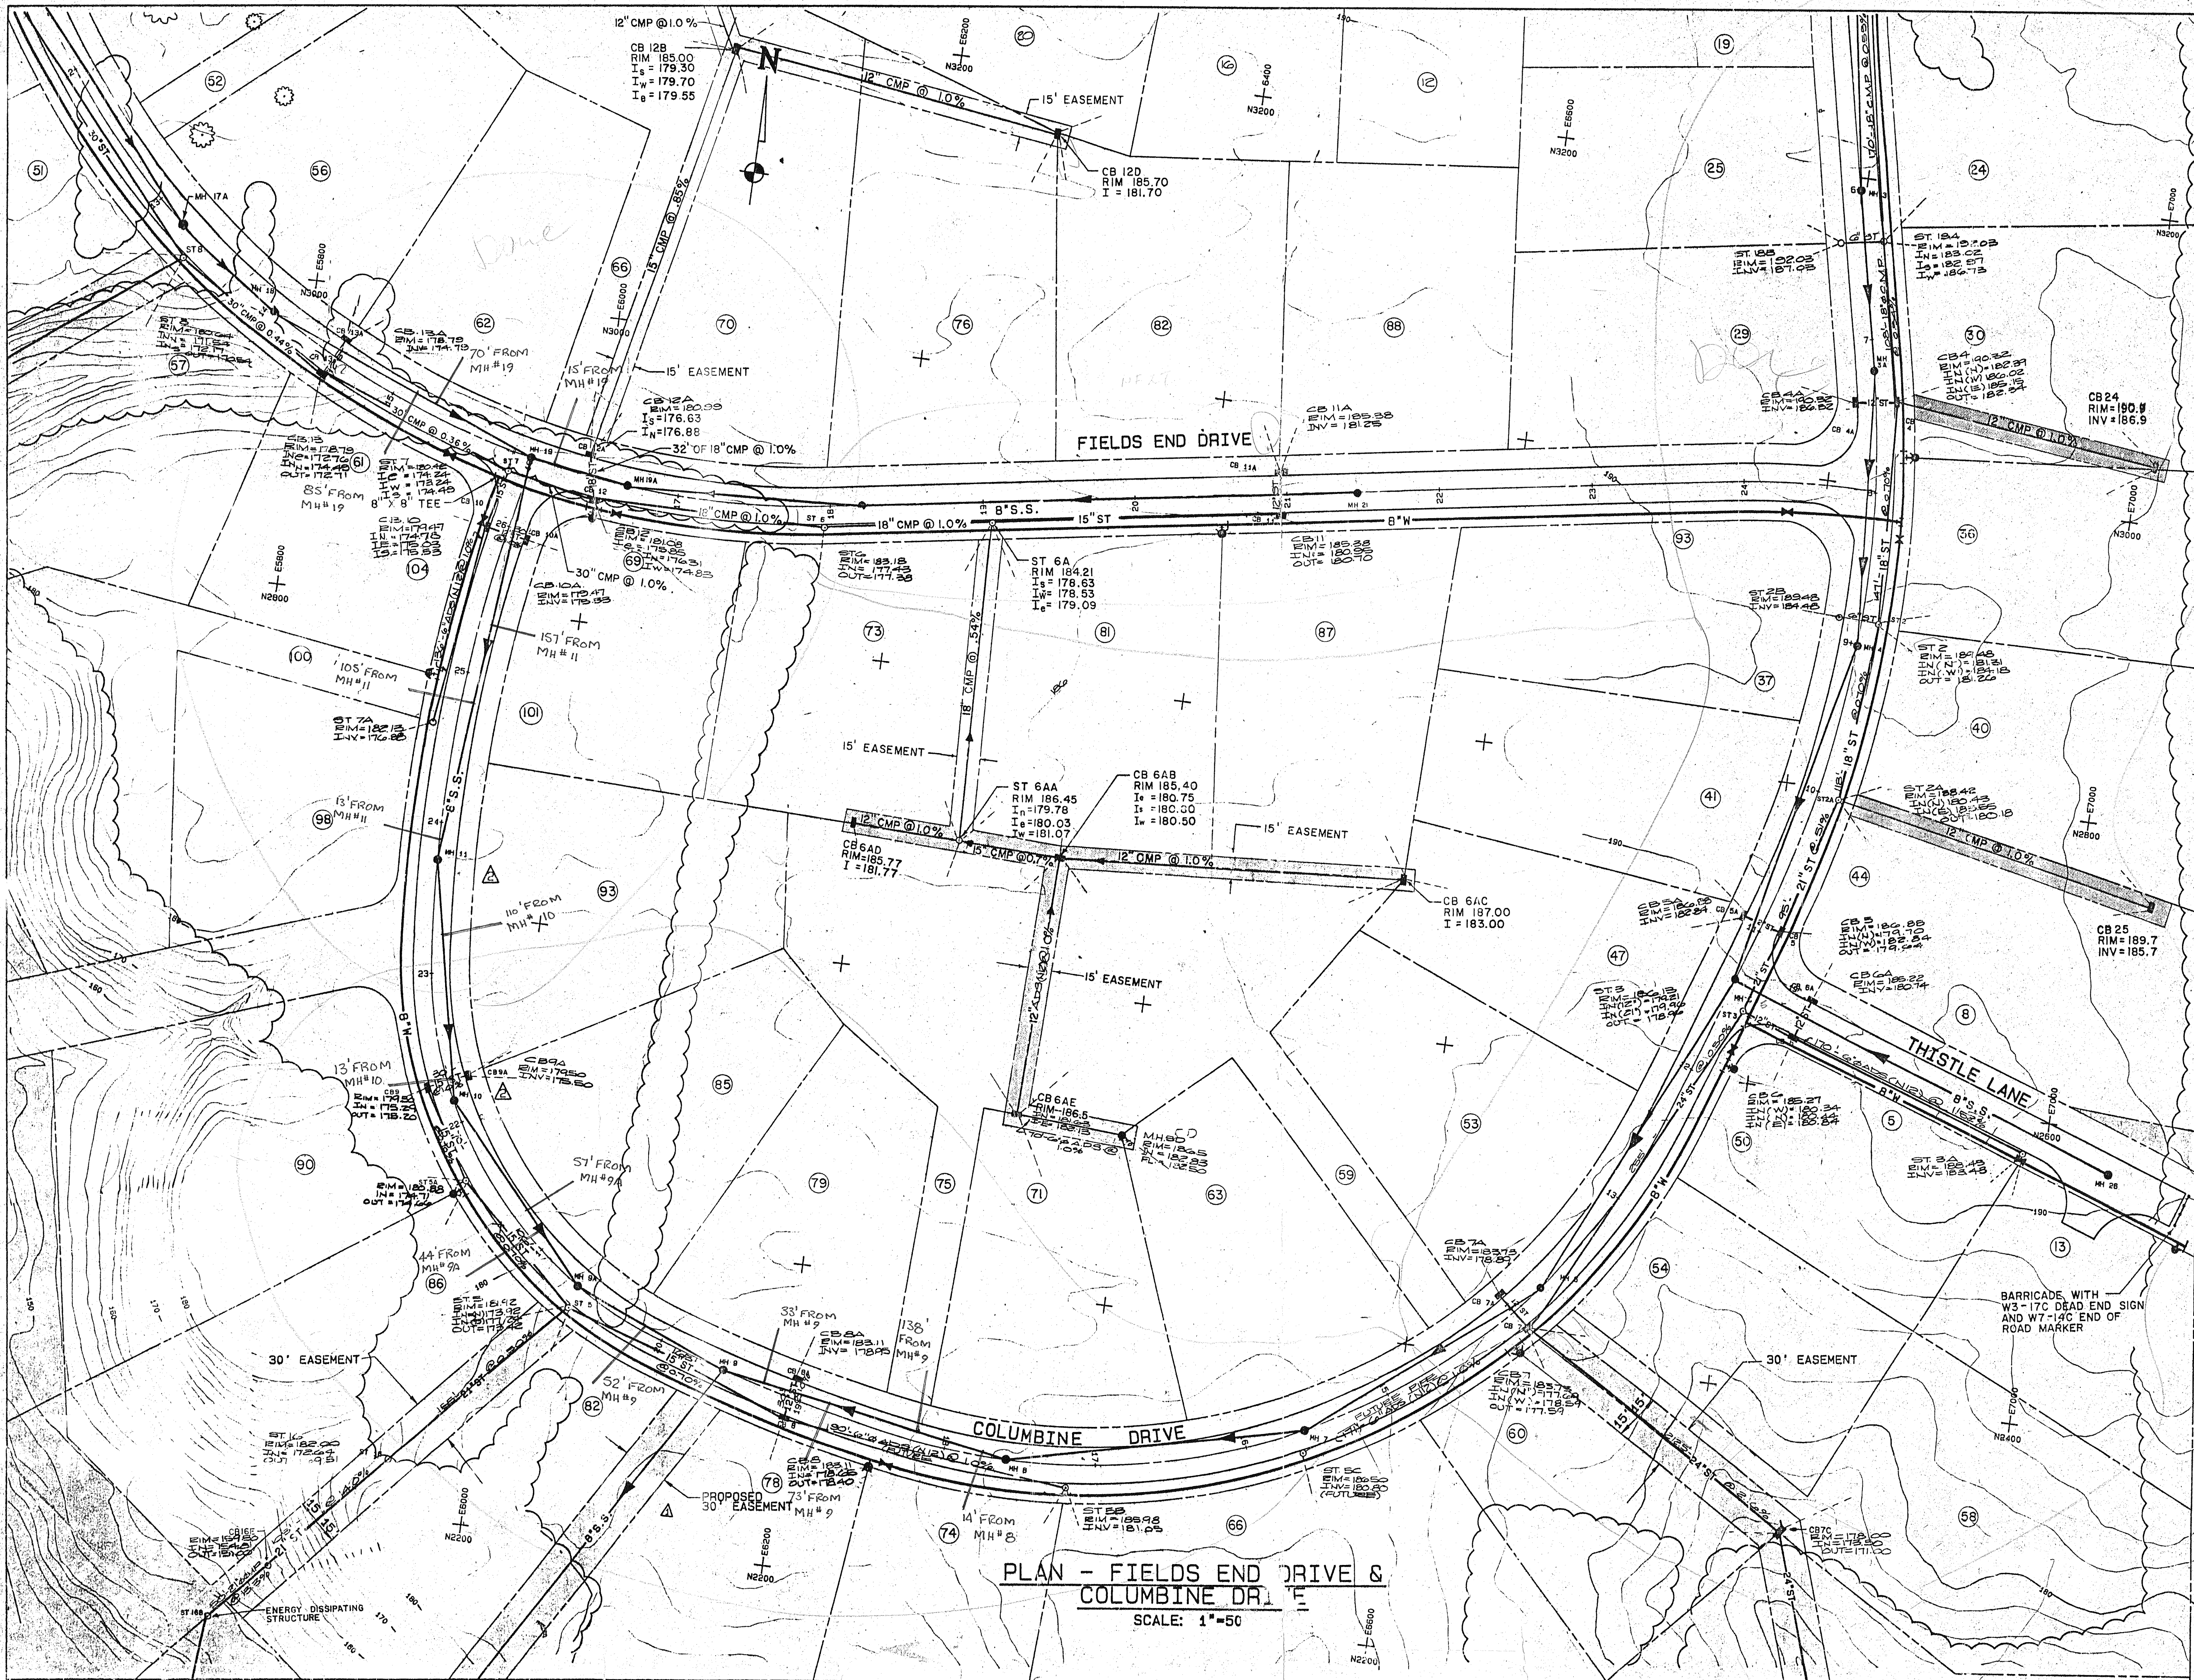


NOTES
ALL CONSTRUCTION DISTURBANCES ON
STATE OR PRIVATE LAND TO BE
RESTORED BY CONTRACTOR

UNAUTHORIZED ALTERATIONS OR ADDITIONS TO THIS DOCUMENT
IS A VIOLATION OF SECTION 7209 SUBDIVISION 2 OF THE
NEW YORK STATE EDUCATION LAW


REVISIONS

DATE	BY	DESCRIPTION	SYMBOL
6/87	JB	PROPERTY LINE FINAL CORRECTIONS	NONE
8/87	TM	ADDED OFF SITE SEWER AND EASEMENT	△
11/87	JB	MOVED MH 10 AND MH 11	△
12/89	JB	UTILITIES EDITED PER FINAL GRADING	NONE
3/12/90	JB	FINAL REVISIONS	NONE

J. KENNETH FRASER
AND ASSOCIATES, P.C.
CONSULTING ENGINEERS
RENSSELAER, NEW YORK


R & R
ASSOCIATES

THE MEADOWS
SUBDIVISION

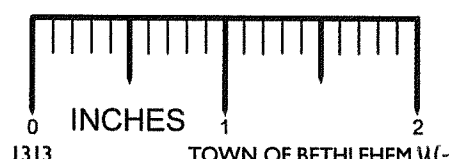

TOWN OF BETHLEHEM
NEW YORK

SCALE: AS NOTED

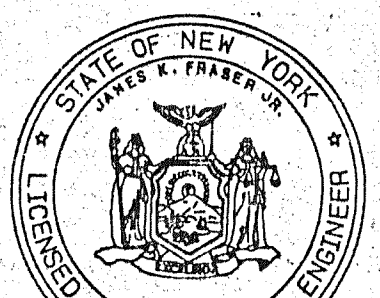

PROJ. ENG'R: JFB
DRAWN BY: HLM
ASSEMBLED BY: EJS
CHECKED BY: JKF

REF. NO. 238645.005

SHEET TITLE: PLAN - FIELDS END
DRIVE & COLUMBINE DRIVE

DATE: JANUARY 1987 SHEET 6 OF 26