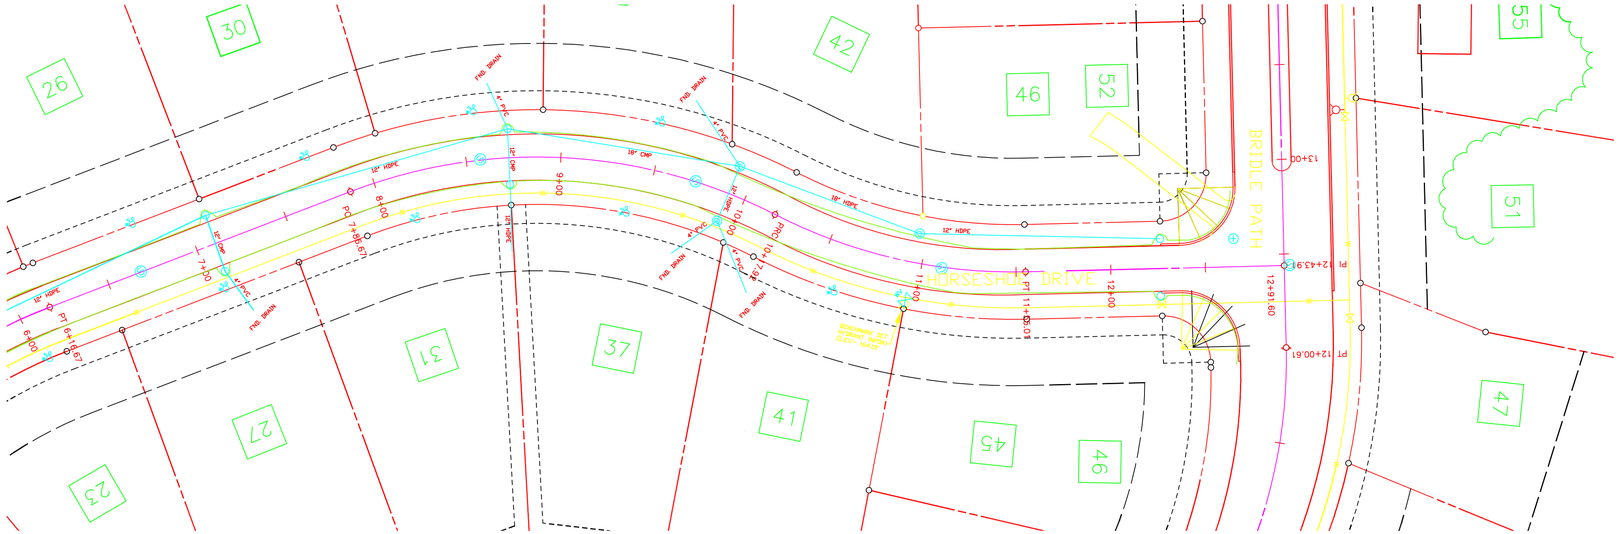

GENERAL PLAN - HORSESHOE DRIVE

CENTERLINE STATIONING 6+80 – 12+91.60

SCALE: 1" = 40'

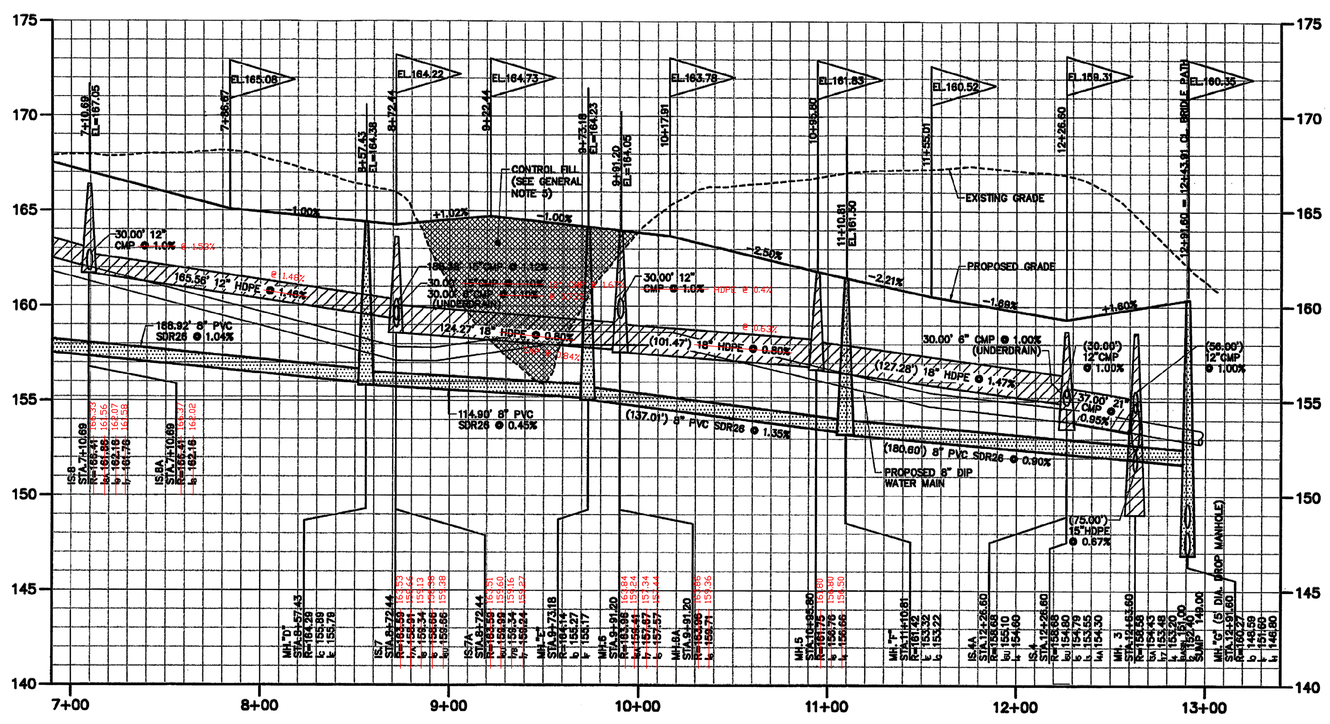

PROFILE - HORSESHOE DRIVE

SCALE: 1" = 4' VERT. / 1" = 40' HORIZ.

UNAUTHORIZED ADDITION OR ALTERATION TO THIS MAP IS A VIOLATION OF ARTICLE 145, SECTION 7209, SUB-PARAGRAPH 2 OF NEW YORK STATE EDUCATION LAW.

WATER
RECORD DRAWING
HORSESHOE DRIVE

TOWN OF BETHLEHEM	ALBANY COUNTY, N.Y.
SCALE : 1" = 40'	OCTOBER 23, 2015
JOB NO. : 15-202	15-202.DWG

SYK
S.Y. KIM LAND SURVEYOR, P.C.
260 OSBORNE ROAD, ALBANY, N.Y. 12211
PHONE : (518) 785-3969 FAX: (518) 785-1608

SHEET 2 OF 2