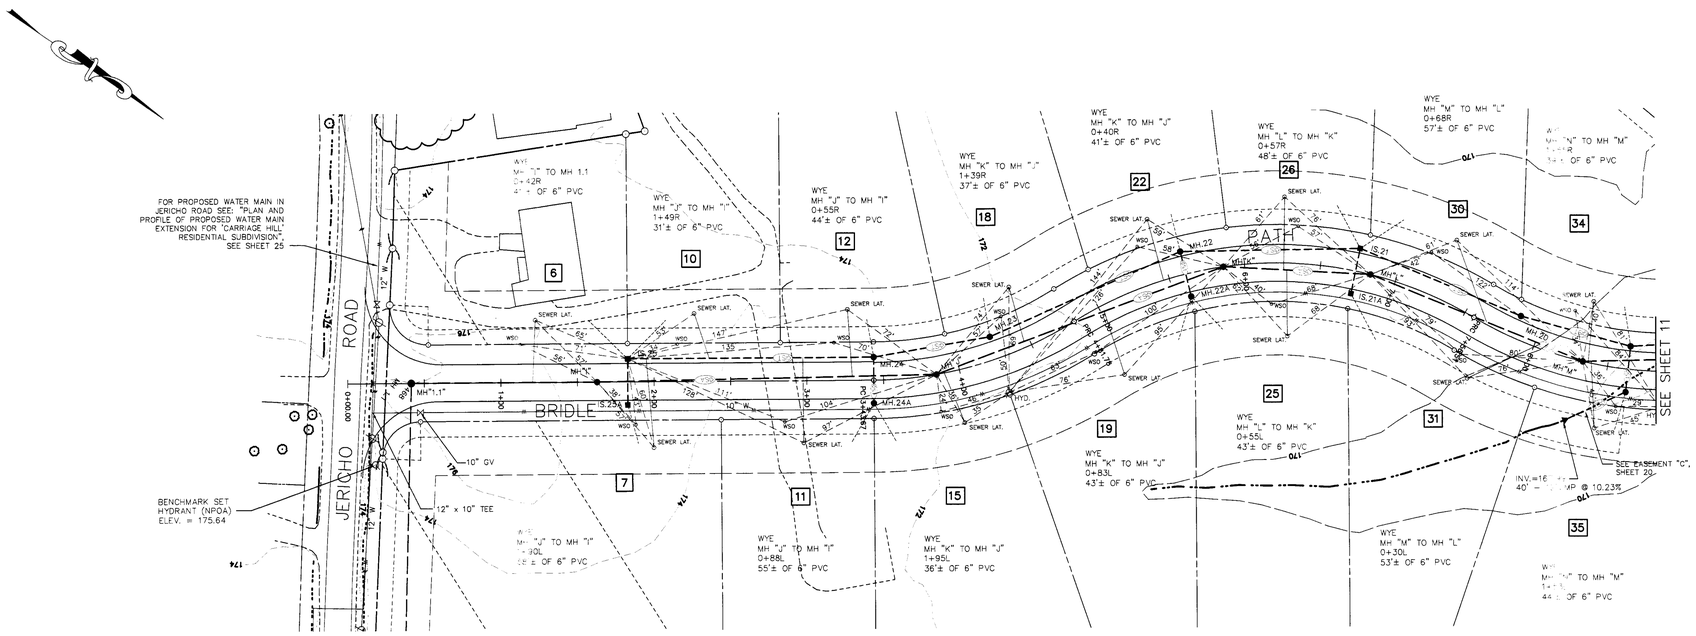

GENERAL PLAN – BRIDLE PATH

CENTERLINE STATIONING 0+00 – 8+50
SCALE: 1"= 40'

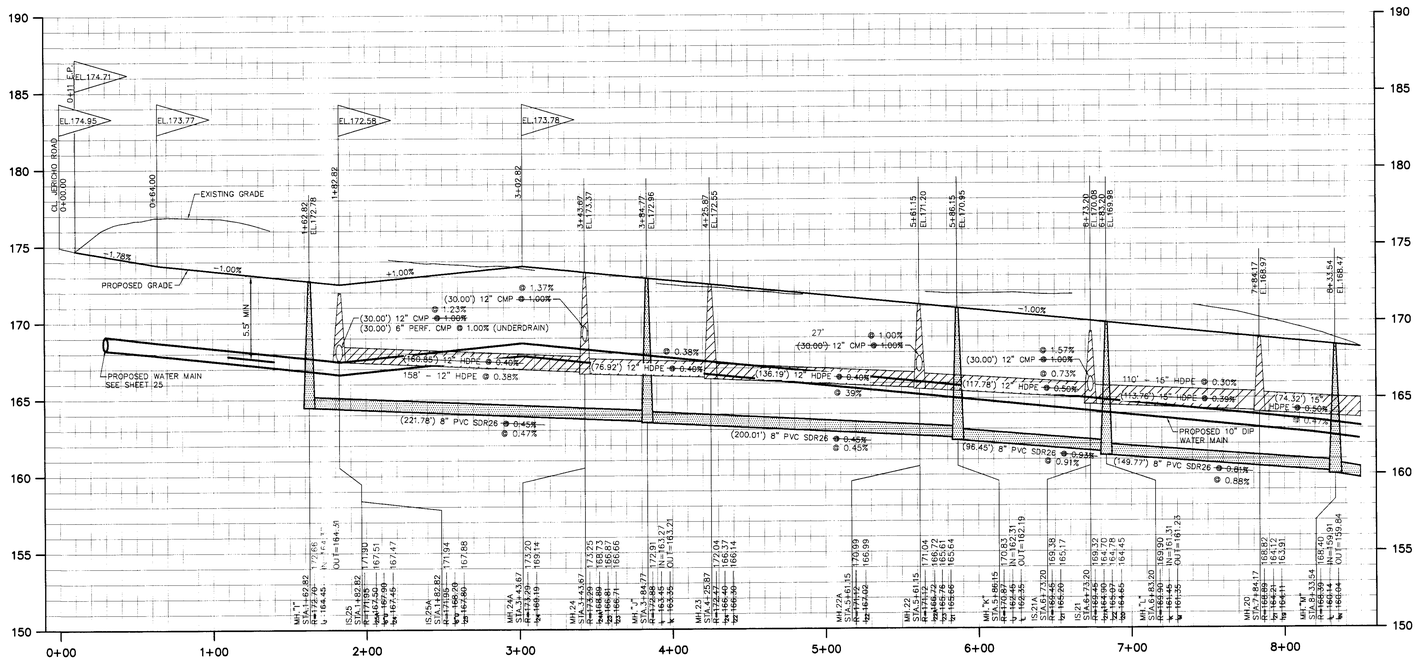

PROFILE – BRIDLE PATH

SCALE: 1"=4' VERT. / 1"=40' HORIZ.

C.T. MALE ASSOCIATES, P.C.
MAY 3 2007
PRINTED AND ISSUED

RECORD DRAWING

ALL INFORMATION SHOWN IN RED ON THESE DRAWINGS REPRESENT RECORD INFORMATION OBTAINED BY THE FIELD CREWS OF C.T. MALE ASSOCIATES, P.C. DURING THE MONTH OF DECEMBER 2006. ADDITIONAL FIELD LOCATIONS OBTAINED IN MARCH 2007.

INCHES 0 1 2
3899 TOWN OF BETHLEHEM

COPYRIGHT 1999 J. KENNETH FRASER AND ASSOCIATES, P.C.

GENERAL NOTES

UNAUTHORIZED ALTERATIONS OR ADDITIONS TO THIS DOCUMENT IS A VIOLATION OF SECTION 7209 SUBDIVISION 2 OF THE NEW YORK STATE EDUCATION LAW

REVISIONS

DATE	BY	DESCRIPTION	SYMBOL
6/99	CHJ	FINAL PLAN REVISIONS	1
10/99	CHJ	FINAL PLAN REVISIONS	2
5/00	CHJ	FINAL PLAN REVISIONS	3
12/00	CHJ	FINAL PLAN REVISIONS	4
1/26/01	CHJ	FINAL PLAN REVISIONS	5
3/06	CHJ	MISCELLANEOUS REVISIONS	6

EDWARD W. BOUTELLE AND SON
CIVIL ENGINEERS AND SURVEYORS
423 KENWOOD AVENUE
DELMAR, NEW YORK
TEL.(518) 439-9981 FAX.(518) 439-9982
A DIVISION OF J. KENNETH FRASER AND ASSOCIATES, PE, LS, LA, P.C.

FINAL PLAN AMENDED

CARRIAGE HILL SUBDIVISION

MAP OF LANDS OF

CHARLEW CONSTRUCTION CORP.

TOWN OF BETHLEHEM — COUNTY OF ALBANY
STATE OF NEW YORK

SCALE: AS NOTED

PROJ. SURVEYOR: CHJ
DRAWN BY: TWK
ASSEMBLED BY: TWK
CHECKED BY: CHJ

PROJECT NO.: 99-020
CAD FILE NAME: 4103-010

SHEET TITLE: PLAN & PROFILE
BRIDLE PATH STA. 0+00 – 8+50

DATE: NOVEMBER 1995 — SHEET 10 OF 31