


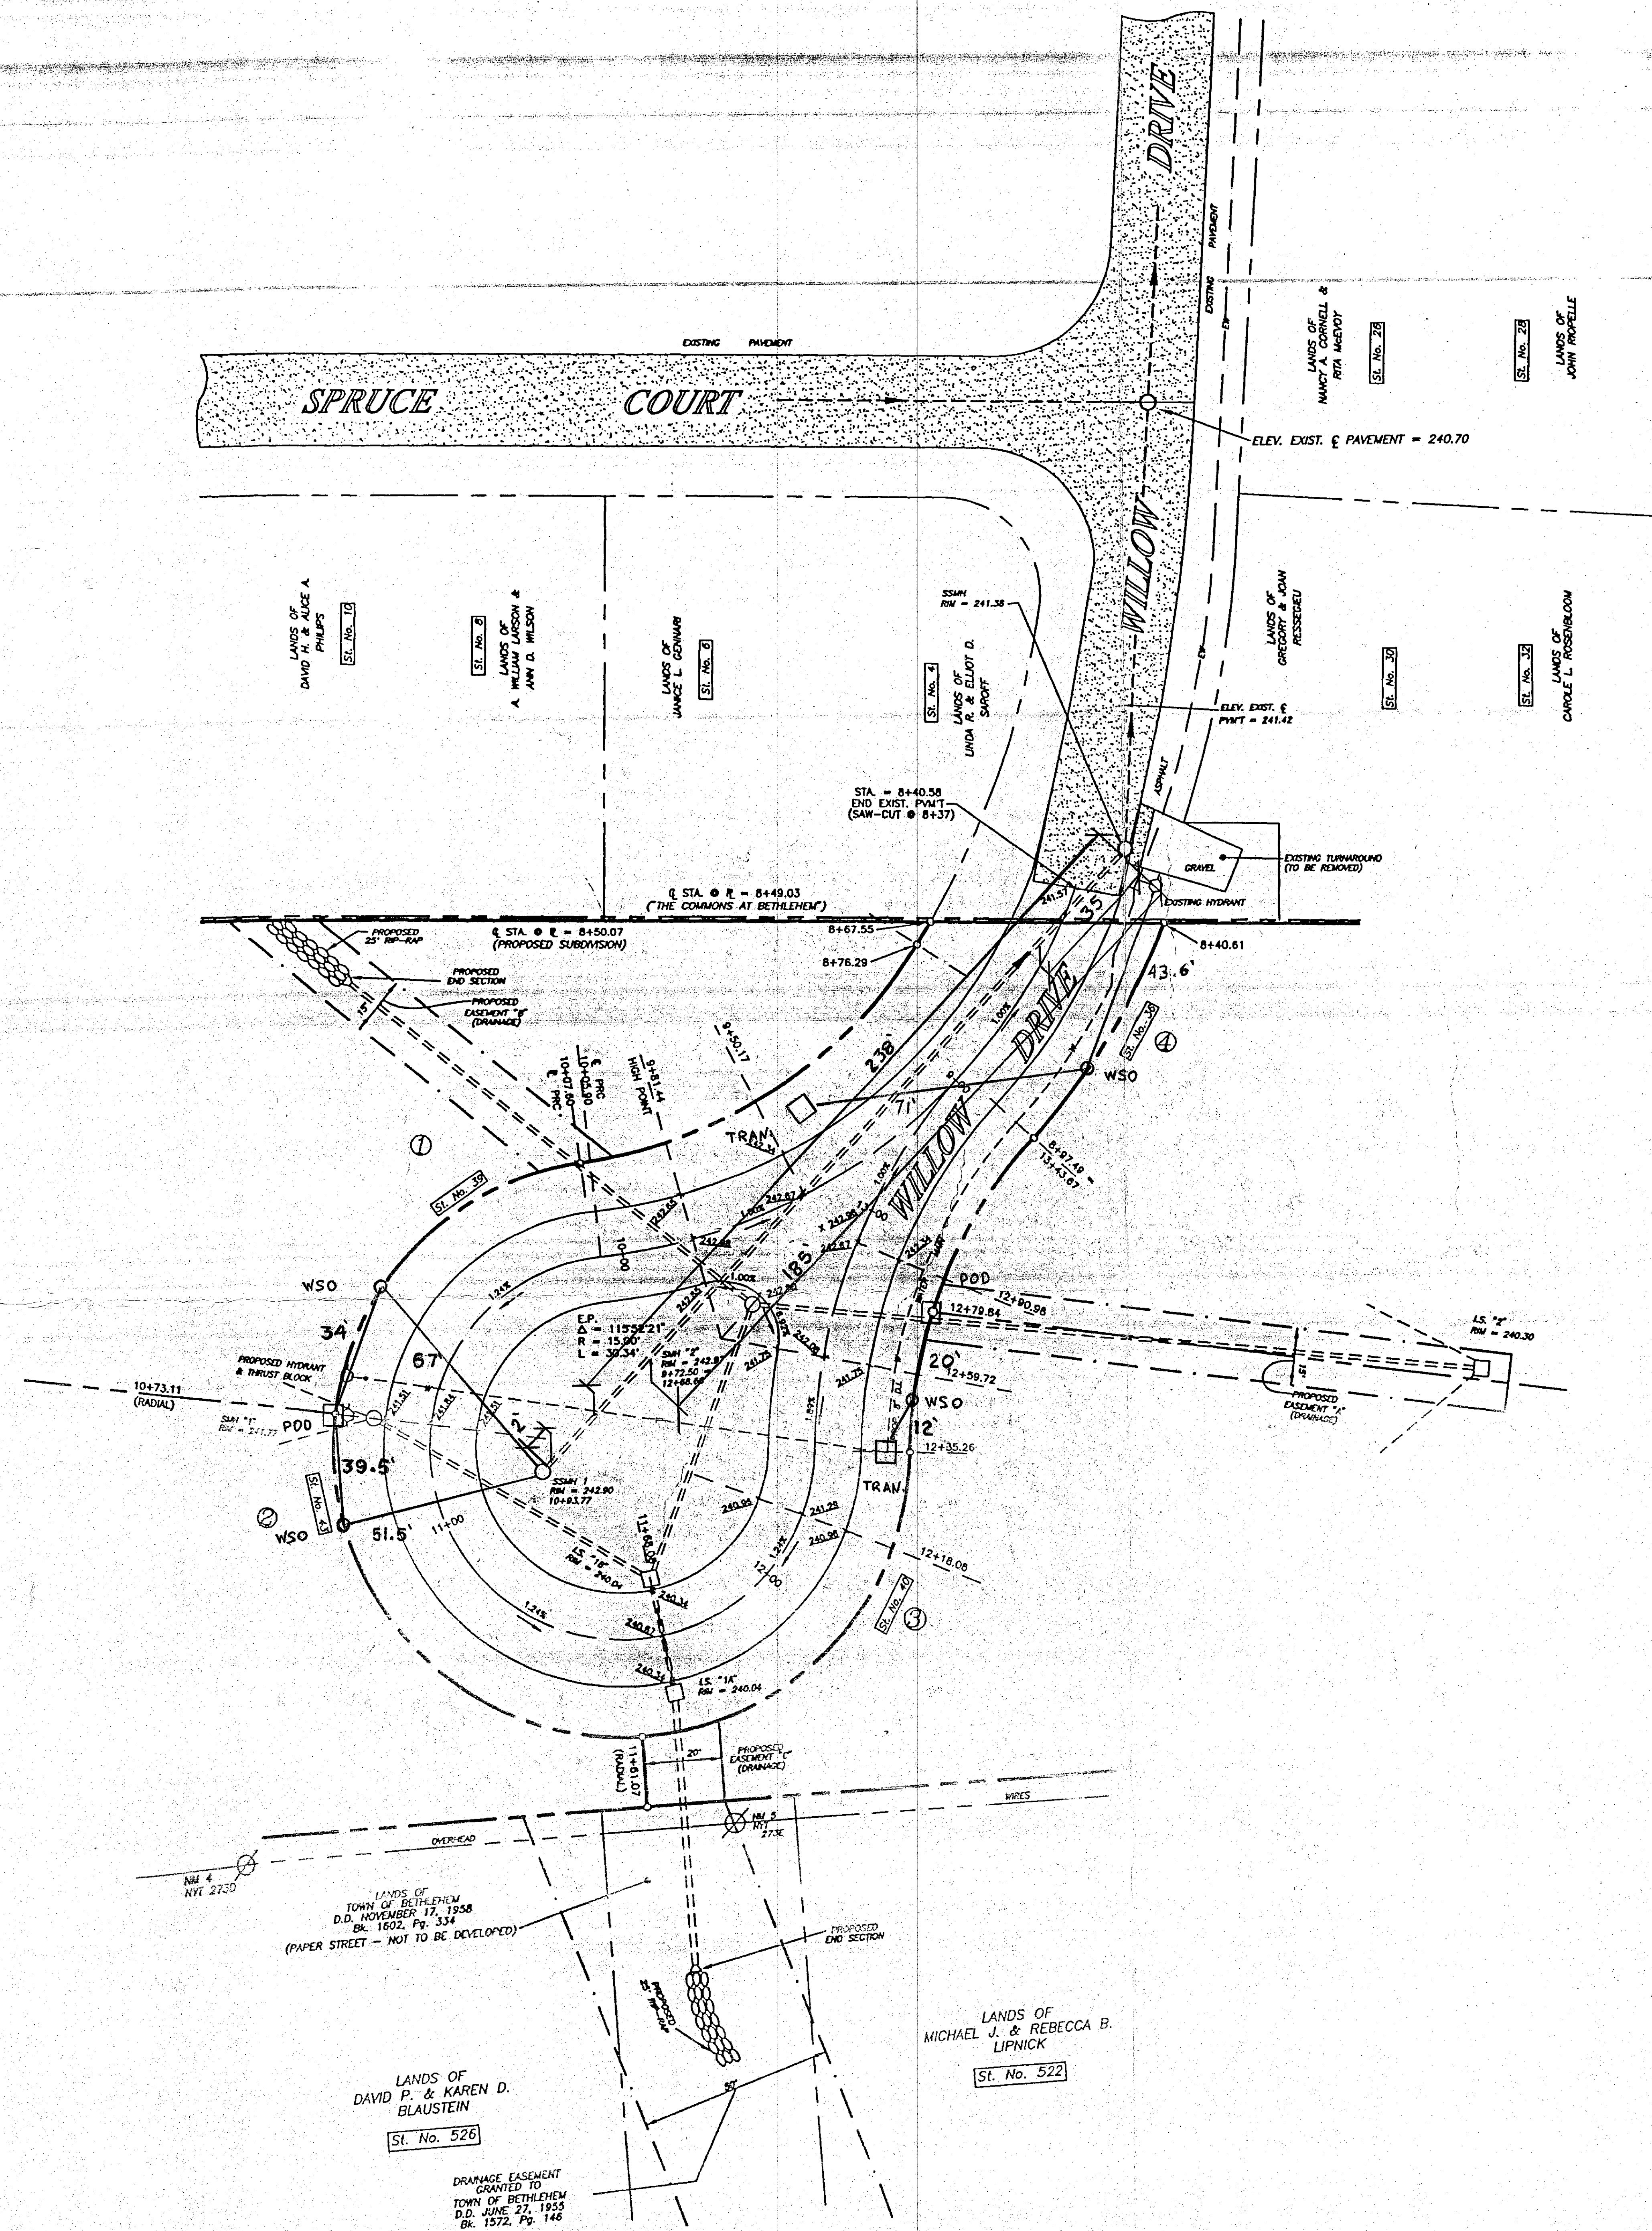

As-Built Sanitary Wye And Curb Stop Locations

CUL - DE - SAC DETAILS
 PROPOSED SUBDIVISION
"WILLOW ESTATES"
 PROPERTY OF
A. T. ZAUTNER & SON, Inc.
 TOWN OF BETHLEHEM

John T. Curran, P.E. #57455	Paul E. Hite, L.L.S. L.S. #45390	COUNTY:	ALBANY	MAP PREPARED BY: PAUL E. HITE LICENSED LAND SURVEYOR 230 DELAWARE AVENUE DELMAR, NEW YORK 12054 (518) 439-4989
		STATE:	NEW YORK	
		SCALE:	1" = 30'	
		DATE:	JANUARY 16, 2003	
		DRAWN BY:	SKD	MAP NO.: 474

REVISED: MARCH 1, 2003 - REVISIONS PER TOWN ENGINEERING & PLANNING DEPT. REVIEW COMMENTS.
 MEMO DATED FEBRUARY 12, 2003; SHEET No. 6 ADDED

