H

PAUL W. VORGANG
General Contracting
5 Bellwood Way
CASTLETON, NEW YORK 12033

See "MAP OF WESTCHESTER WOODS (FORMERLY ELMAR PARK)SUBDIVISION #1, made by J.J. Schmeder, License #20301, revised June 4, 1966.

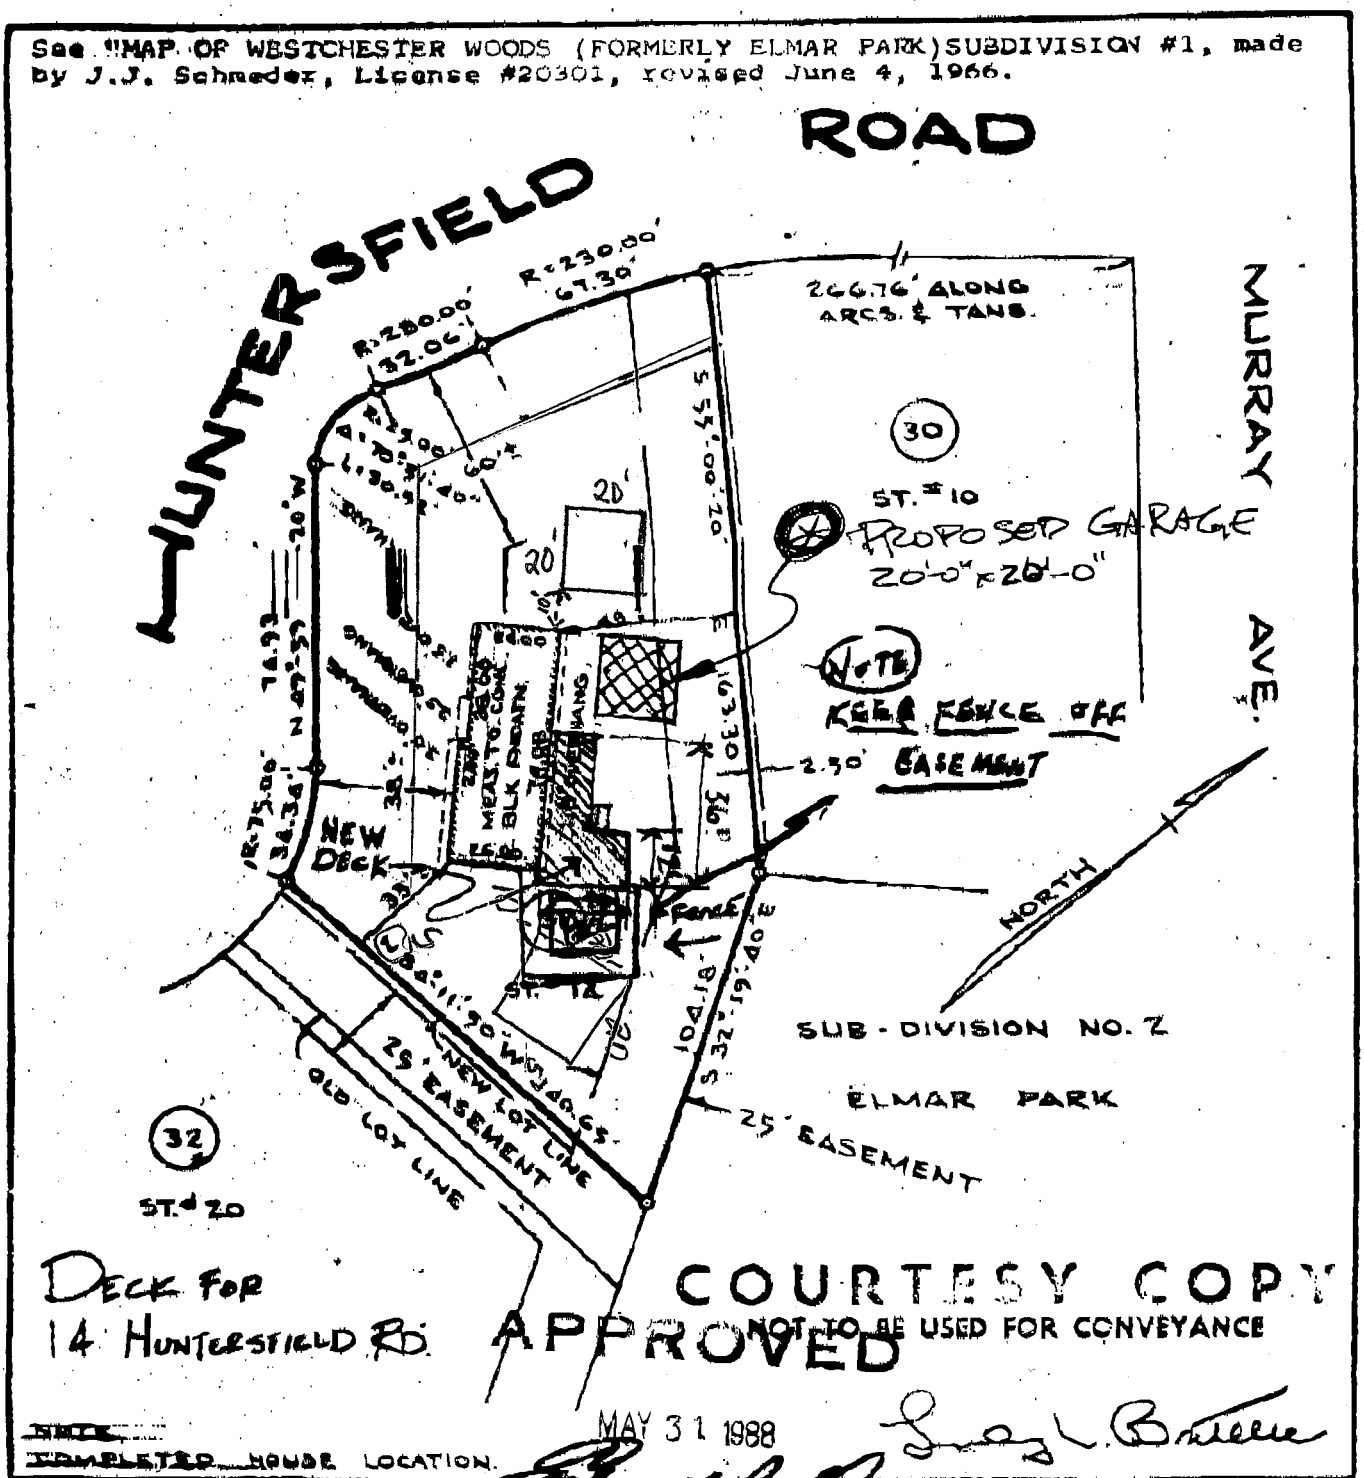

DECK FOR
14 HUNTERSFIELD RD.

COURTESY COPY
NOT TO BE USED FOR CONVEYANCE

APPROVED
MAY 31 1988
BUILDING INSPECTOR

~~SKETCH~~
COMPLETED HOUSE LOCATION.

COUNTY ALBANY	MAP OF ~~PROPOSED~~ COMPLETED DELMAR MR & MRS JEFFREY SPERBER	SCALE 1" = 50'
STATE NEW YORK		DATE MAY 17, 1988 ~~Oct. 13, 1969~~
ORDER NO. 69-529	EDWARD W. BOUTELLE AND SON CIVIL ENGINEERS AND SURVEYORS DELMAR, NEW YORK	REVISION JAN. 13, 1970 HOUSE LOCATED

1-2T-013-2B2-10-113