Map Reference:
"Subdivision Plan, Dowerskill Village, Plan Residence District No. 4 Section 3," Town of Bethlehem, Albany County, New York, prepared by C.T. Male Associates, P.C., dated April 2, 1998, last revised October 18, 1999, and filed in the Albany County Clerk's Office on October 20, 1999 in Drawer 172 as Map 10802.

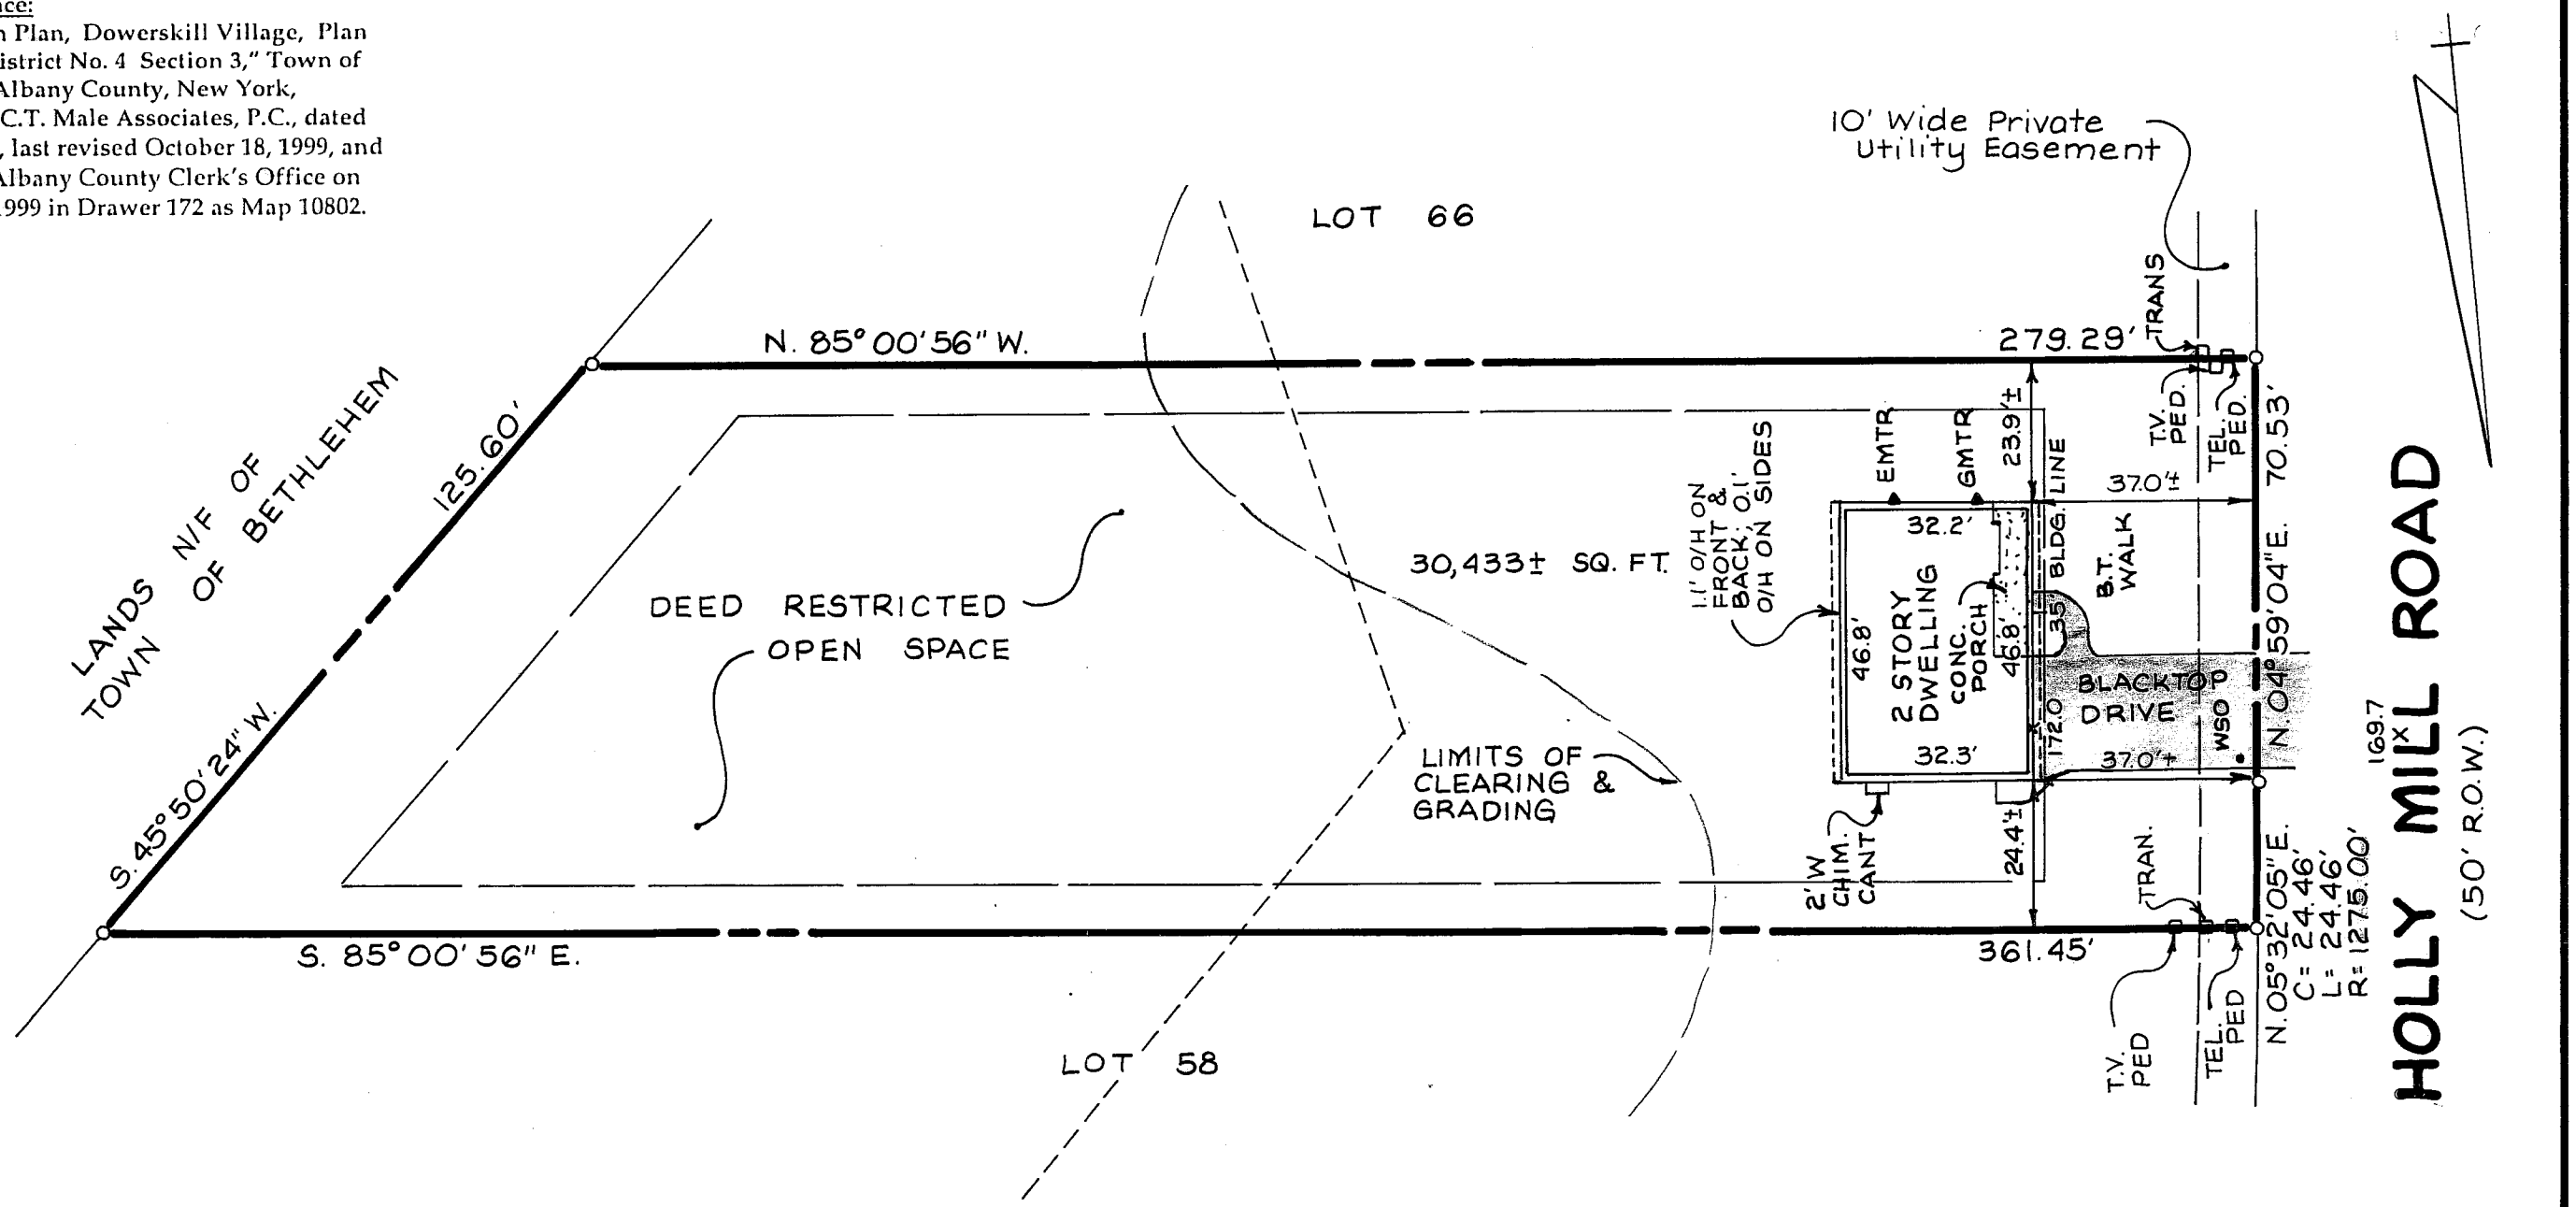

"ONLY COPIES OF THIS MAP SIGNED IN RED INK AND EMBOSSED WITH THE SEAL OF AN OFFICER OF C.T. MALE ASSOCIATES, P.C. OR A DESIGNATED REPRESENTATIVE SHALL BE CONSIDERED TO BE A VALID TRUE COPY".

Final OK
DMR 11/26/02

DATE		REVISIONS RECORD/ DESCRIPTION	DRAFTED	CHECK	APPR.
7/1/02	1	PROPOSED BLDG. LOCATION	MD	wjn	wjn
7/12/02	2	SHOW GRADING LIMIT LINE	MD	wjn	wjn
8/27/02	3	FOUNDATION LOCATION	MD	wjn	wjn
11/18/02	4	SURVEY UPDATE	MD	wjn	wjn
	5				
	6				
	7				
	8				
	9				

UNAUTHORIZED ALTERATION OR ADDITION TO THIS DOCUMENT IS A VIOLATION OF SECTION 7209 SUBDIVISION 2 OF THE NEW YORK STATE EDUCATION LAW.

© 2002 C.T. MALE ASSOCIATES P.C.

PROJ. NO: 00.6435
APPROVED:
CHECKED: wjn
DRAFTED: MD

LOT 62 HOLLY MILL ROAD

DOWERSKILL VILLAGE

PLANNED RESIDENCE DISTRICT Nº 4 SECTION 3
PHASE 1E

TOWN OF BETHLEHEM | ALBANY COUNTY, N.Y.

C.T. MALE ASSOCIATES, P.C.
50 CENTURY HILL DRIVE, P.O. BOX 727, LATHAM, NY 12110
(518) 786-7400 • FAX (518) 786-7299
ENGINEERING • LAND SURVEYING • BUILDING SYSTEMS
LAND PLANNING • ENVIRONMENTAL SERVICES • GPS/GIS SERVICES

SCALE: 1" = 30'
SHEET 1 OF 1
DATE: 07/01/02
DWG. NO: 00-378

DATAPRINT N976473