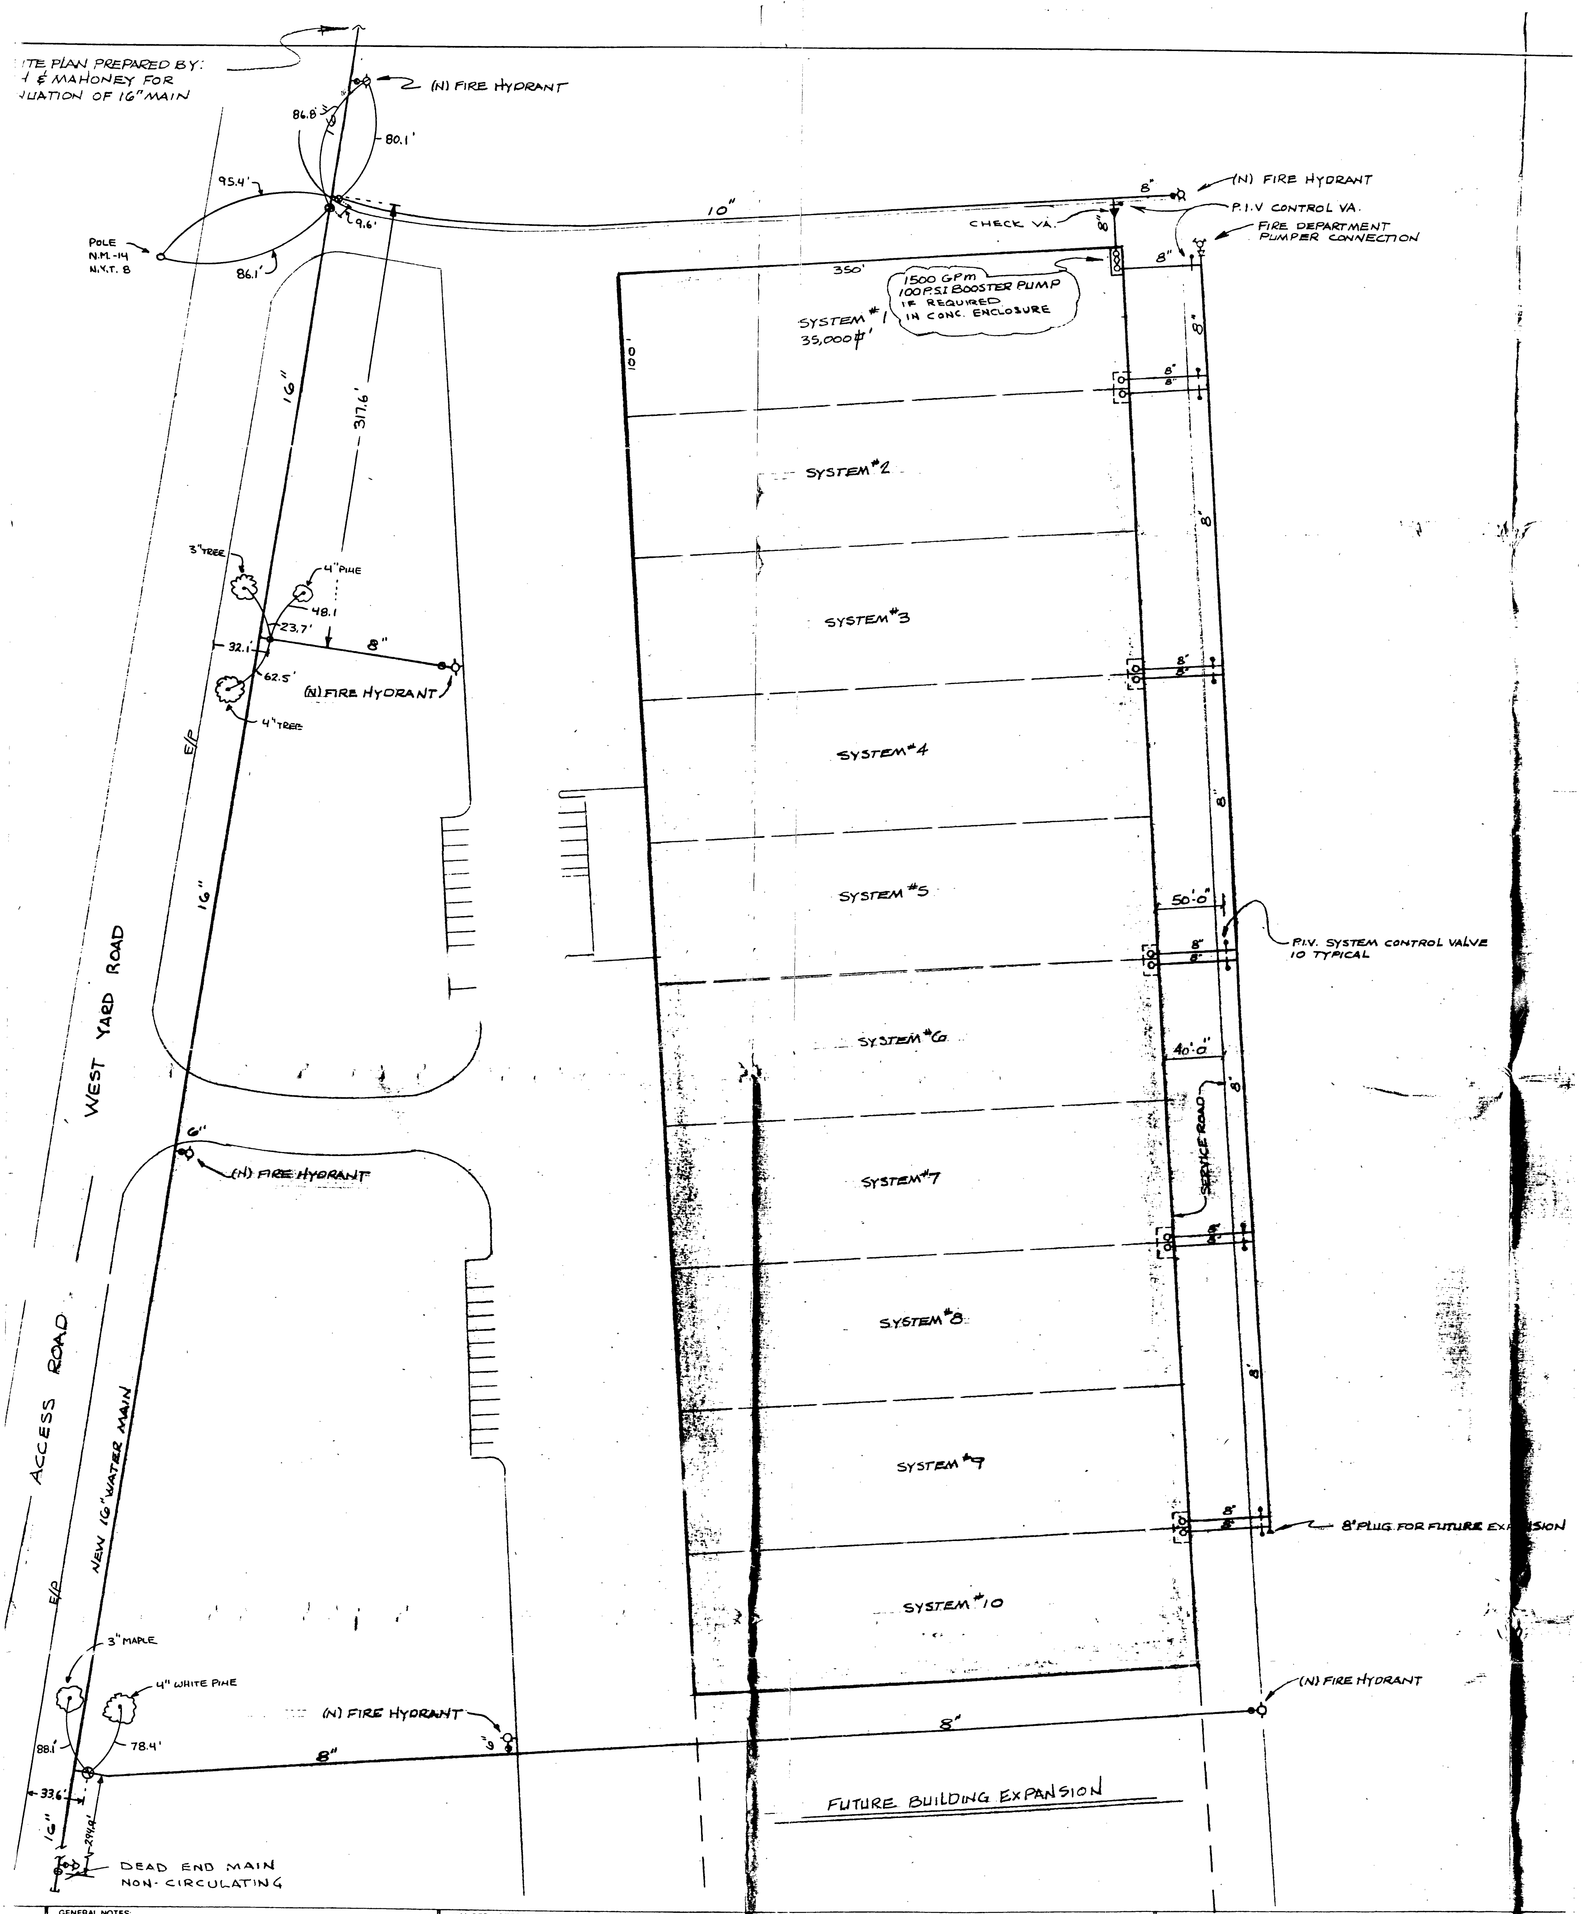

GENERAL NOTES:	HANGER NOTES	JOB INFO	AREA	PHONE	SPRINKLERS:							
1 DESIGN AND INSTALLATION SHALL CONFORM WITH N.F.P.A. PAMPHLETS.					TYPE	FINISH	N.P.T.	ORIFICE	"K"	SYMBOL	TEMP.	QUANT
2 UNDERGROUND TO BE PROVIDED WITH PROPER CLAMPING AND OR CONCRETE THRUST BLOCKS AT ALL CHANGES IN DIRECTION	#1 U-HOOK AS NOTED											
3 UNDERGROUND TO BE PROPERLY FLUSHED AND TESTED	#2 WRAP AROUND U-HOOK AS NOTED											
4 PROVIDE EARTHQUAKE BRACING AS REQUIRED	#3 SHORT CLIP AS NOTED											
5 ALL MATERIAL AND DEVICES TO BE U.L. LISTED	#4 PHILLIPS SHELL ROD AS NOTED RING											
	#5 SIDE BEAM BRACKET ROD AS NOTED RING											
	#6 HEADER ROD AS NOTED NUTS RING											
	#7 CEILING FLANGE ROD AS NOTED RING											
	#8 C-CLAMP ROD AS NOTED RING											
	#9 2 C-CLAMP U-BOLT AS NOTED											
	#10 PIPE TRAPEZE ROD AS NOTED RING											

FIRE
Contr:
7827 P
P.O. B
Elverts.
918 - 95

INCHES
0 1 2
4250 X - 13 TOWN OF BETHLEHEM

RECORD DRAWINGS