INSTALL 1020 FT. OF 3" (BARE) ON FUERA BUSH RD. AND AC 5 FT. OF 2" PLASTIC ON JOLLY RD. MEDIUM PRESSURE GAS DISTRIBUTION MAIN, IN THE TN. OF BETHLEHEM HIGHWAY BOUND.

INSTALL GAS MAIN AS PER NIAGARA MOHAWK SYSTEMS SPECIFICATIONS GD 1012

INSTALL ANODES IN DIKE AND TEST PROVISIONS PER PAGES 4.2.03 & 4.2.04 OF THE GAS STANDARDS

4 HIGHWAY BORES TO BE MADE AS PER PAGE 5.0.51 OF THE GAS STANDARDS

N.Y.S. THRUWAY AUTHORITY PERMIT

PERMIT TO MAKE A 4'x20'x3' DEEP TRENCH ON THE WEST SIDE, A 7'x20'x3' DEEP TRENCH ON THE EAST SIDE AND A 40'x7'x3' DEEP TRENCH IN THE CENTER MALL IN ORDER TO INSTALL 2" NATURAL MEDIUM GAS MAIN ON N.Y.S. THRUWAY OVER PROVIDED MALL PER ISH AC 8 STREAM TRENCH IN CENTER MALL TO BE [illegible] ON WEST SIDE OF [illegible] AND [illegible] ON EAST SIDE. ALL FENCES TO BE REPAIRED TO FOUND AS SOON AS POSSIBLE. [illegible] SAFETY [illegible] OF THE N.Y.S. THRUWAY AUTHORITY [illegible] PERMIT.

STATE PERMIT

PERMIT TO MAKE A 6'x4'x20'x3' DEEP TRENCH ON THE FUERA BUSH RD., S.H. 367 - N.Y.S. RT. 32. STARTING ON THE NORTH SIDE AT THE EAST BOUNDARY LINE OF THE N.Y.S. THRUWAY (SOUTH IN AN EASTERLY DIRECTION. THEN CROSSING THE MAIN HIGHWAY PAVING TO THE SOUTH. THE HENCE CONTINUING IN AN EASTERLY DIRECTION 16 FT. 4CC'S FUERA BUSH RD. AS SHOWN. NO PAVING ON MAIN HIGHWAY PAVING TO BE DISTURBED. ALL EXCAVATED MATERIAL TO BE REMOVED AS FOUND. TRENCH IS TO BE MAINTAINED AT ALL TIMES.

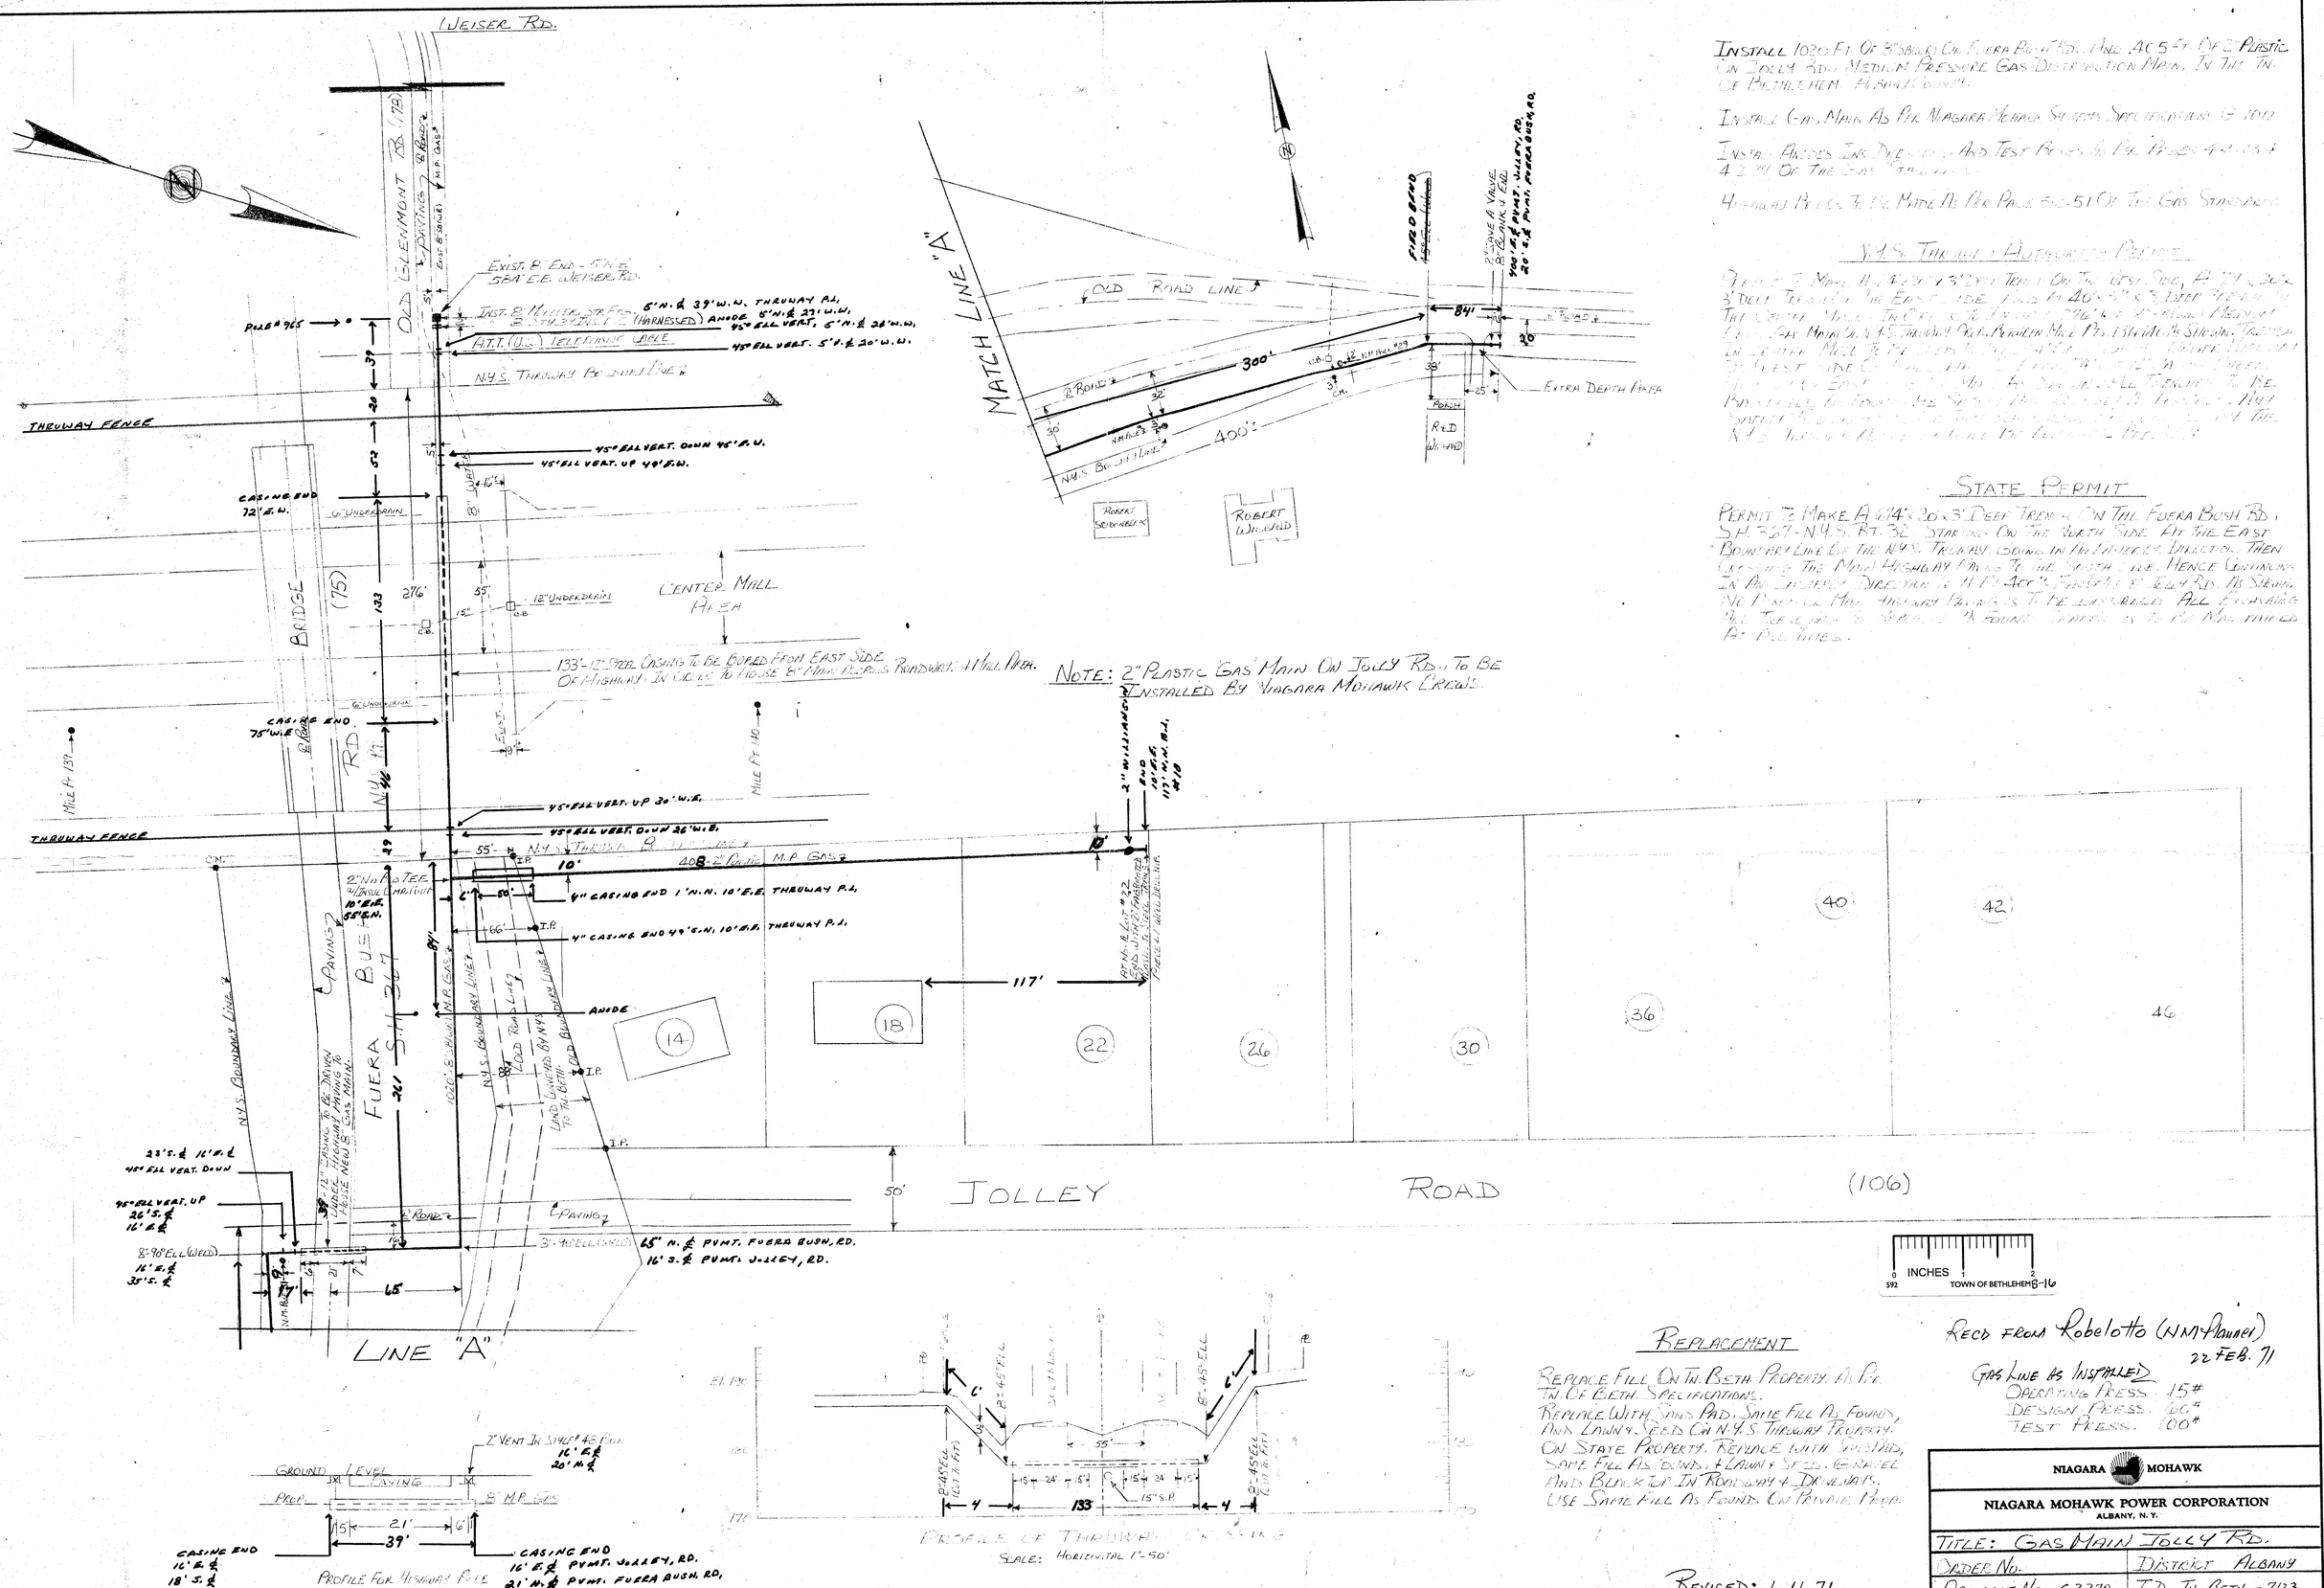

REPLACEMENT

REPLACE FILL ON TN. BETH. PROPERTY AS PER TN. OF BETH. SPECIFICATIONS.
REPLACE WITH SAND PAD, SAME FILL AS FOUND, AND LAWN & SEED ON N.Y.S. THRUWAY PROPERTY.
ON STATE PROPERTY, REPLACE WITH SAND PAD, SAME FILL AS FOUND, & LAWN & SEED. GRAVEL AND BLACK TOP IN ROADWAY & DRIVEWAYS.
USE SAME FILL AS FOUND ON PRIVATE PROP.

REVISED: 1-11-71

NO.	DATE	BY	DESCRIPTION OF REVISION	CK.	APP.

RECD FROM Robelotto (N.M. Planner) 22 FEB. 71

GAS LINE AS INSTALLED
OPERATING PRESS. 15#
DESIGN PRESS. 60#
TEST PRESS. 100#

NIAGARA MOHAWK

NIAGARA MOHAWK POWER CORPORATION
ALBANY, N.Y.

TITLE: GAS MAIN JOLLY RD.

ORDER NO.	DISTRICT ALBANY
PROJECT NO. 63270	T.D. TN. BETH. - 7123
DRAWN/DATE A.C.R. 1/6/70	ZONE NO. 1024-176-C4
WORK DONE AS SHOWN	SHEET 1 OF 1

DES. | DR. | TR. | CK. | DATE | SCALE
APP. | APP. | INDEX
APP. | APP. | NO.