

FED. ROAD REG. NO.	STATE	FEDERAL AID PROJECT NO.	SHEET NO.	TOTAL SHEETS
1	N.Y.			
GLENMONT - FEURA BUSH				
S.H. NO. 367				
ALBANY COUNTY, P.I.N. 1460.20				


CURVE #2 DATA

PI = @ STA 33+50.03
D = 04'-30"-00.0"
R = 1273.24'
L = 59.728'
Δ = 08'-18"-46.0"
LS = 125'

CURVE #1 DATA

PI = @ STA 29+15.00
D = 04'-30"-00.0"
R = 1273.240'
L = 61.975'
Δ = 08'-24"-49.9"
LS = 125'

IN CHARGE OF DESIGNED BY CHECKED BY ESTIMATED BY CHECKED BY DRAFTED BY CHECKED BY DATE

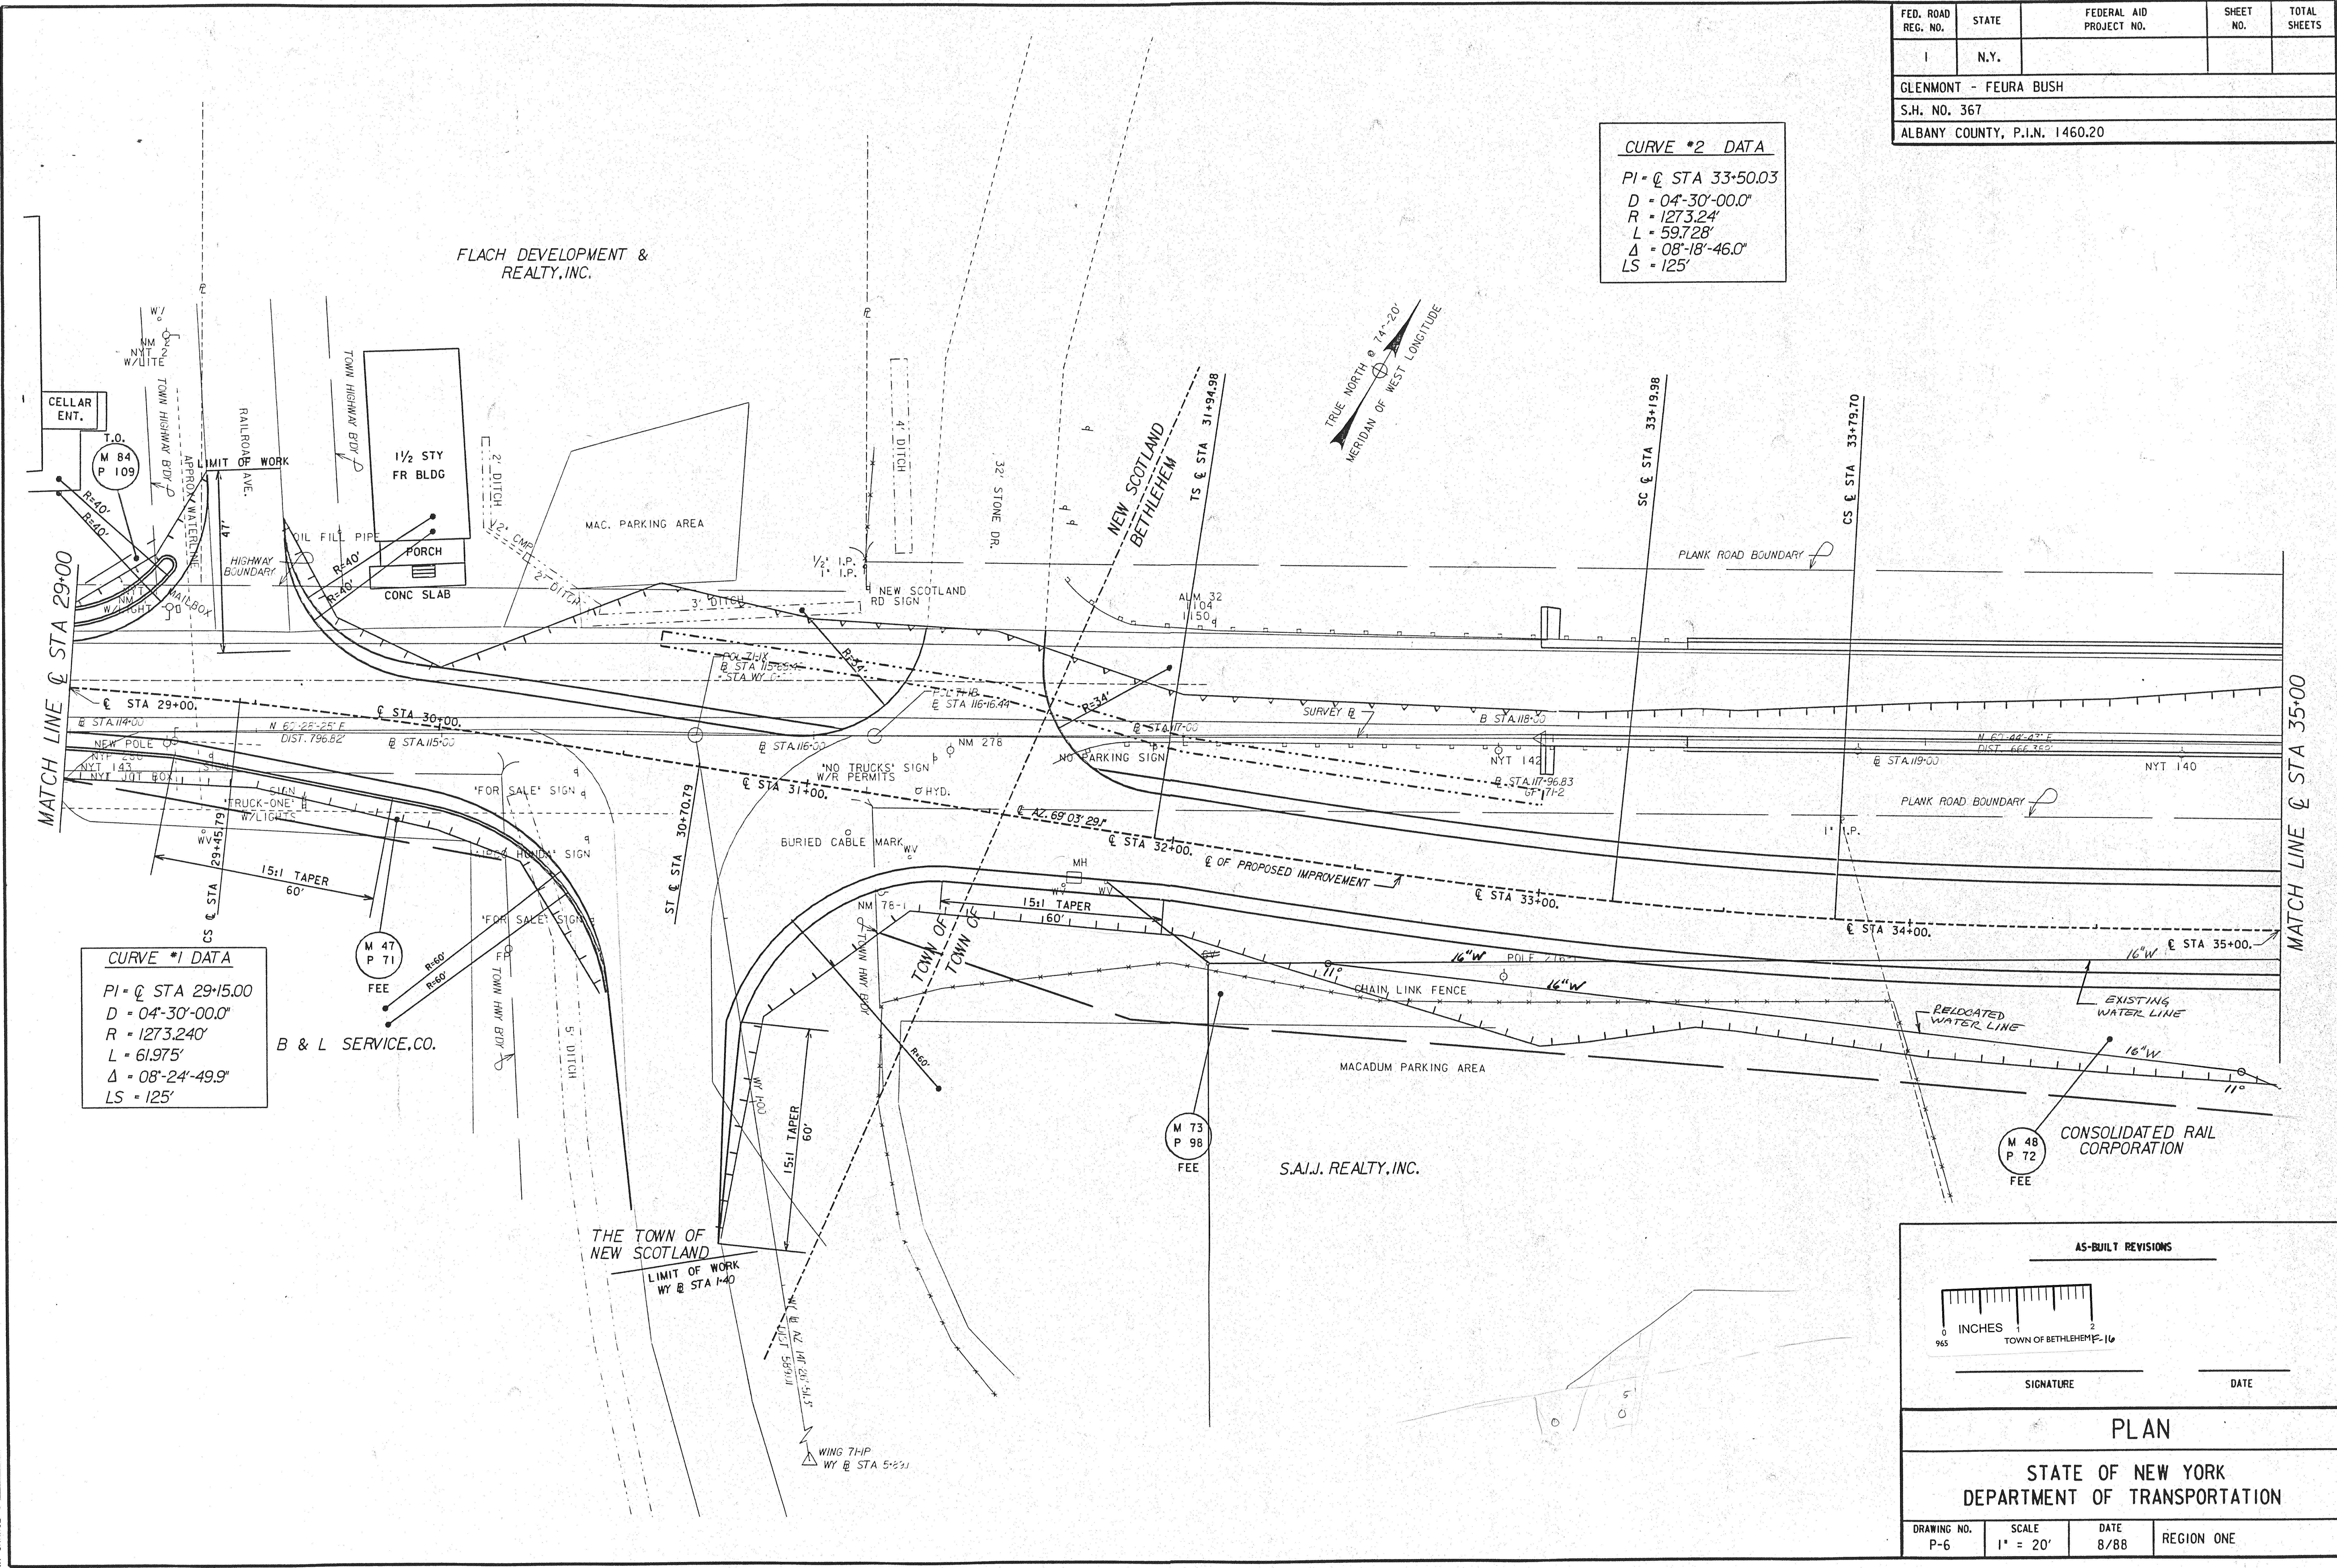

AS-BUILT REVISIONS

0 1 2 INCHES
965 TOWN OF BETHLEHEM 10

SIGNATURE DATE

PLAN

STATE OF NEW YORK
DEPARTMENT OF TRANSPORTATION

DRAWING NO. P-6	SCALE 1" = 20'	DATE 8/88	REGION ONE
--------------------	-------------------	--------------	------------