


IN CHARGE OF DESIGNED BY CHECKED BY ESTIMATED BY DRAFTED BY CHECKED BY DATE

CURVE \*3 DATA

PI =  $\phi$  STA 45+42.07  
D = 03°-00'-00.0"  
R = 1909.859'  
L = 812.903'  
 $\Delta$  = 28°-08'-13.5"  
LS = 125'

| FED. ROAD REG. NO.            | STATE | FEDERAL AID PROJECT NO. | SHEET NO. | TOTAL SHEETS |
|-------------------------------|-------|-------------------------|-----------|--------------|
| 1                             | N.Y.  |                         |           |              |
| GLENMONT - FEURA BUSH         |       |                         |           |              |
| S.H. NO. 367                  |       |                         |           |              |
| ALBANY COUNTY, P.I.N. 1460.20 |       |                         |           |              |

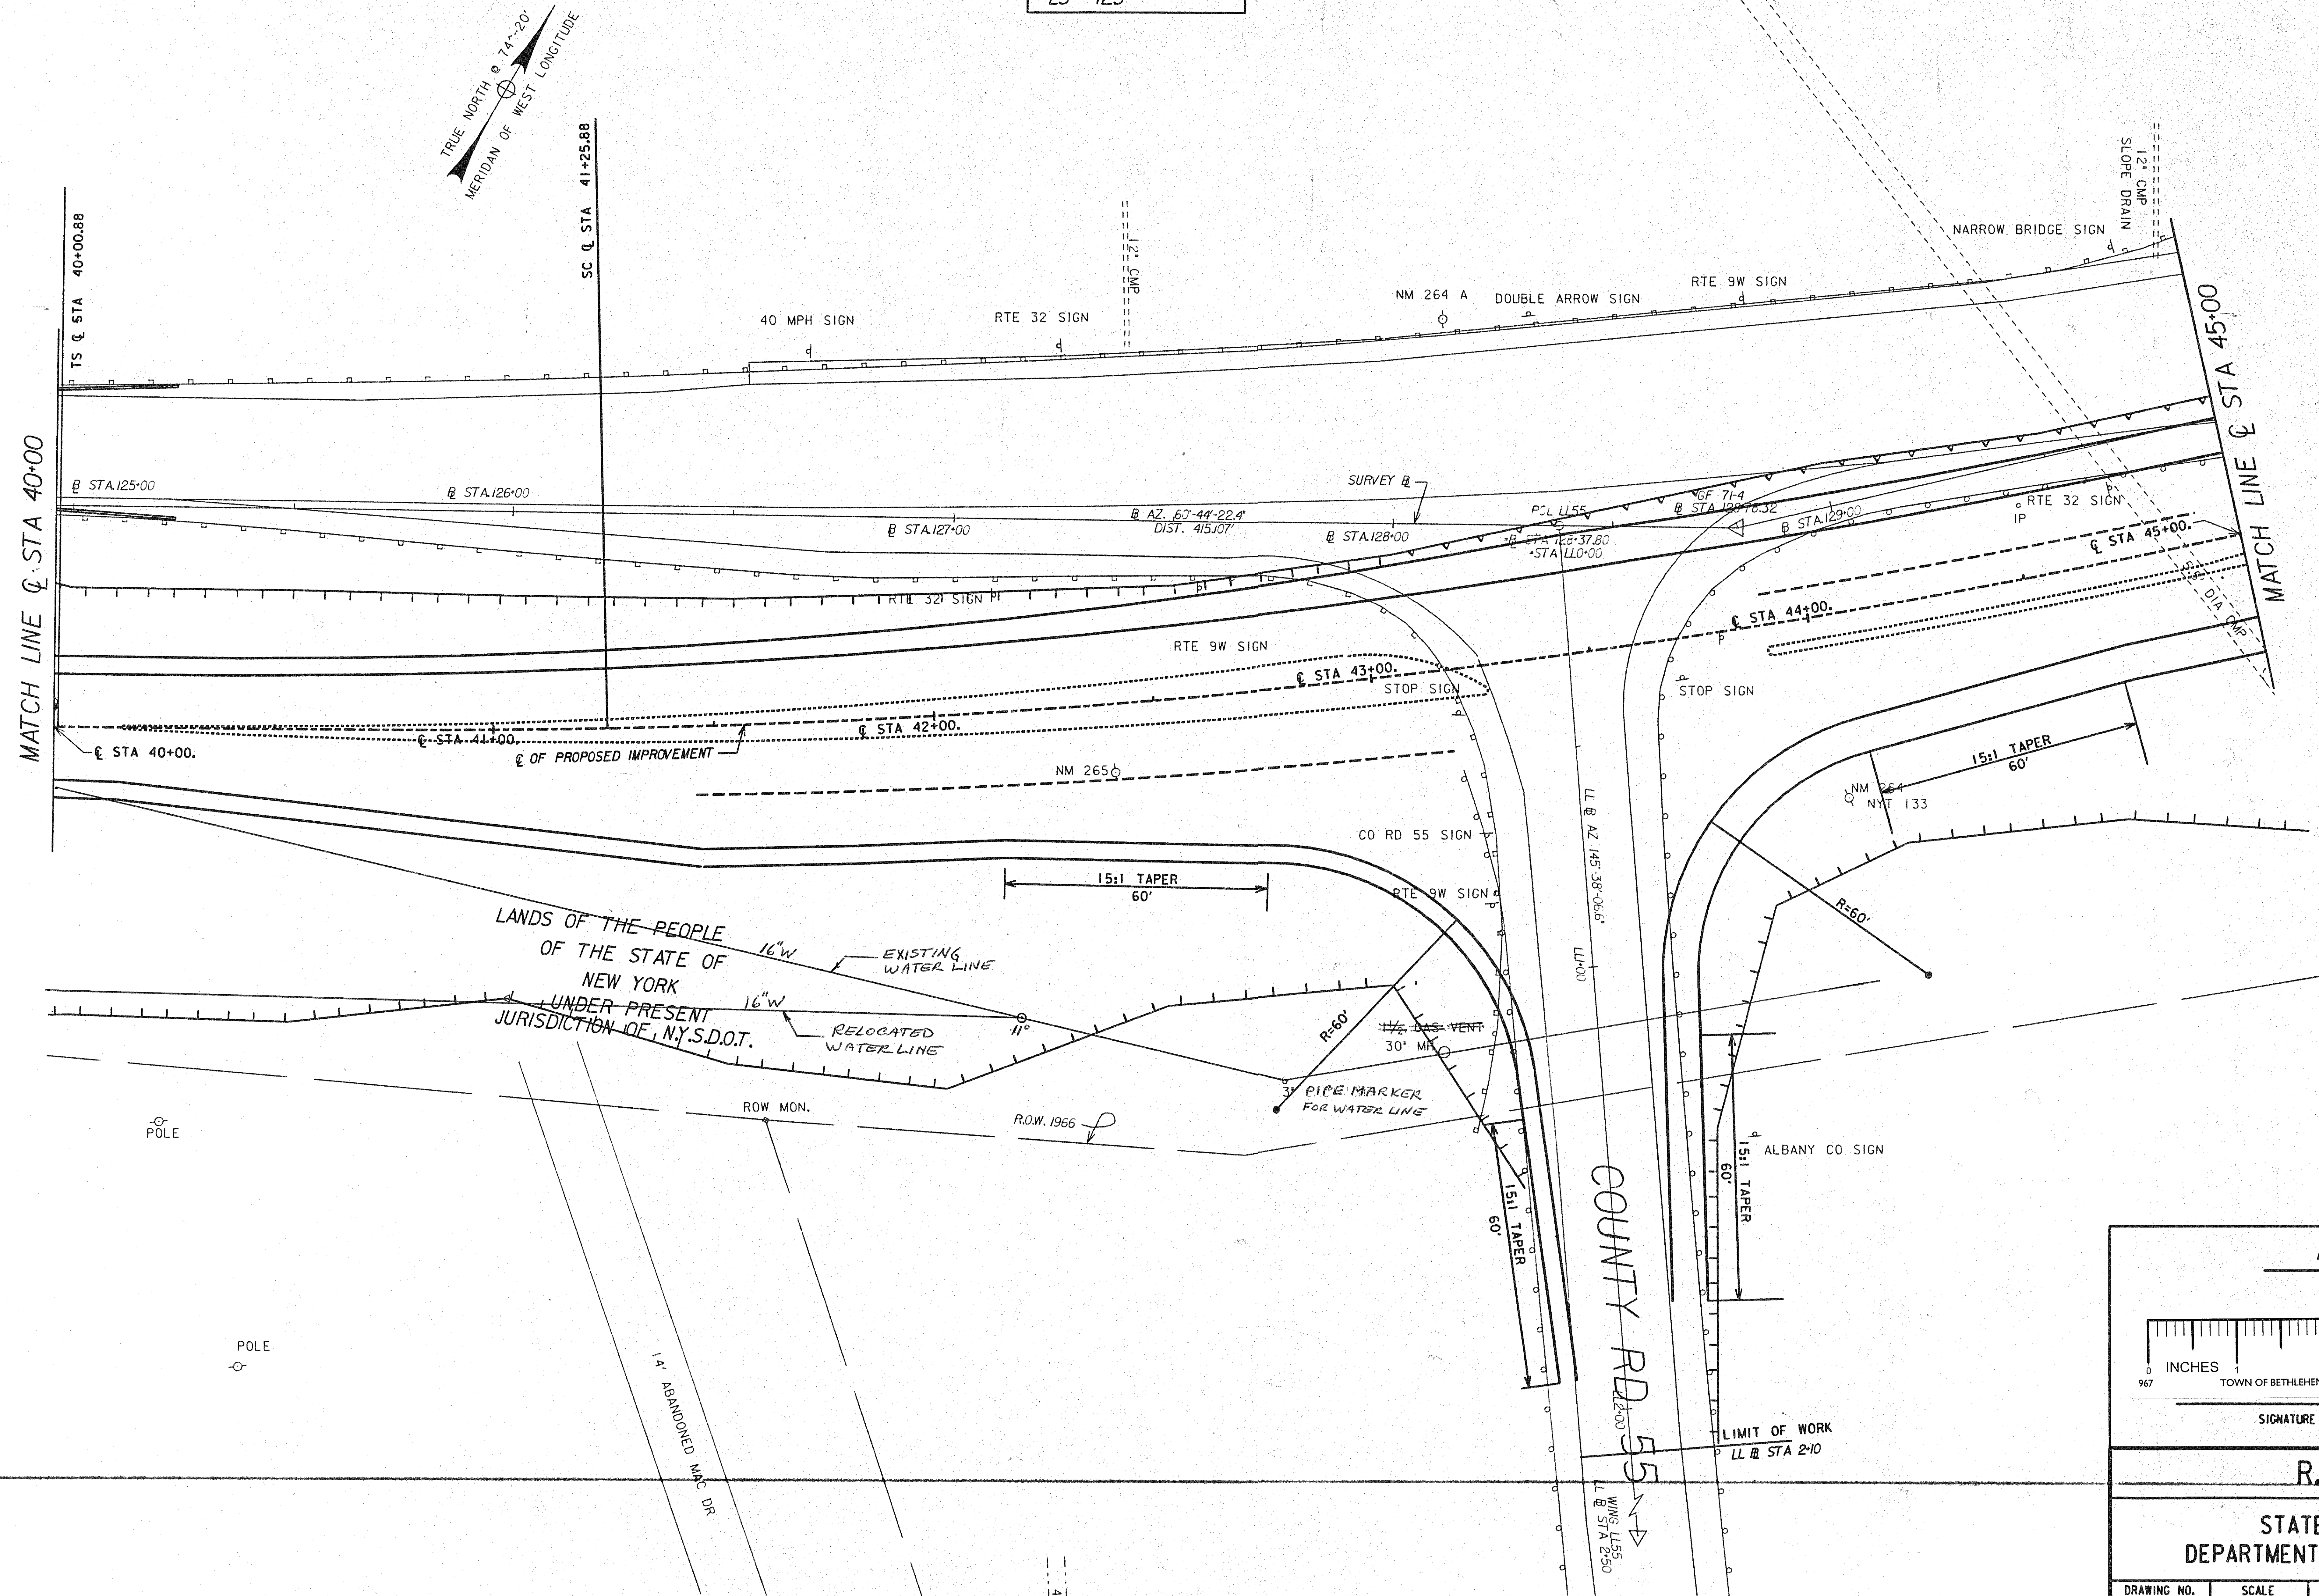

AS-BUILT REVISIONS

0 1 2  
INCHES  
967 TOWN OF BETHLEHEM 16

SIGNATURE

DATE

R.O.W. PLAN

STATE OF NEW YORK  
DEPARTMENT OF TRANSPORTATION

|                    |                   |              |            |
|--------------------|-------------------|--------------|------------|
| DRAWING NO.<br>R-8 | SCALE<br>1" = 20' | DATE<br>8/88 | REGION ONE |
|--------------------|-------------------|--------------|------------|