

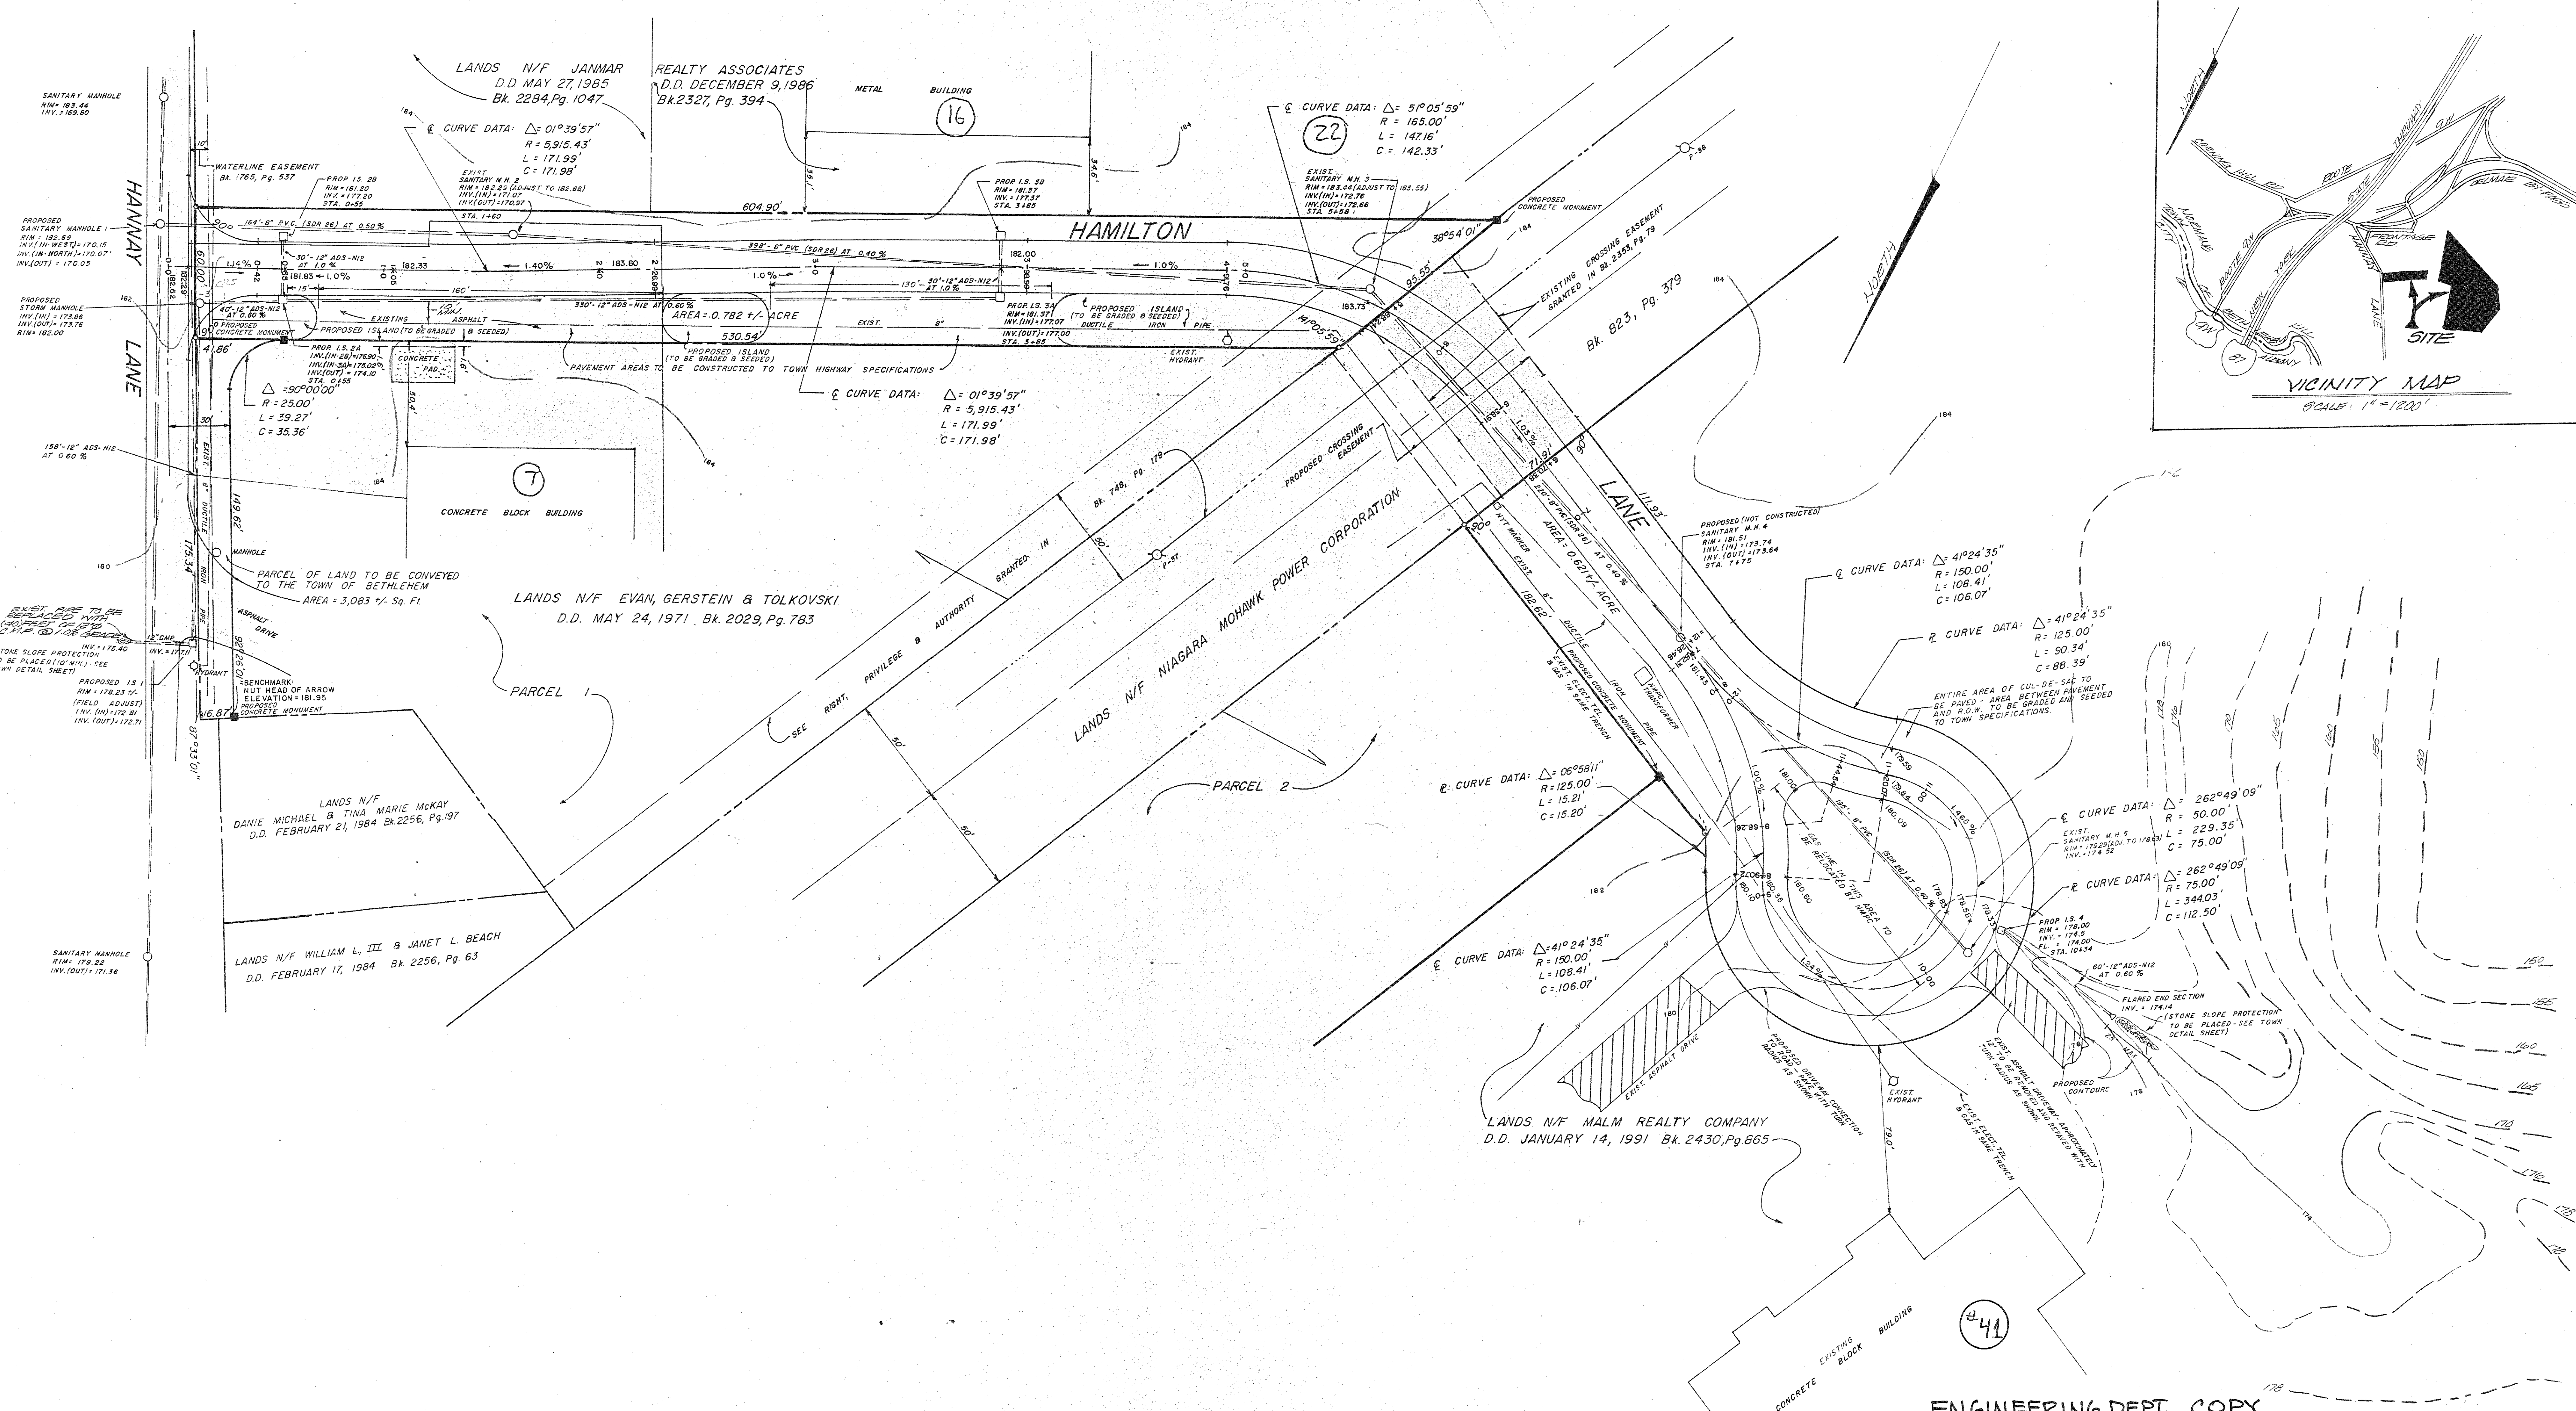


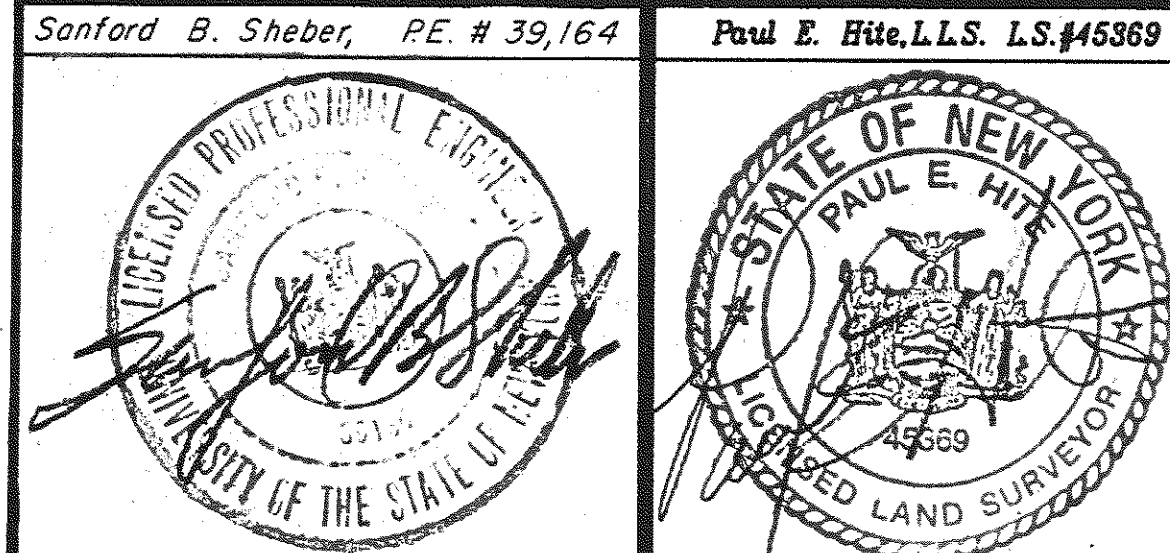

DEVELOPMENT NOTE:
All construction of roadway and installation of utilities to meet requirements of Town of Bethlehem Engineering and Highway Department and Albany County Health Department requirements.

REVISED: MAY 3, 1993 - MISCELLANEOUS REVISIONS PER TOWN REQUIREMENTS.
REVISED: NOVEMBER 2, 1992 -
TYPE OF PIPE REPLACEMENT PIPE FROM 18" TO 24" SHOWN,
MIN. DISTANCE BETWEEN EXISTING CURVE CENTER SHOWN,
REVISED PROPOSED CURVE CENTER SHOWN,
ADDITIONAL CURVES SHOWN & ADJUSTED, MAP ADDED
END OF TOWN OF BETHLEHEM & TOWN OF FREDERICK
SANTARY MANHOLE 1, 2, 1000.

ALBANY COUNTY HEALTH DEPARTMENT APPROVAL

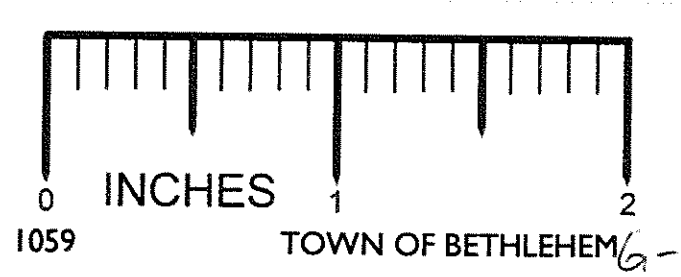

ENGINEERING DEPT. COPY

MAP OF
PROPOSED ROADWAY &
PROPOSED PARCELS OF LAND TO BE
CONVEYED TO THE TOWN OF BETHLEHEM
FOR HIGHWAY PURPOSES
HAMILTON LANE
TOWN OF BETHLEHEM

COUNTY:	ALBANY
STATE:	NEW YORK
SCALE:	1" = 40'
DATE:	OCTOBER 19, 1992
DRAWN BY:	SHW
MAP NO.:	358

MAP PREPARED BY:
PAUL E. HITE
LICENSED LAND SURVEYOR
230 DELAWARE AVENUE
DELMAR, NEW YORK 12054
(518) 439-4989