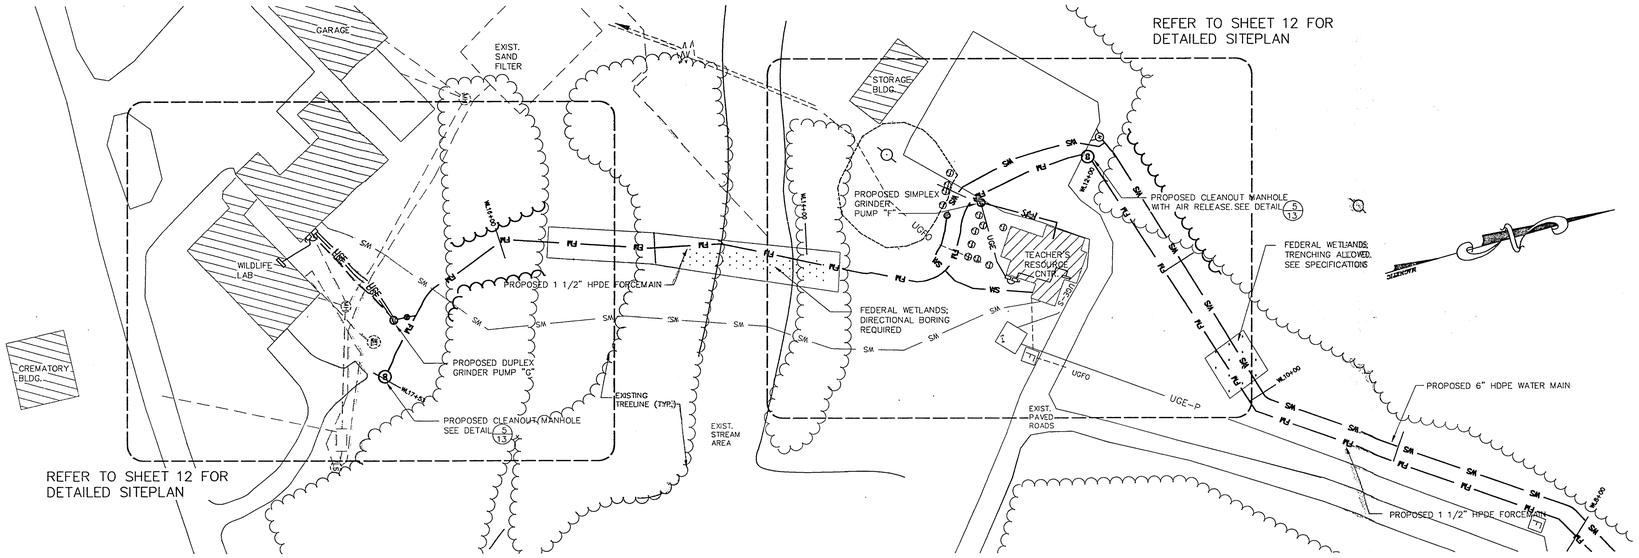

FIVE RIVERS PLAN

SCALE: – 1"=40'

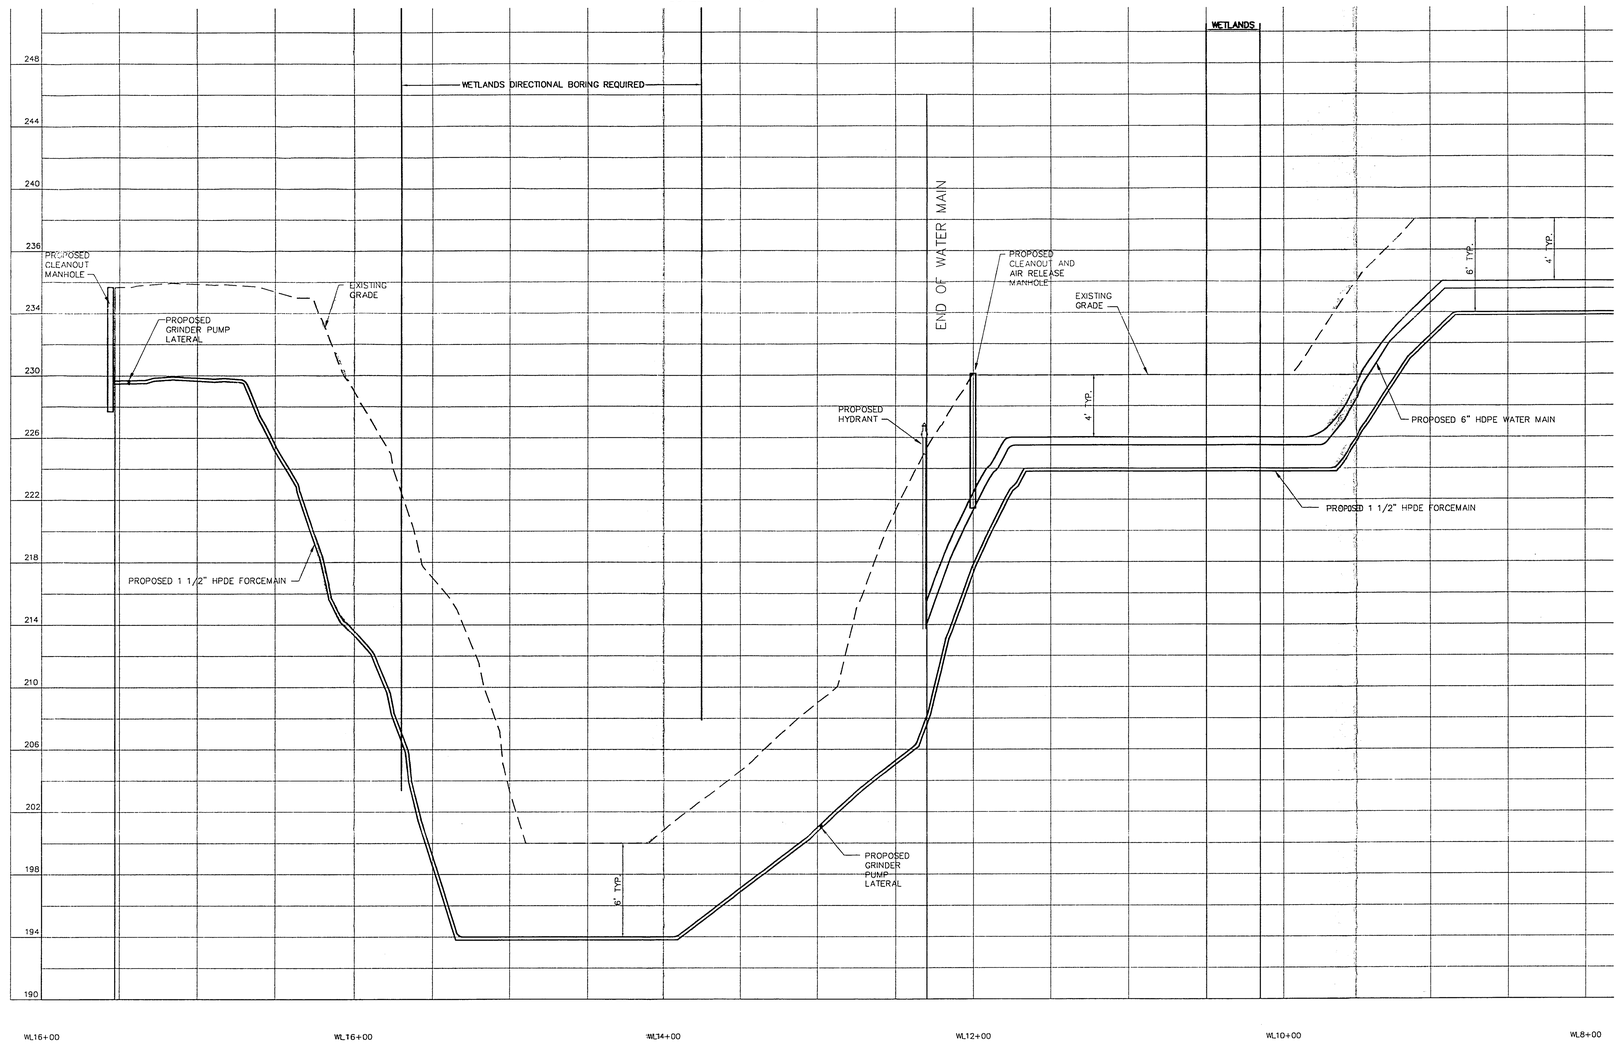

PROFILE I

SCALE: HORIZ.– 1"=40'
VERT.– 1"= 4'

0 INCHES 1 2
2995 TOWN OF BETHLEHEM

NOTES:

NO.	DATE	

STATE OF NEW YORK
DEPARTMENT OF ENVIRONMENTAL CONSERVATION
DIVISION OF OPERATIONS
BUREAU OF DESIGN & CONSTRUCTION

DESIGNED BY
CHECKED BY
DRAWN BY

REVISIONS

NO.	DATE	DESCRIPTION	BY
		AS BUILT	

PROJECT DESCRIPTION
FIVE RIVERS ENVIRONMENTAL EDUCATION CENTER
MUNICIPAL SEWAGE AND WATER CONNECTION

FIVE RIVERS PLAN & PROFILE I

FACILITY NAME	FIVE RIVERS ENV. EDUCATION CENTER
FACILITY NO.	2515
PROJECT NO.	97–2789
DATE	AUGUST, 2001
SCALE	AS NOTED
DRAWING NO.	5