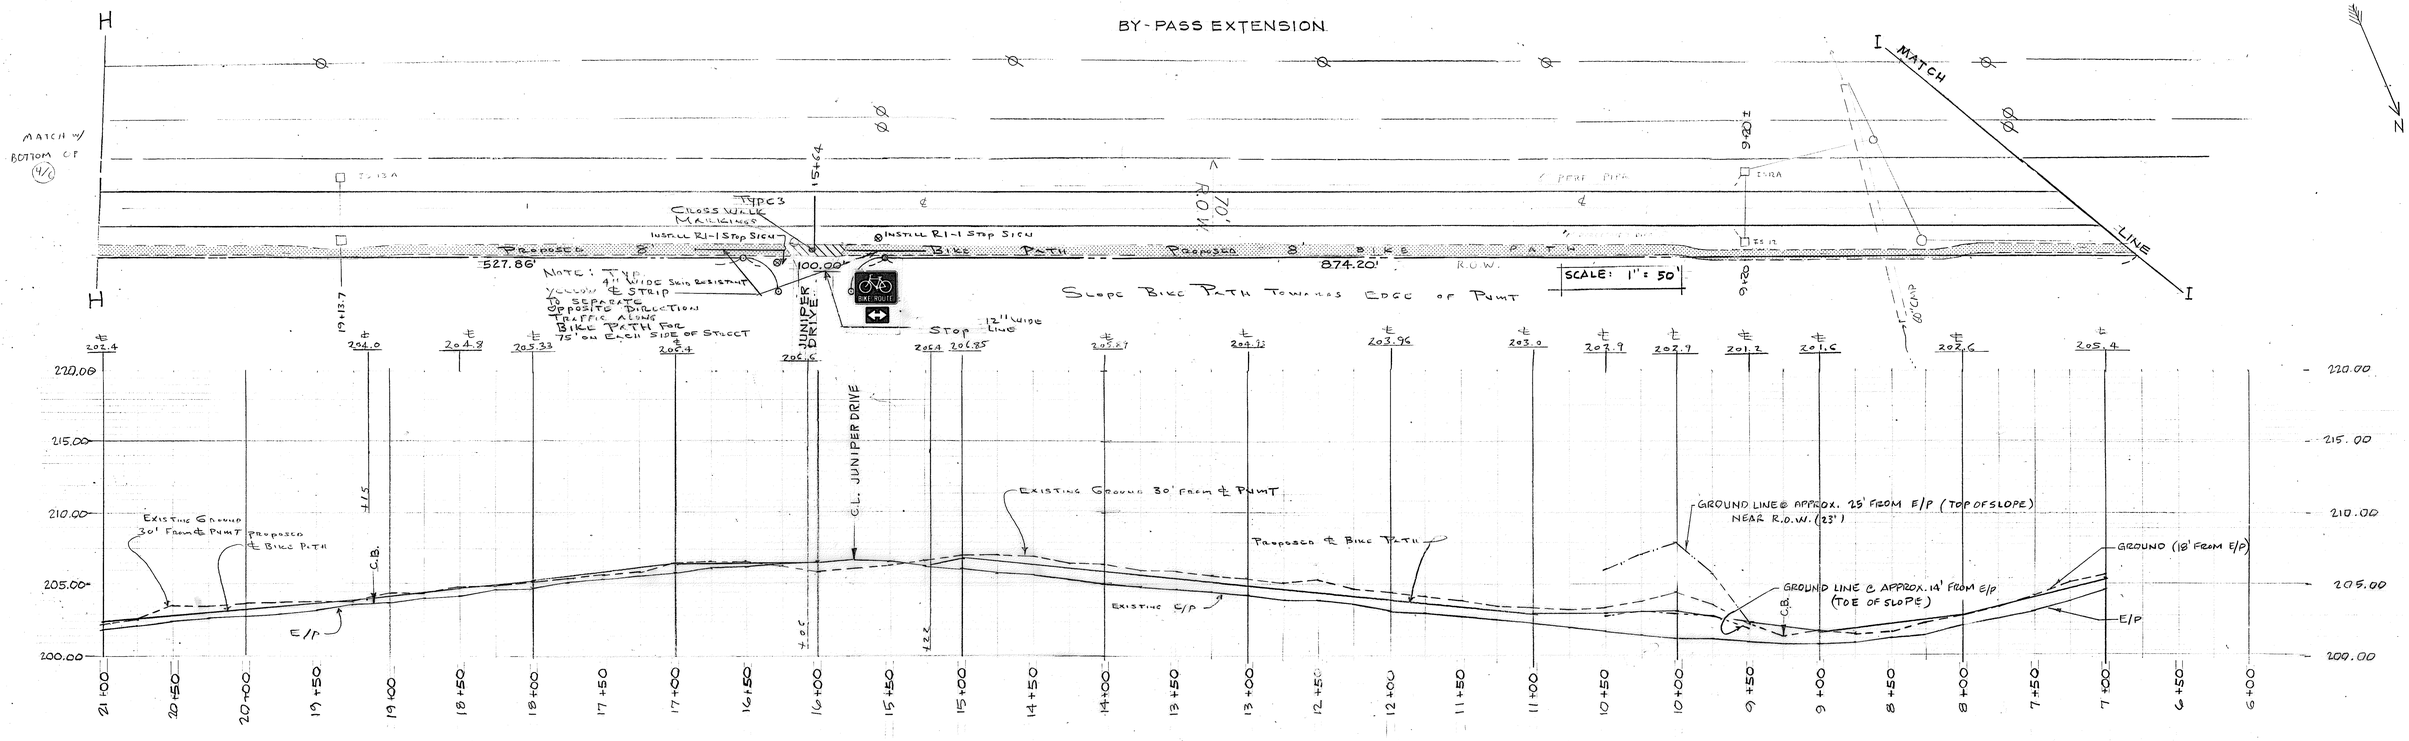

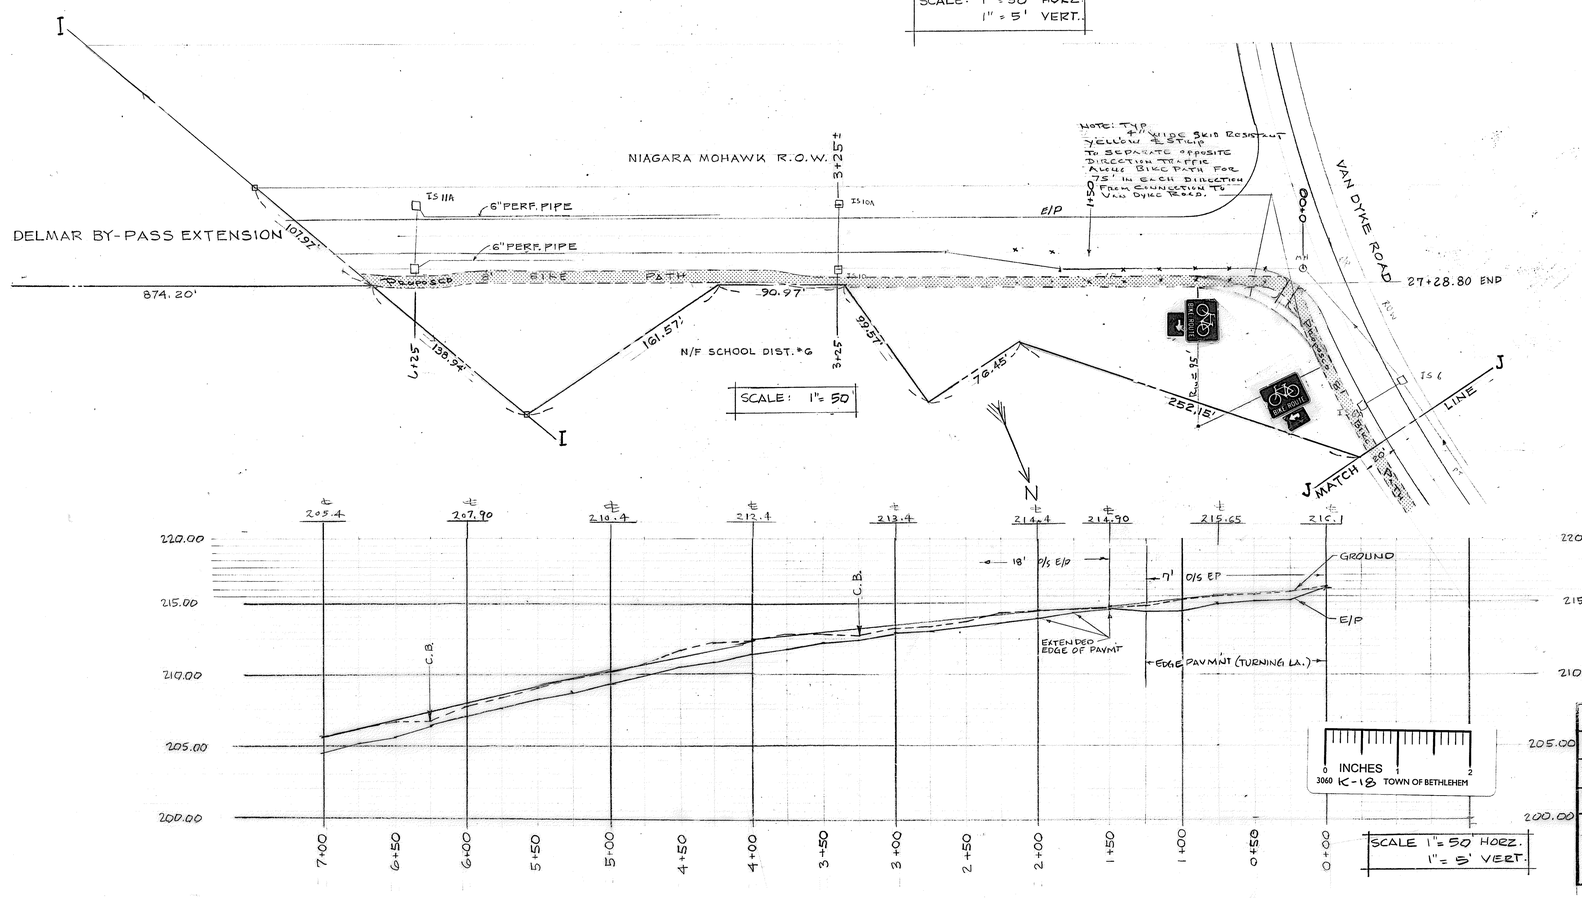

REVISED SEPT. 3, 1998 RECORD PLAN

REVISED: FEB. 26, 1996 AND MAY 23, 1996 AS PER N.Y.S.D.O.T. COMMENTS OCT. 4 1996 - TOTAL SHEETS

SCALE. AS SHOWN	DELMAR BY-PASS EXTENSION BIKE PATH
DRAWN BY. M.G.	
APPROVED. M.J.C.	
DATE. 10/31/95	
TOWN OF BETHLEHEM ENGINEERING DEPARTMENT 445 DELAWARE AVE. DELMAR, NEW YORK 12054	DRAWING NUMBER. 2 OF 7