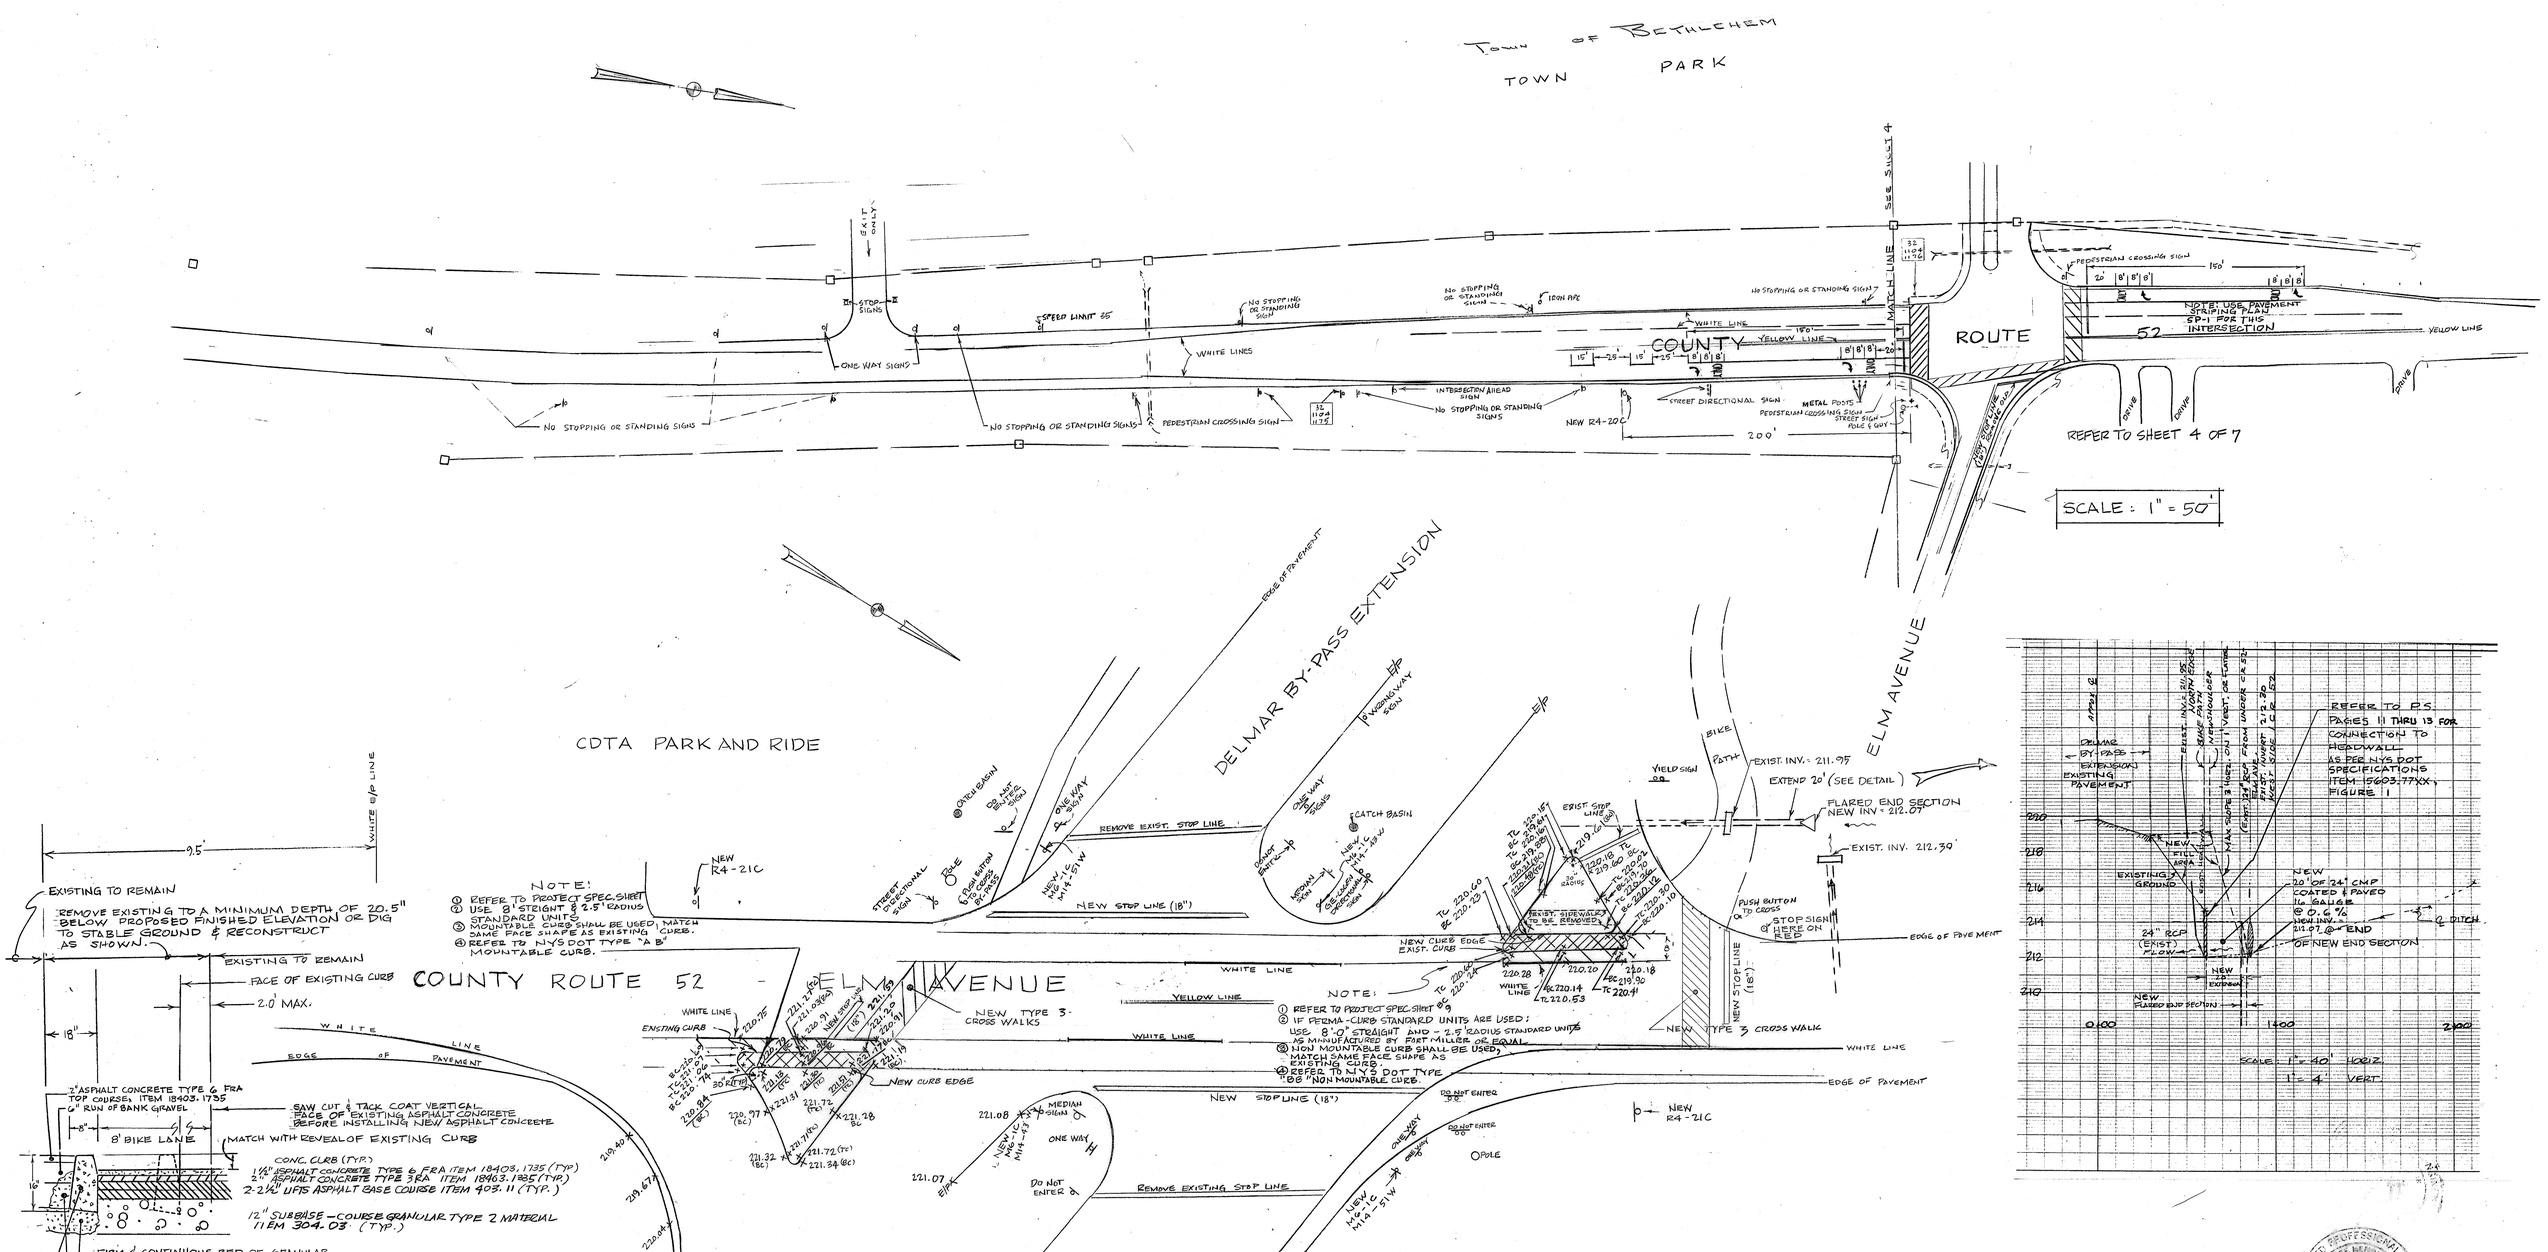

REVISED:
JAN. 15, 1997 AS PER ALB. CO. DPW
FEB. 13, 1997 AS PER ALB. CO.
MAR. 17, 1997 - NOTE SP-1 ADDED
SEPT. 3, 1998 - RECORD PLAN

SCALE AS SHOWN	ELM AVE. BIKE PATH
DRAWN BY	
APPROVED	
DATE 10/9/96	
TOWN OF BETHLEHEM ENGINEERING DEPARTMENT 445 DELAWARE AVE. DELMAR, NEW YORK 12054	DRAWING NUMBER 4A OF 7