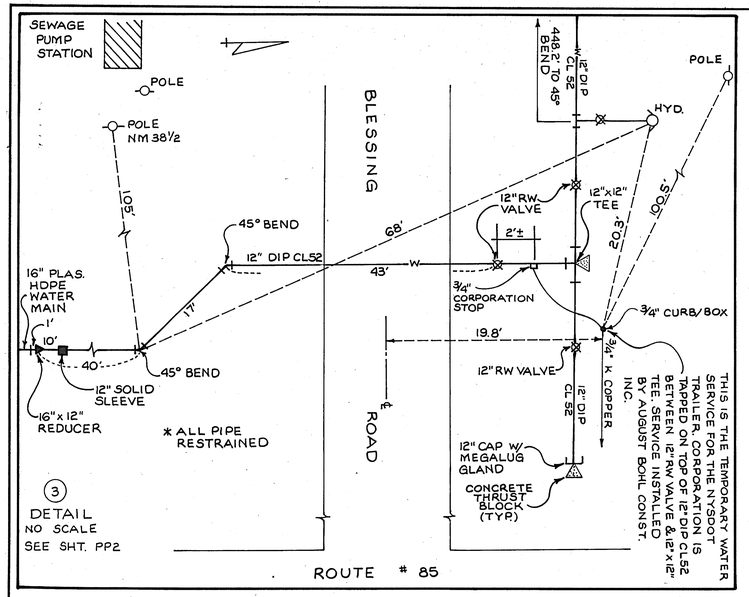

3
DETAIL
NO SCALE
SEE SHT. PP2

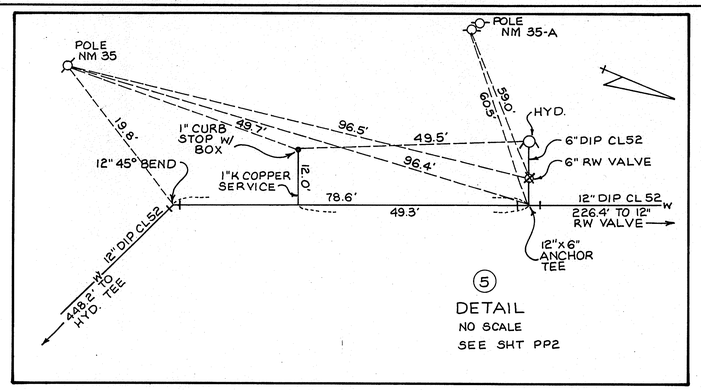

5
DETAIL
NO SCALE
SEE SHT PP2

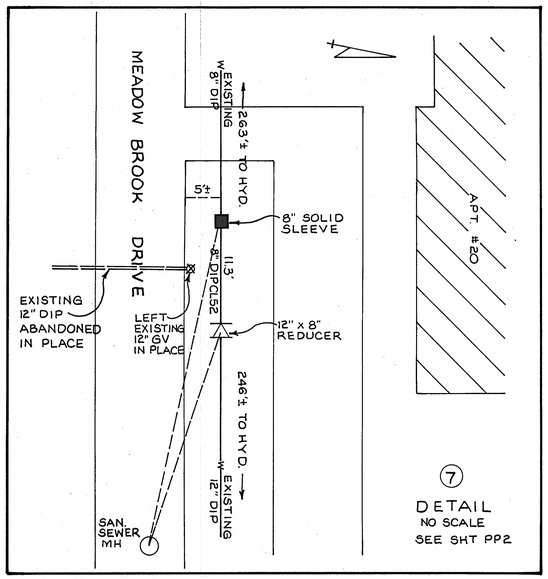

7
DETAIL
NO SCALE
SEE SHT PP2

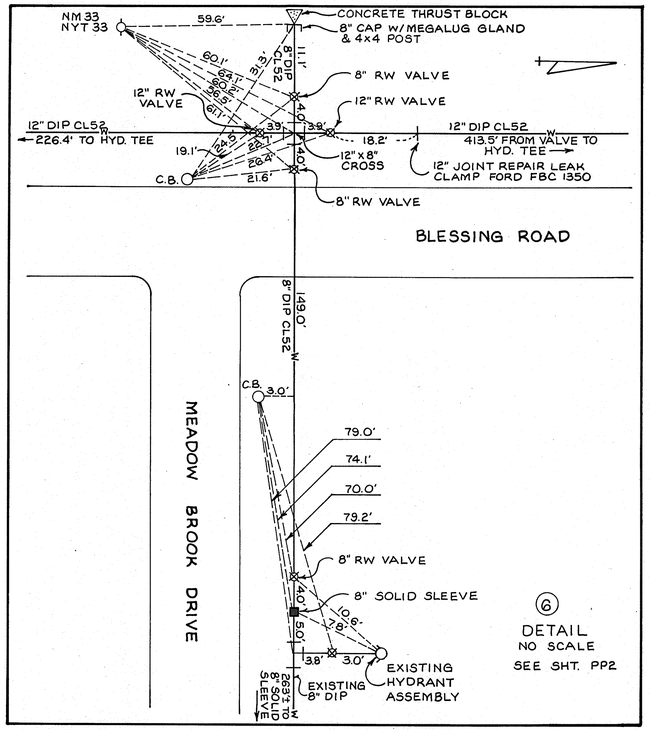

6
DETAIL
NO SCALE
SEE SHT. PP2

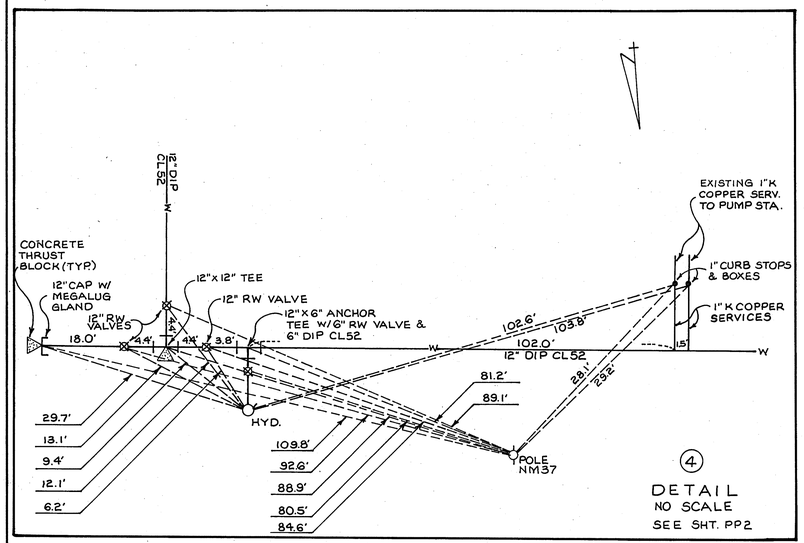

4
DETAIL
NO SCALE
SEE SHT. PP2

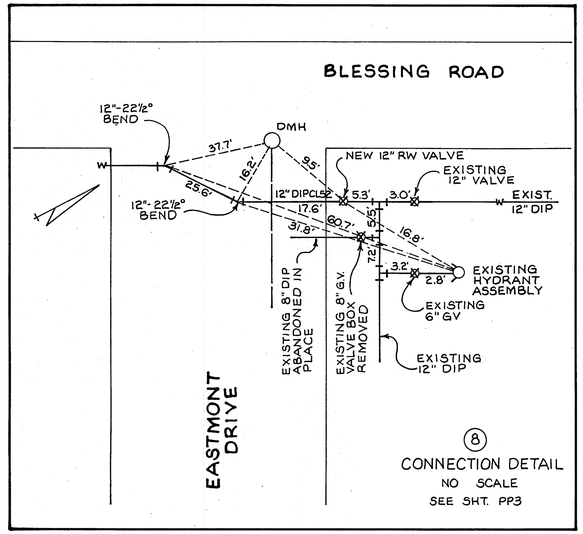

8
CONNECTION DETAIL
NO SCALE
SEE SHT. PP3

RECORD DRAWING

DATE	RECORD OF WORK	Drawn	Check	Appr.
9/13/00	RECORD DATA ADDED	MD		

INCHES 0 1 2
3736 R-5 TOWN OF BETHLEHEM

DRAWN BY MD | CHECKED BY

DETAILS **D1**

TRANSMISSION MAIN - NORTH BETHLEHEM
SLINGERLANDS BYPASS TO EASTMOUNT DRIVE

TOWN OF BETHLEHEM | COUNTY OF ALBANY, NEW YORK
SCALE: AS SHOWN | DATE: SEPT. 13, 2000

C.T. MALE ASSOCIATES, P.C.
50 Century Hill Drive, P.O. Box 727, Latham, NY 12110
(518)785-0976
Engineering Surveying Architecture Landscape Architecture
Laboratory Services Computer Services

APPROVED BY | PROJ. NO. 98.8693 | FILE NO. 00-522

SHEET 5 OF 5

UNAUTHORIZED ALTERATION OR ADDITION TO THIS DOCUMENT IS A VIOLATION OF SECTION 7209 SUBDIVISION 2 OF THE NEW YORK STATE EDUCATION LAW.

BRUNING 44-132 68459