


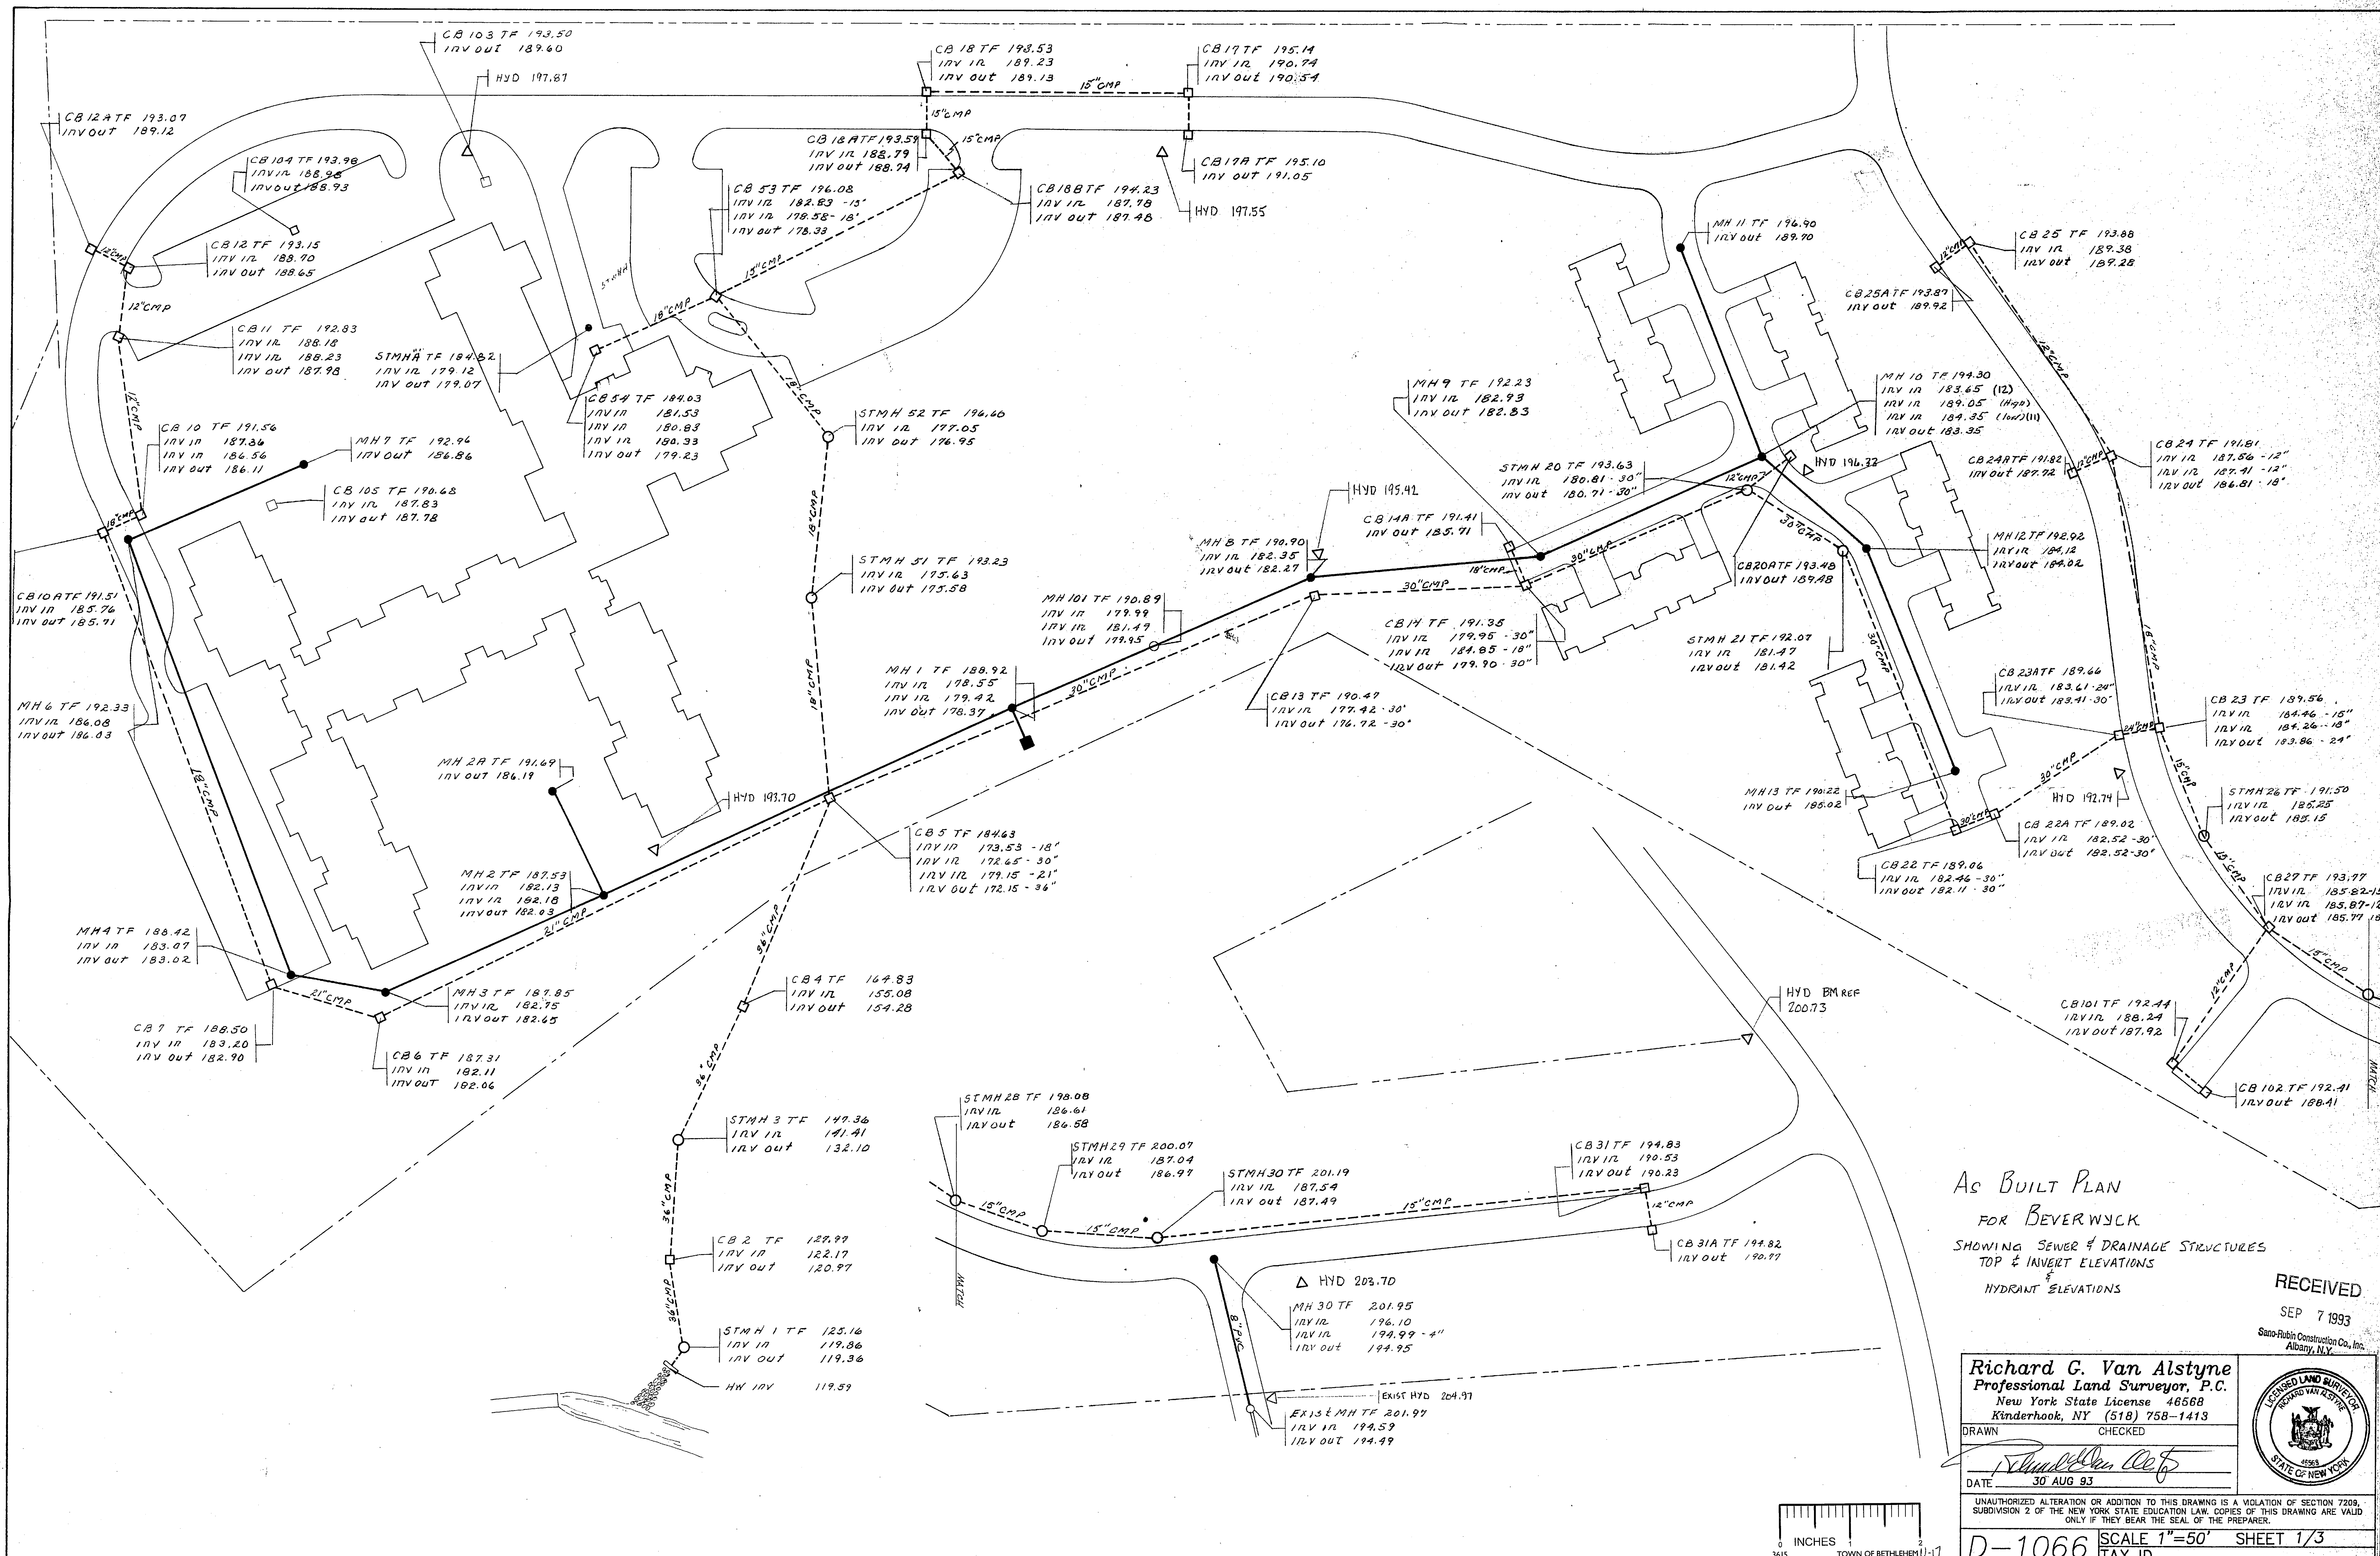

As BUILT PLAN
FOR BEVERWYCK
SHOWING SEWER & DRAINAGE STRUCTURES
TOP & INVERT ELEVATIONS
& HYDRANT ELEVATIONS

RECEIVED
SEP 7 1993
Sano-Rubin Construction Co., Inc.
Albany, N.Y.

Richard G. Van Alstyne
Professional Land Surveyor, P.C.
New York State License 46568
Kinderhook, NY (518) 758-1413



DRAWN: [Signature]
CHECKED: [Signature]
DATE: 30 AUG 93

UNAUTHORIZED ALTERATION OR ADDITION TO THIS DRAWING IS A VIOLATION OF SECTION 7209, SUBDIVISION 2 OF THE NEW YORK STATE EDUCATION LAW. COPIES OF THIS DRAWING ARE VALID ONLY IF THEY BEAR THE SEAL OF THE PREPARER.
D-1066 SCALE 1"=50' SHEET 1/3
TAX ID

