


BETHLEHEM CENTRAL SCHOOL DISTRICT BETHLEHEM HIGH SCHOOL ADDITIONS AND ALTERATIONS

Project Title

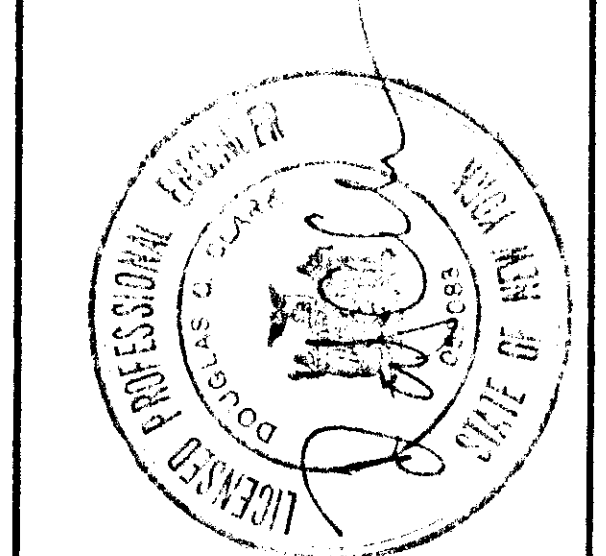

No.	Date	Revision	By
1			
2			
3			


Drawn By: THF	Checked By: THF
Proj # 01-05-05-00-006-004	Proj # 01-05-05-00-006-004
CSA Project # 0072-00	CSA Project # 0072-00
Issue 1.17.04	Issue 1.17.04

SITE
UTILITIES
PLAN
SOUTH

Sheet No.
C107

NOTE:
1. COORDINATE PIPE INSTALLATION WITH SHEETING. PIPE TO BE
INSTALLED INSIDE OF SHEETING. EMPLOY TEMPORARY PIPE AS
NECESSARY TO MAINTAIN EXISTING UTILITIES UNDISTURBED.
COORDINATE WITH PC FOR LOCATIONS OF PIPES FOR INSIDE
STORY CONNECTIONS.

Highway Line Per
Liber 2397, P. 547

 

GRAPHIC SCALE

0' 10' 20' 30' 40' 50' 60' 70' 80' 90' 100'

433 V - 27 TOWN OF BETHLEHEM

SAN-H45
TF=223.00
INV=214.50
SLIP LINE EXISTING
CONNECTION TO ST-H44