
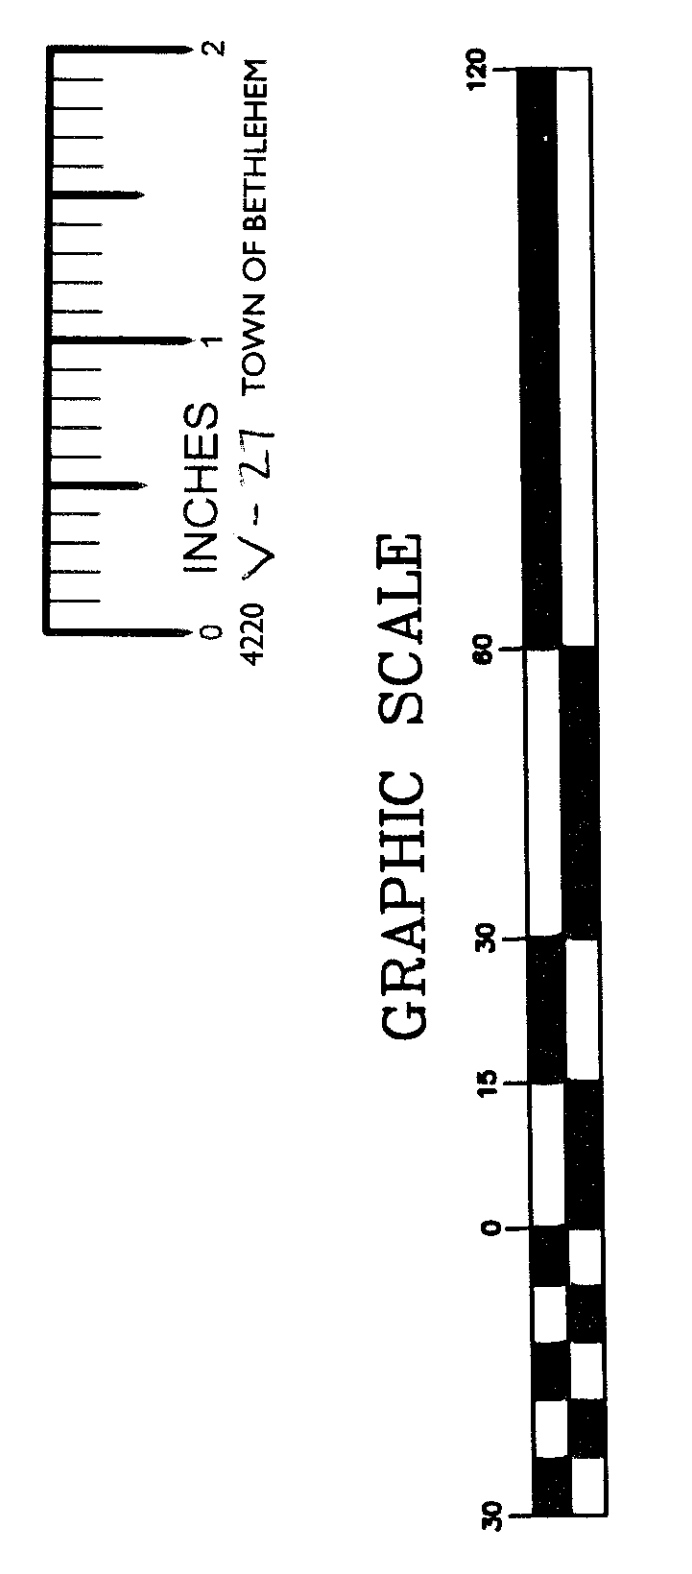
 


BETHLEHEM CENTRAL SCHOOL DISTRICT TRANSPORTATION DEPARTMENT NEW CONSTRUCTION, ADD'S, ALTERS, AND SITEWORK

No.	Date	Revision	By
1	10/23/21	Issue for Bid	JK
2	10/27/21	Issue for Bid	JK

Sheet Title
**VAN DYKE RD
WATER MAIN
RECORD
PLAN**

Sheet No. **TR
C107R
RECORD**
CONSTRUCTION DOC.

 

S.E.D. PROJECT CONTROL NUMBERS:
BUS GARAGE: 01-03-06-06-5-010-008
BUS WASH: 01-03-06-06-5-027-001

COMPILED BY: ALL RIGHTS RESERVED