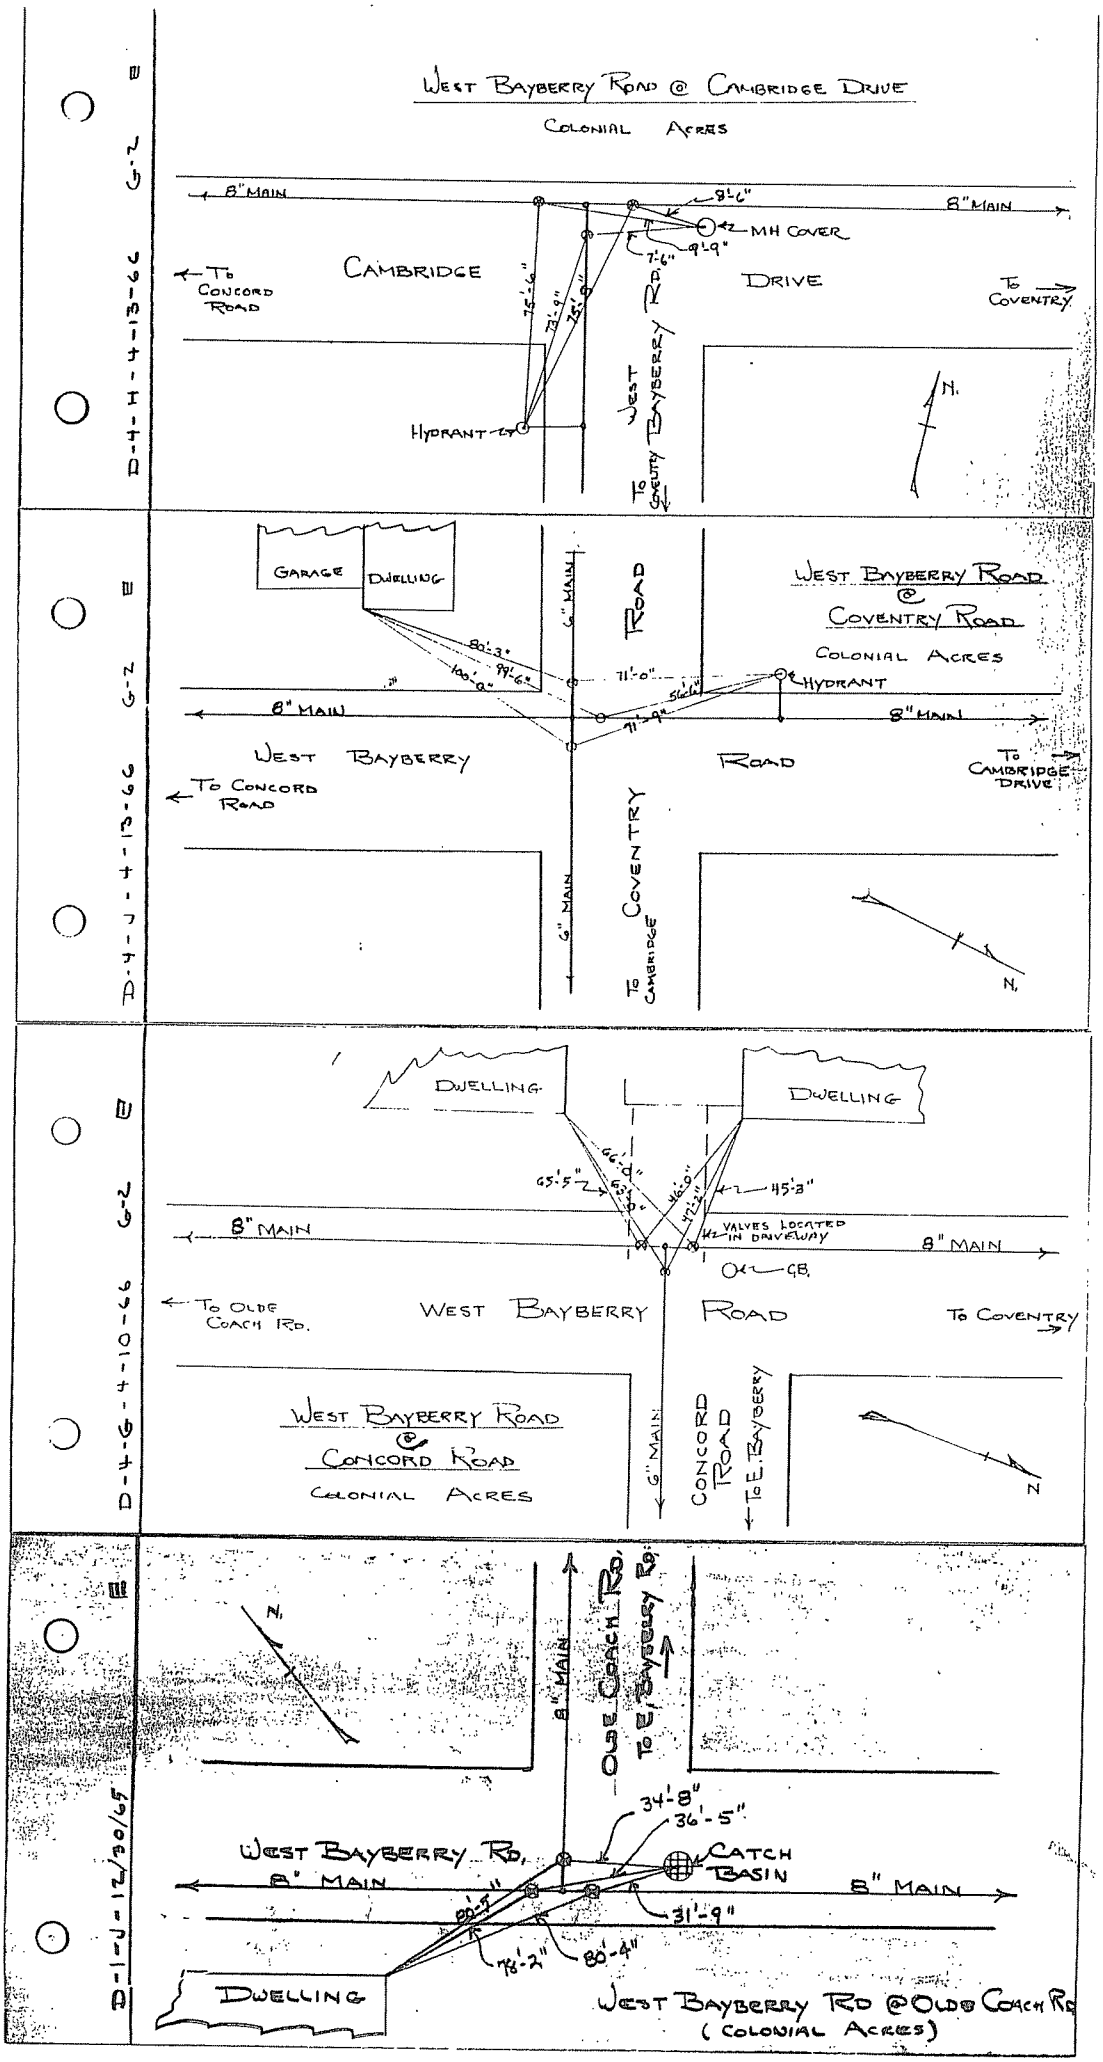

BAYBERRY ROAD - WEST

WATER MAIN