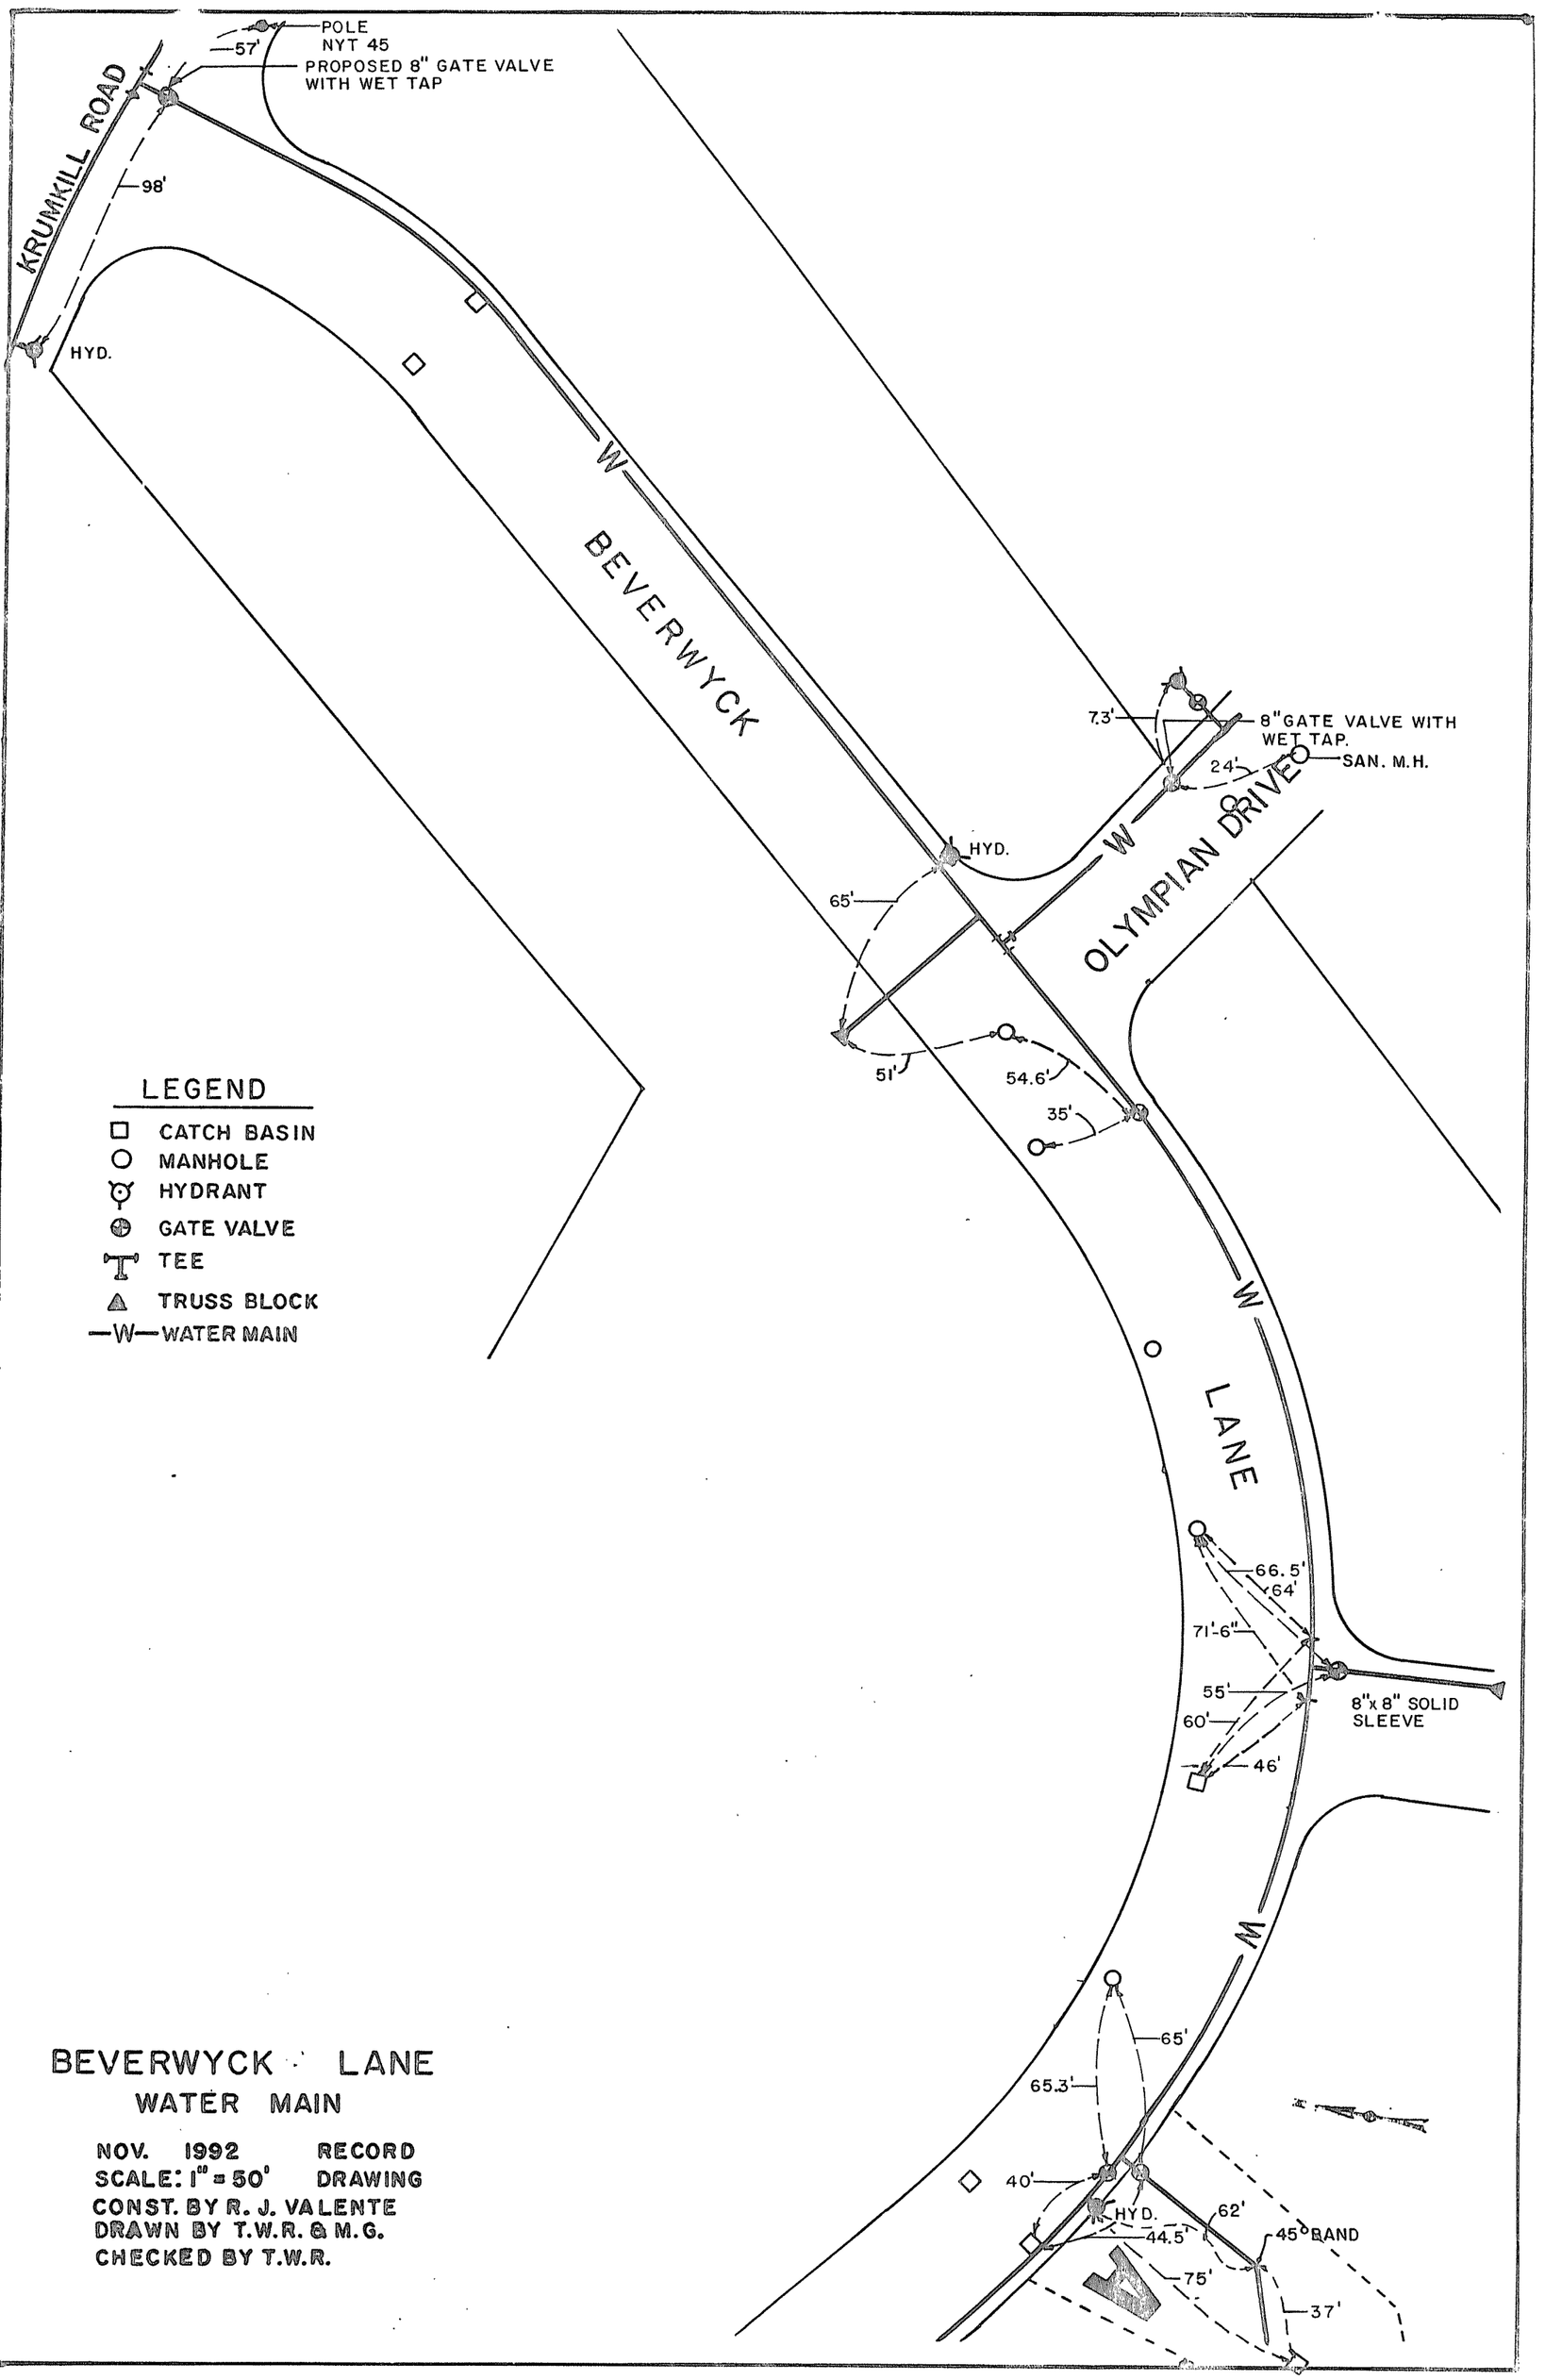
POLE
NYT 45
57'
PROPOSED 8" GATE VALVE
WITH WET TAP
KRUMKILL ROAD
98'
HYD.
W
BEVERWYCK
7.3'
8" GATE VALVE WITH
WET TAP.
24'
SAN. M.H.
W
OLYMPIAN DRIVE
HYD.
65'
51'
54.6'
35'
LEGEND
CATCH BASIN
MANHOLE
HYDRANT
GATE VALVE
TEE
TRUSS BLOCK
—W— WATER MAIN
W
LANE
66.5'
64'
71'-6"
55'
60'
46'
8"x 8" SOLID
SLEEVE
W
65'
65.3'
40'
HYD.
44.5'
62'
45° BAND
75'
37'
BEVERWYCK LANE
WATER MAIN
NOV. 1992 RECORD
SCALE: 1" = 50' DRAWING
CONST. BY R. J. VALENTE
DRAWN BY T.W.R. & M.G.
CHECKED BY T.W.R.