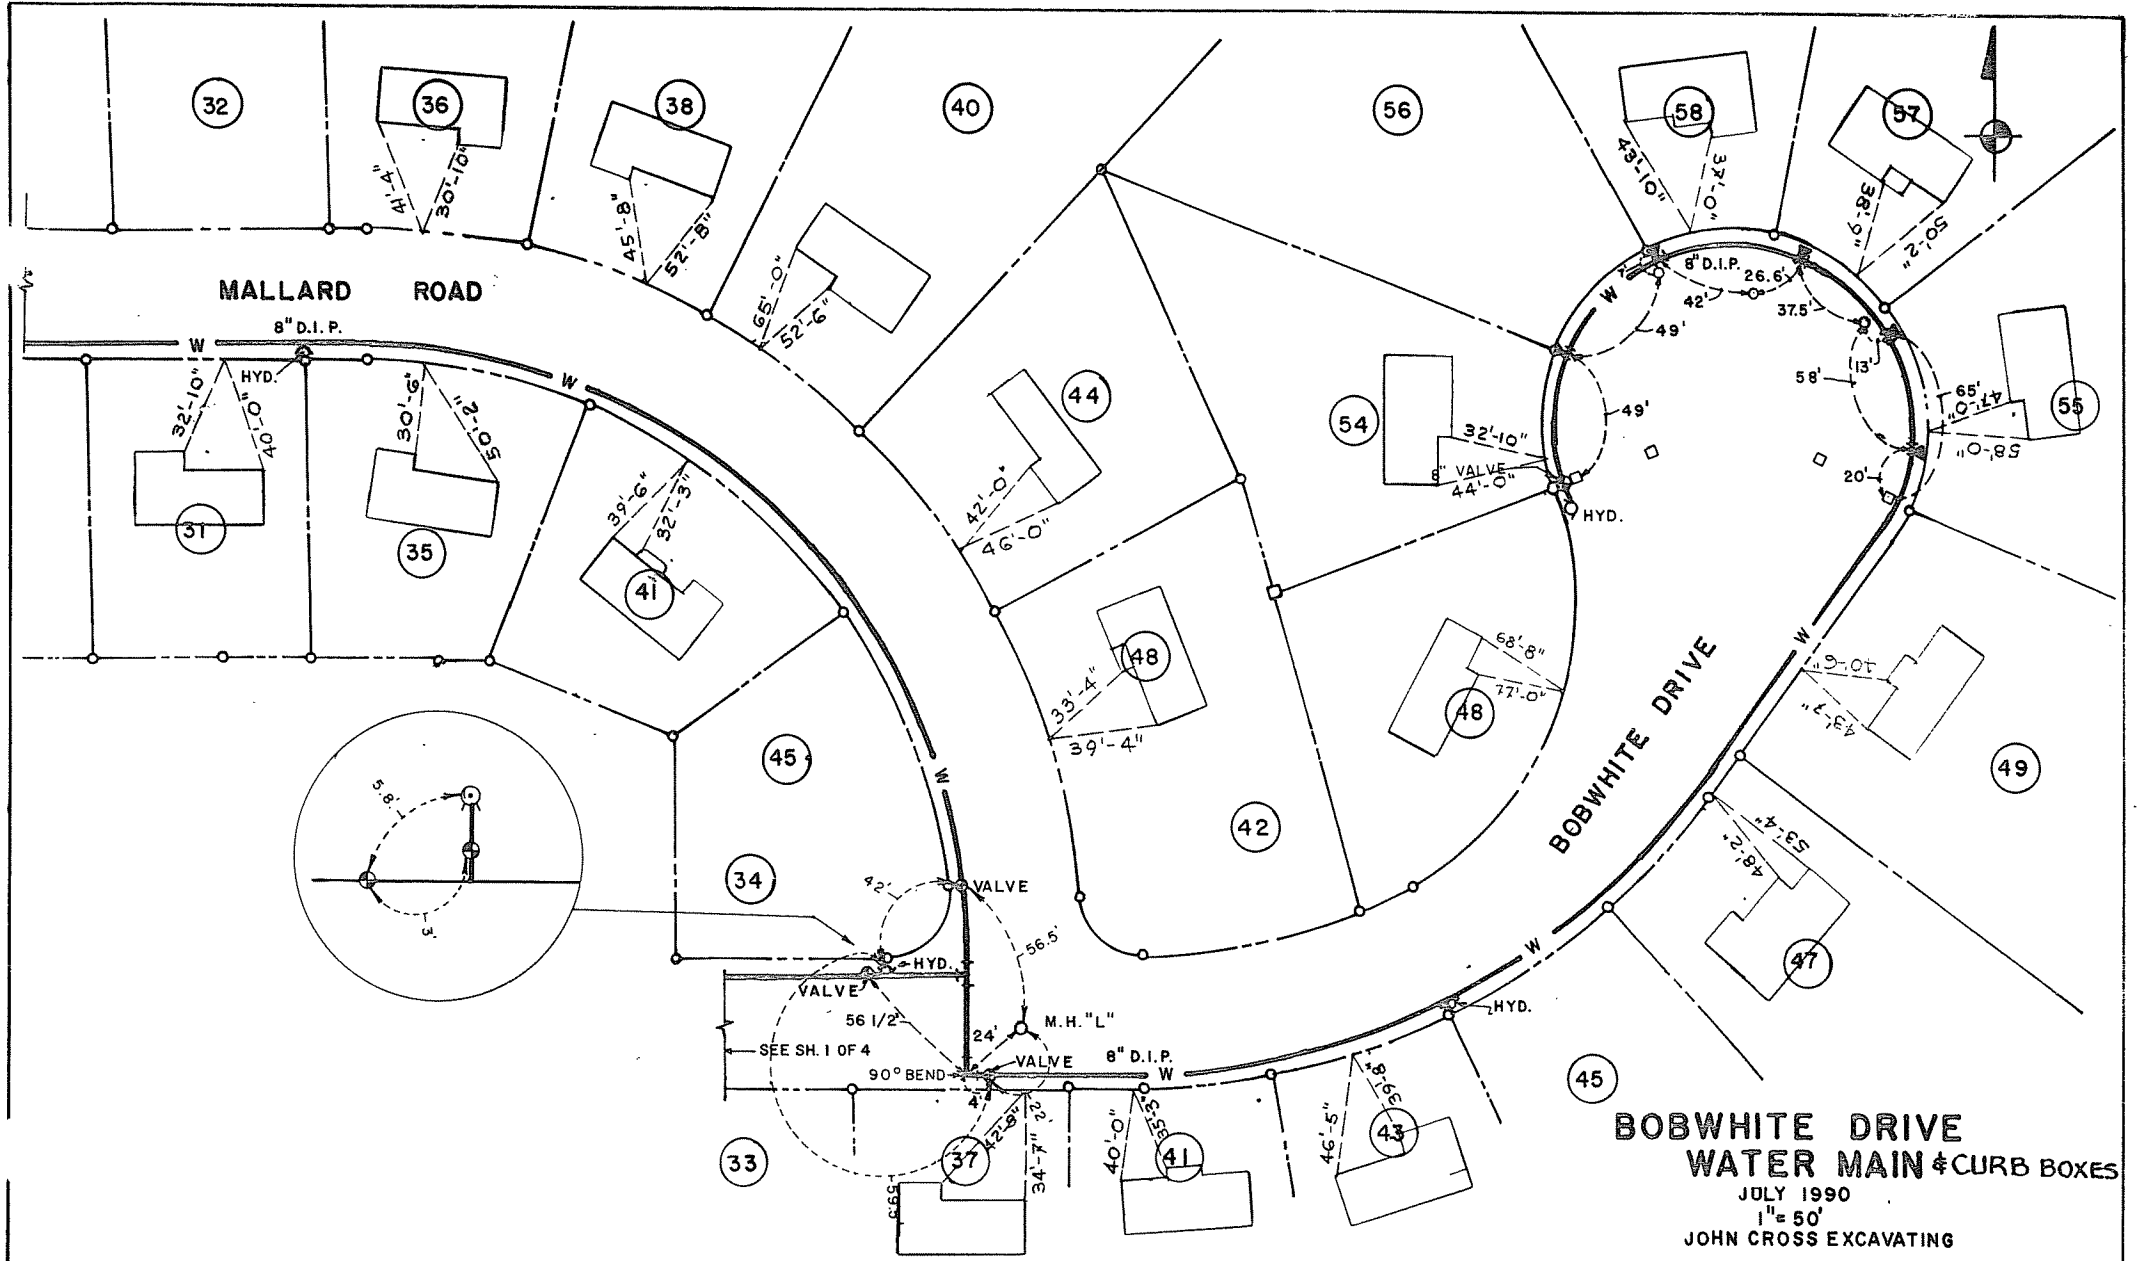

BOBWHITE DRIVE
WATER MAIN & CURB BOXES

JULY 1990
1" = 50'
JOHN CROSS EXCAVATING

DRAWN BY: M. G.
CHECKED BY: D.M.S.