 
BOYLSTON DRIVE