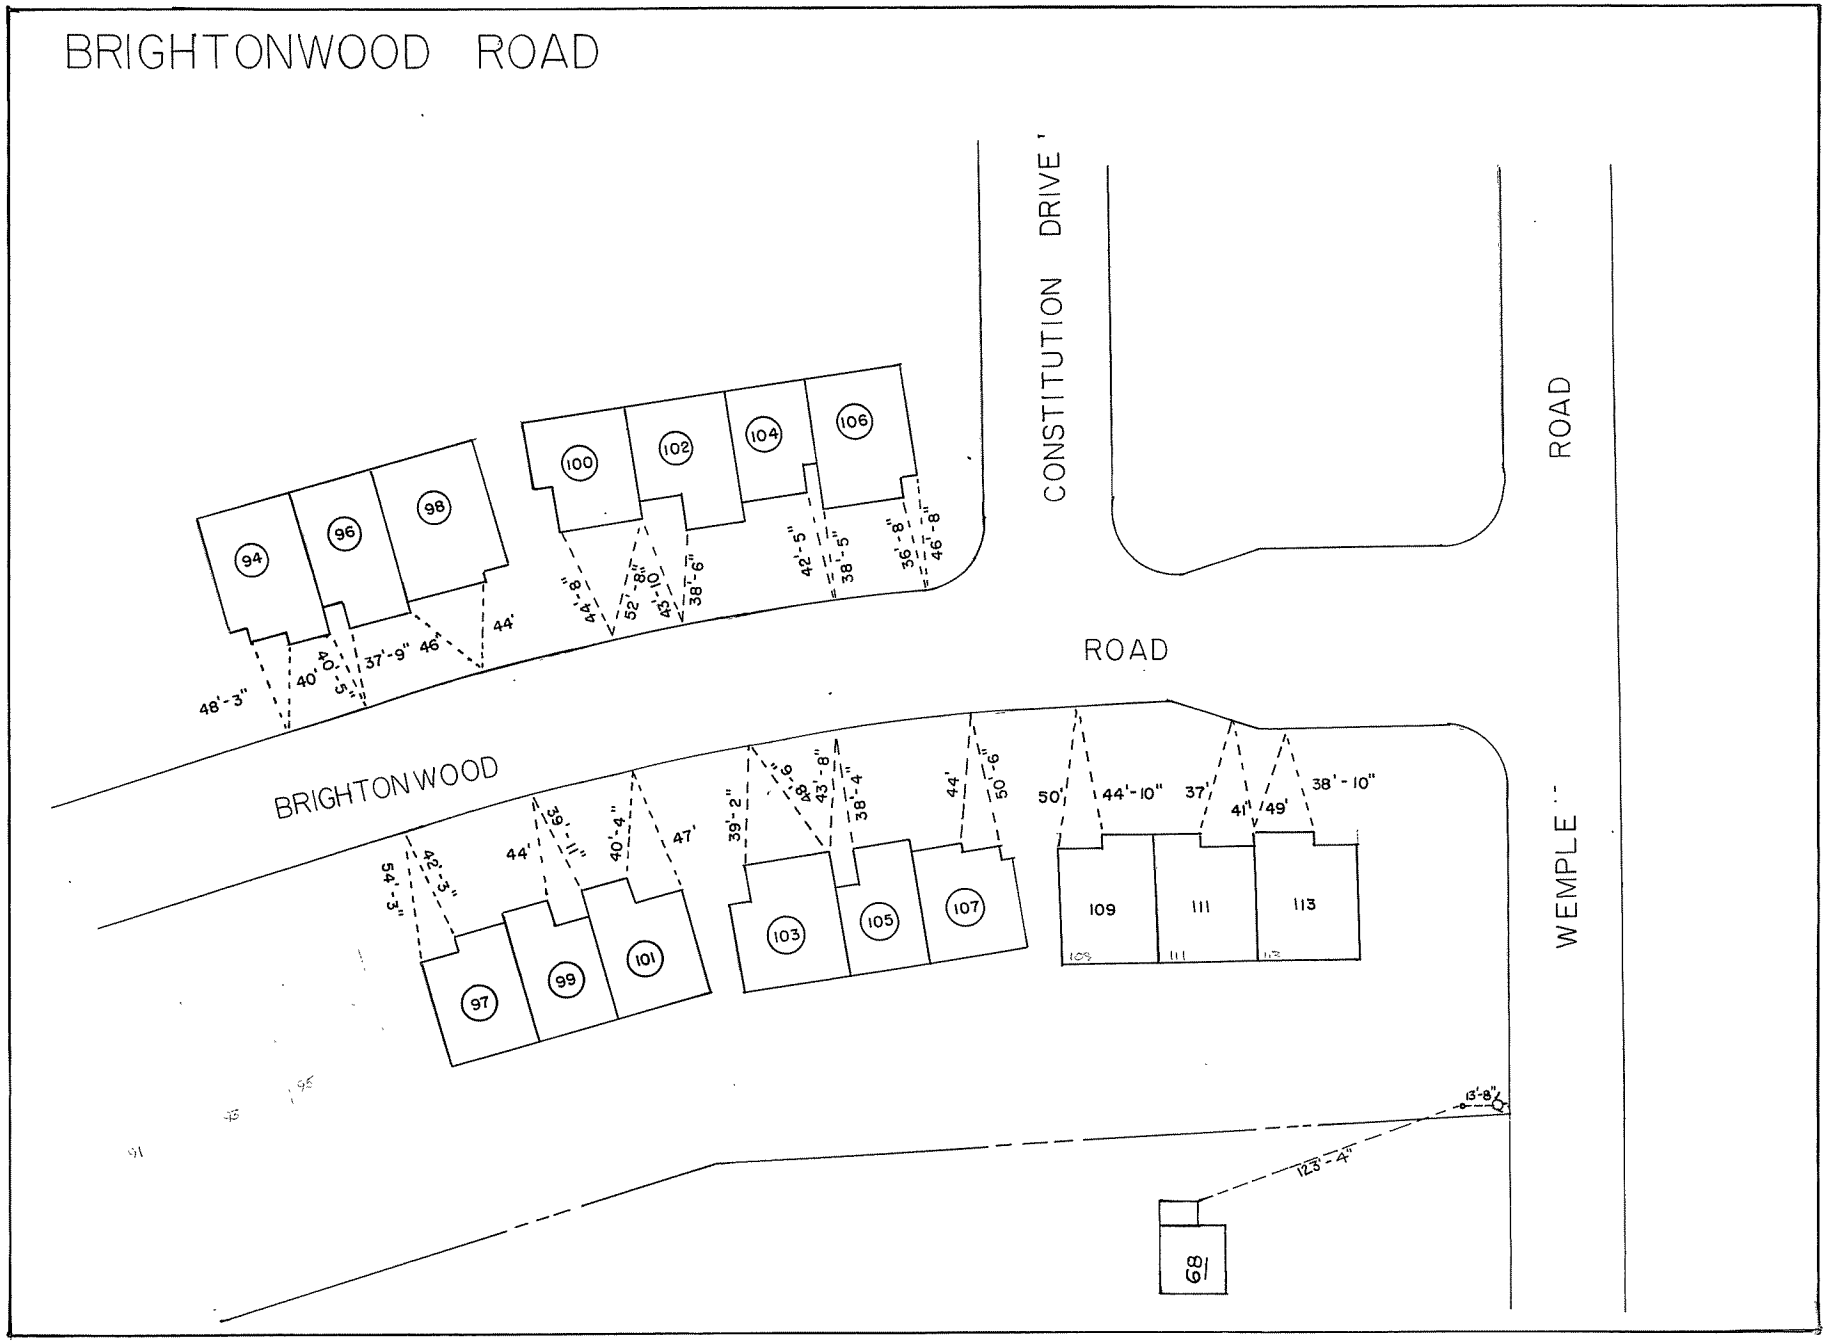
BRIGHTONWOOD ROAD
CONSTITUTION DRIVE
ROAD
WEMPLE
BRIGHTONWOOD ROAD
94
96
98
100
102
104
106
97
99
101
103
105
107
109
111
113
68
48'-3"
40'
40'-5"
37'-9"
46'
44'
44'-8"
52'-8"
43'-10"
38'-6"
42'-5"
38'-5"
36'-8"
46'-8"
54'-3"
42'-3"
44'
39'-11"
40'-4"
47'
39'-2"
43'-8"
38'-4"
44'
50'-6"
50'
44'-10"
37'
41'
49'
38'-10"
13'-8"
12'-8"-4"