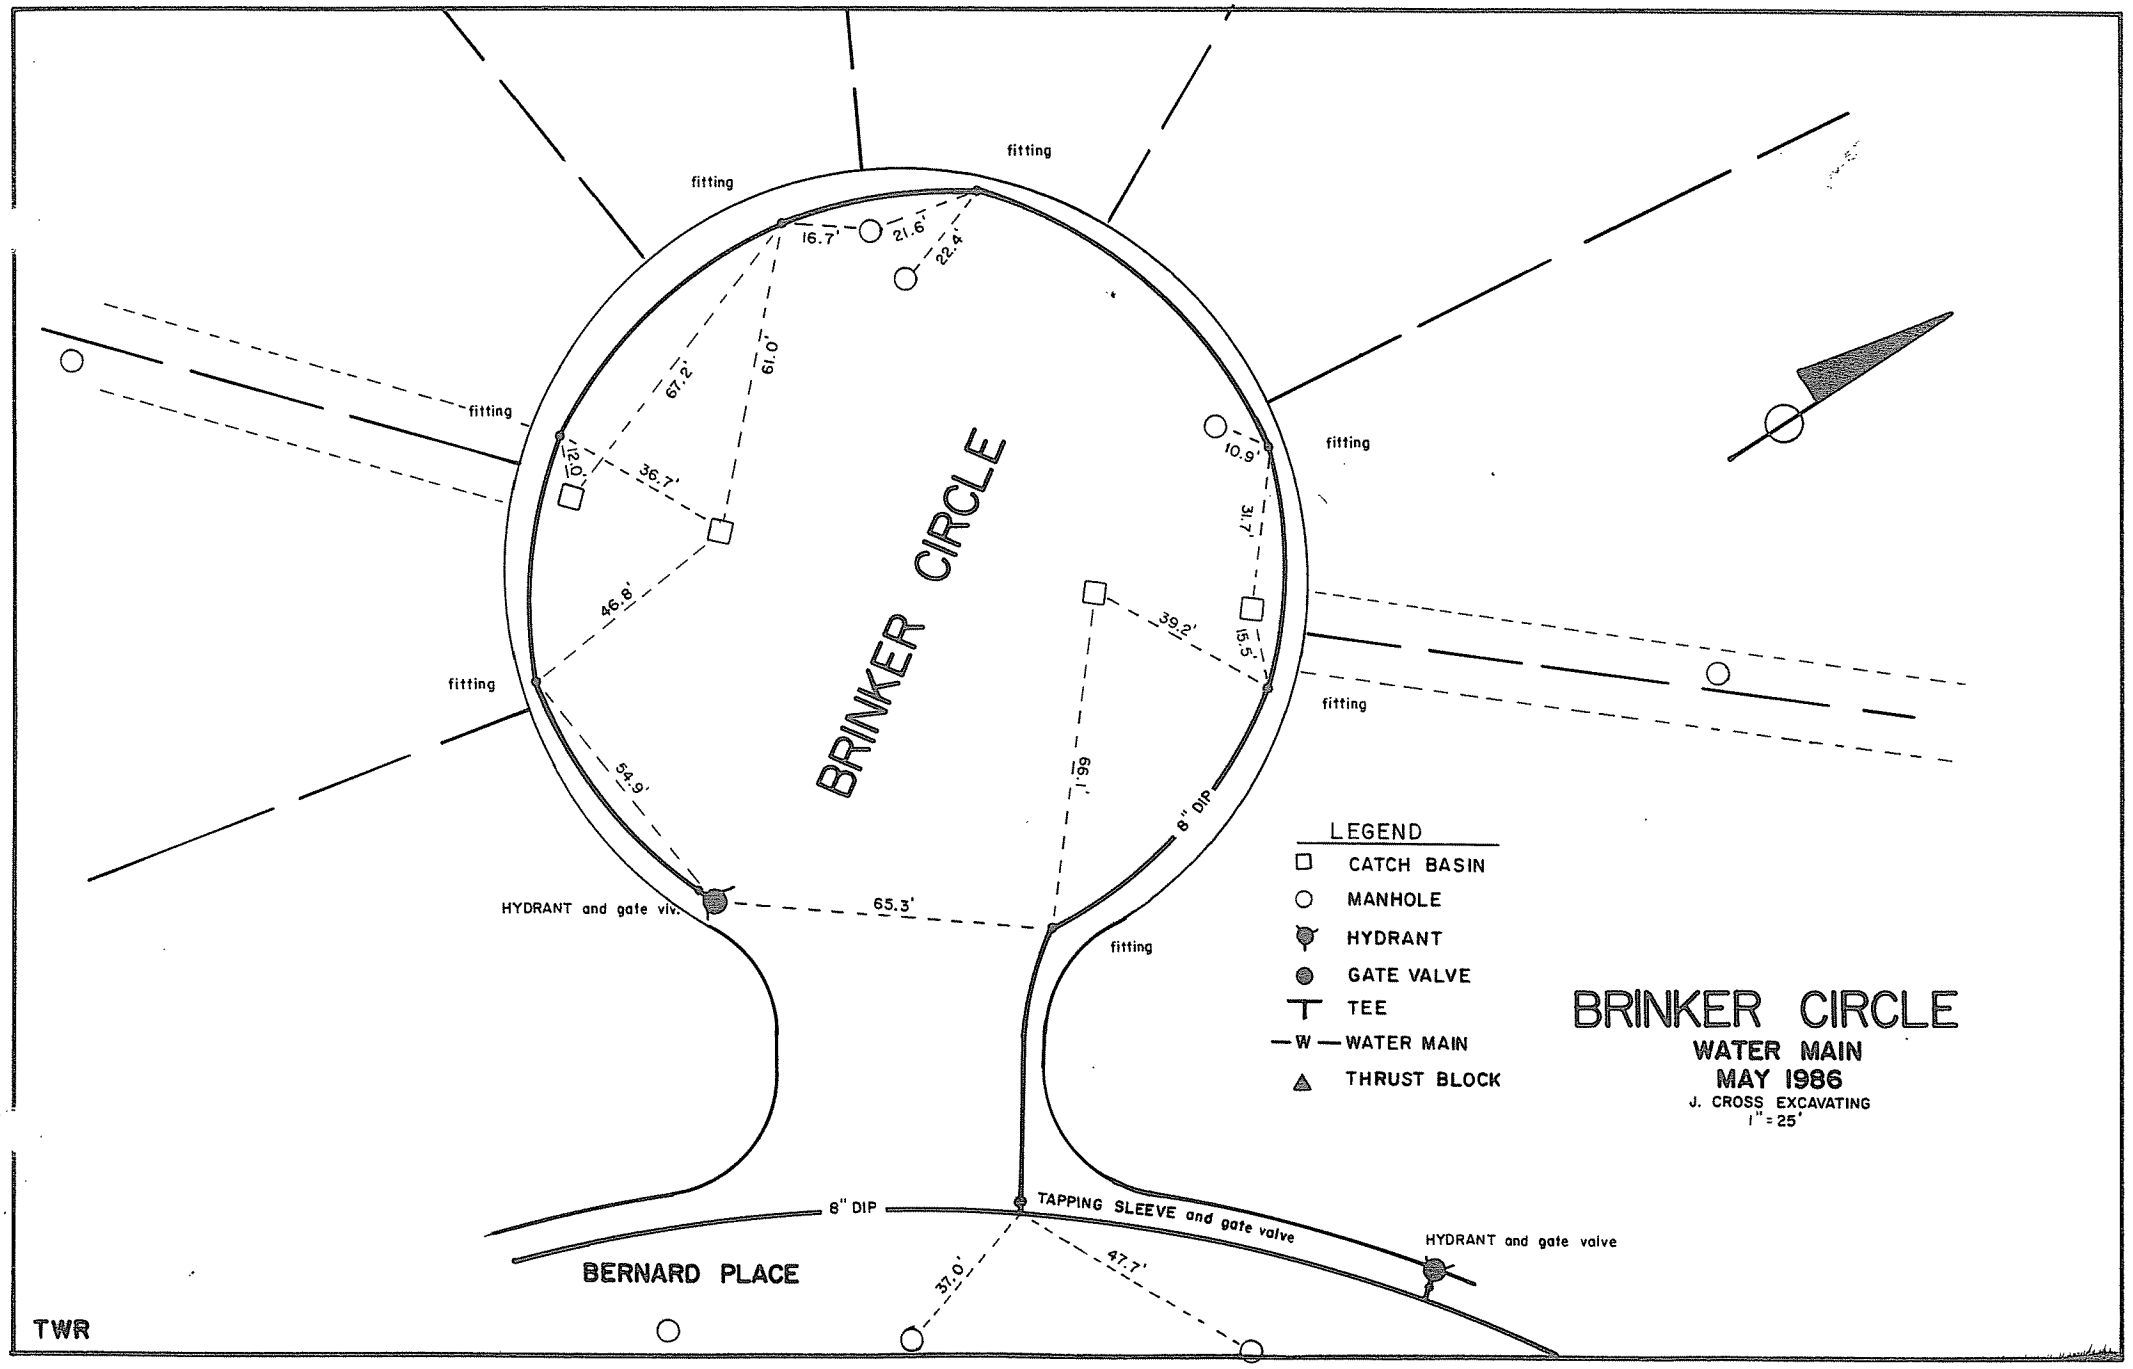
BRINKER CIRCLE
fitting
fitting
fitting
fitting
fitting
fitting
fitting
16.7'
21.6'
22.4'
67.2'
61.0'
12.1'
10.0'
36.7'
46.8'
54.9'
10.9'
31.7'
39.2'
15.5'
66.1'
65.3'
8" DIP
HYDRANT and gate viv.
8" DIP
TAPPING SLEEVE and gate valve
HYDRANT and gate valve
37.0'
47.7'
BERNARD PLACE
LEGEND
CATCH BASIN
MANHOLE
HYDRANT
GATE VALVE
TEE
—W— WATER MAIN
THRUST BLOCK
BRINKER CIRCLE
WATER MAIN
MAY 1986
J. CROSS EXCAVATING
1" = 25'
TWR