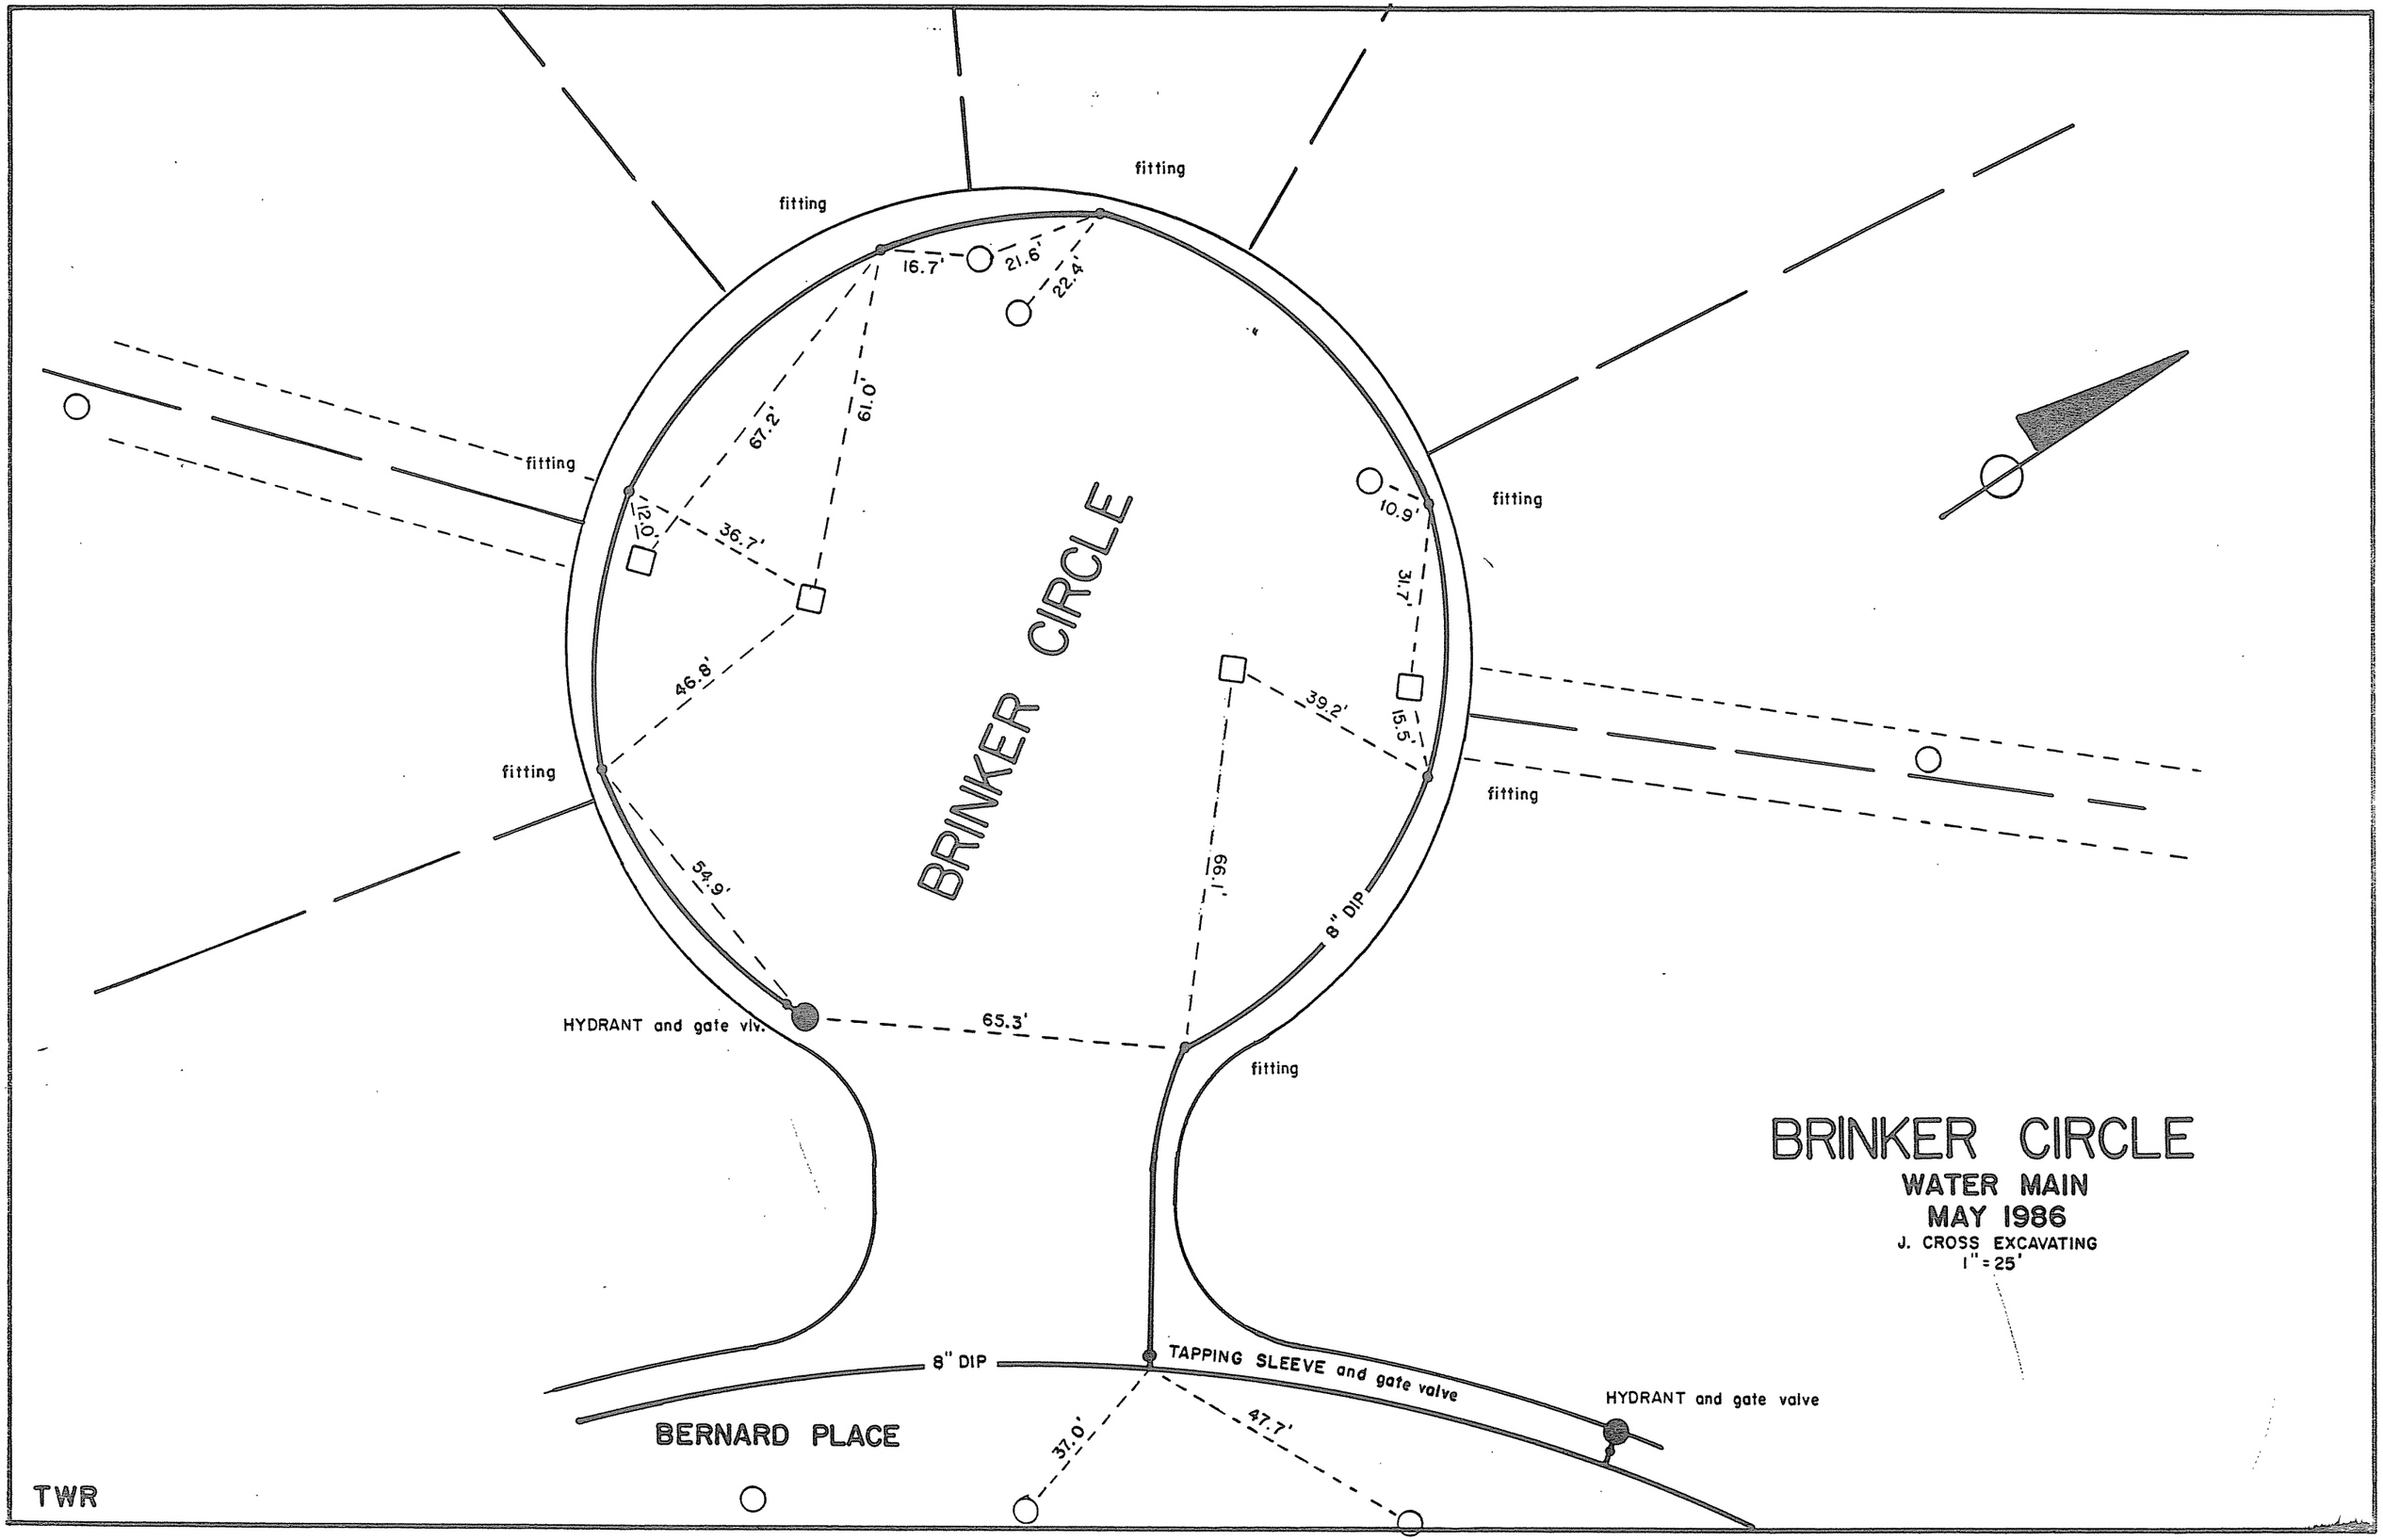
BRINKER CIRCLE
WATER MAIN
MAY 1986
J. CROSS EXCAVATING
1" = 25'
fitting
fitting
fitting
fitting
fitting
fitting
fitting
16.7'
21.6'
22.4'
67.2'
61.0'
12.0'
36.7'
46.8'
54.9'
10.9'
31.7'
39.2'
15.5'
66.1'
8" DIP
65.3'
HYDRANT and gate vlv.
8" DIP
TAPPING SLEEVE and gate valve
HYDRANT and gate valve
37.0'
47.7'
BERNARD PLACE
TWR