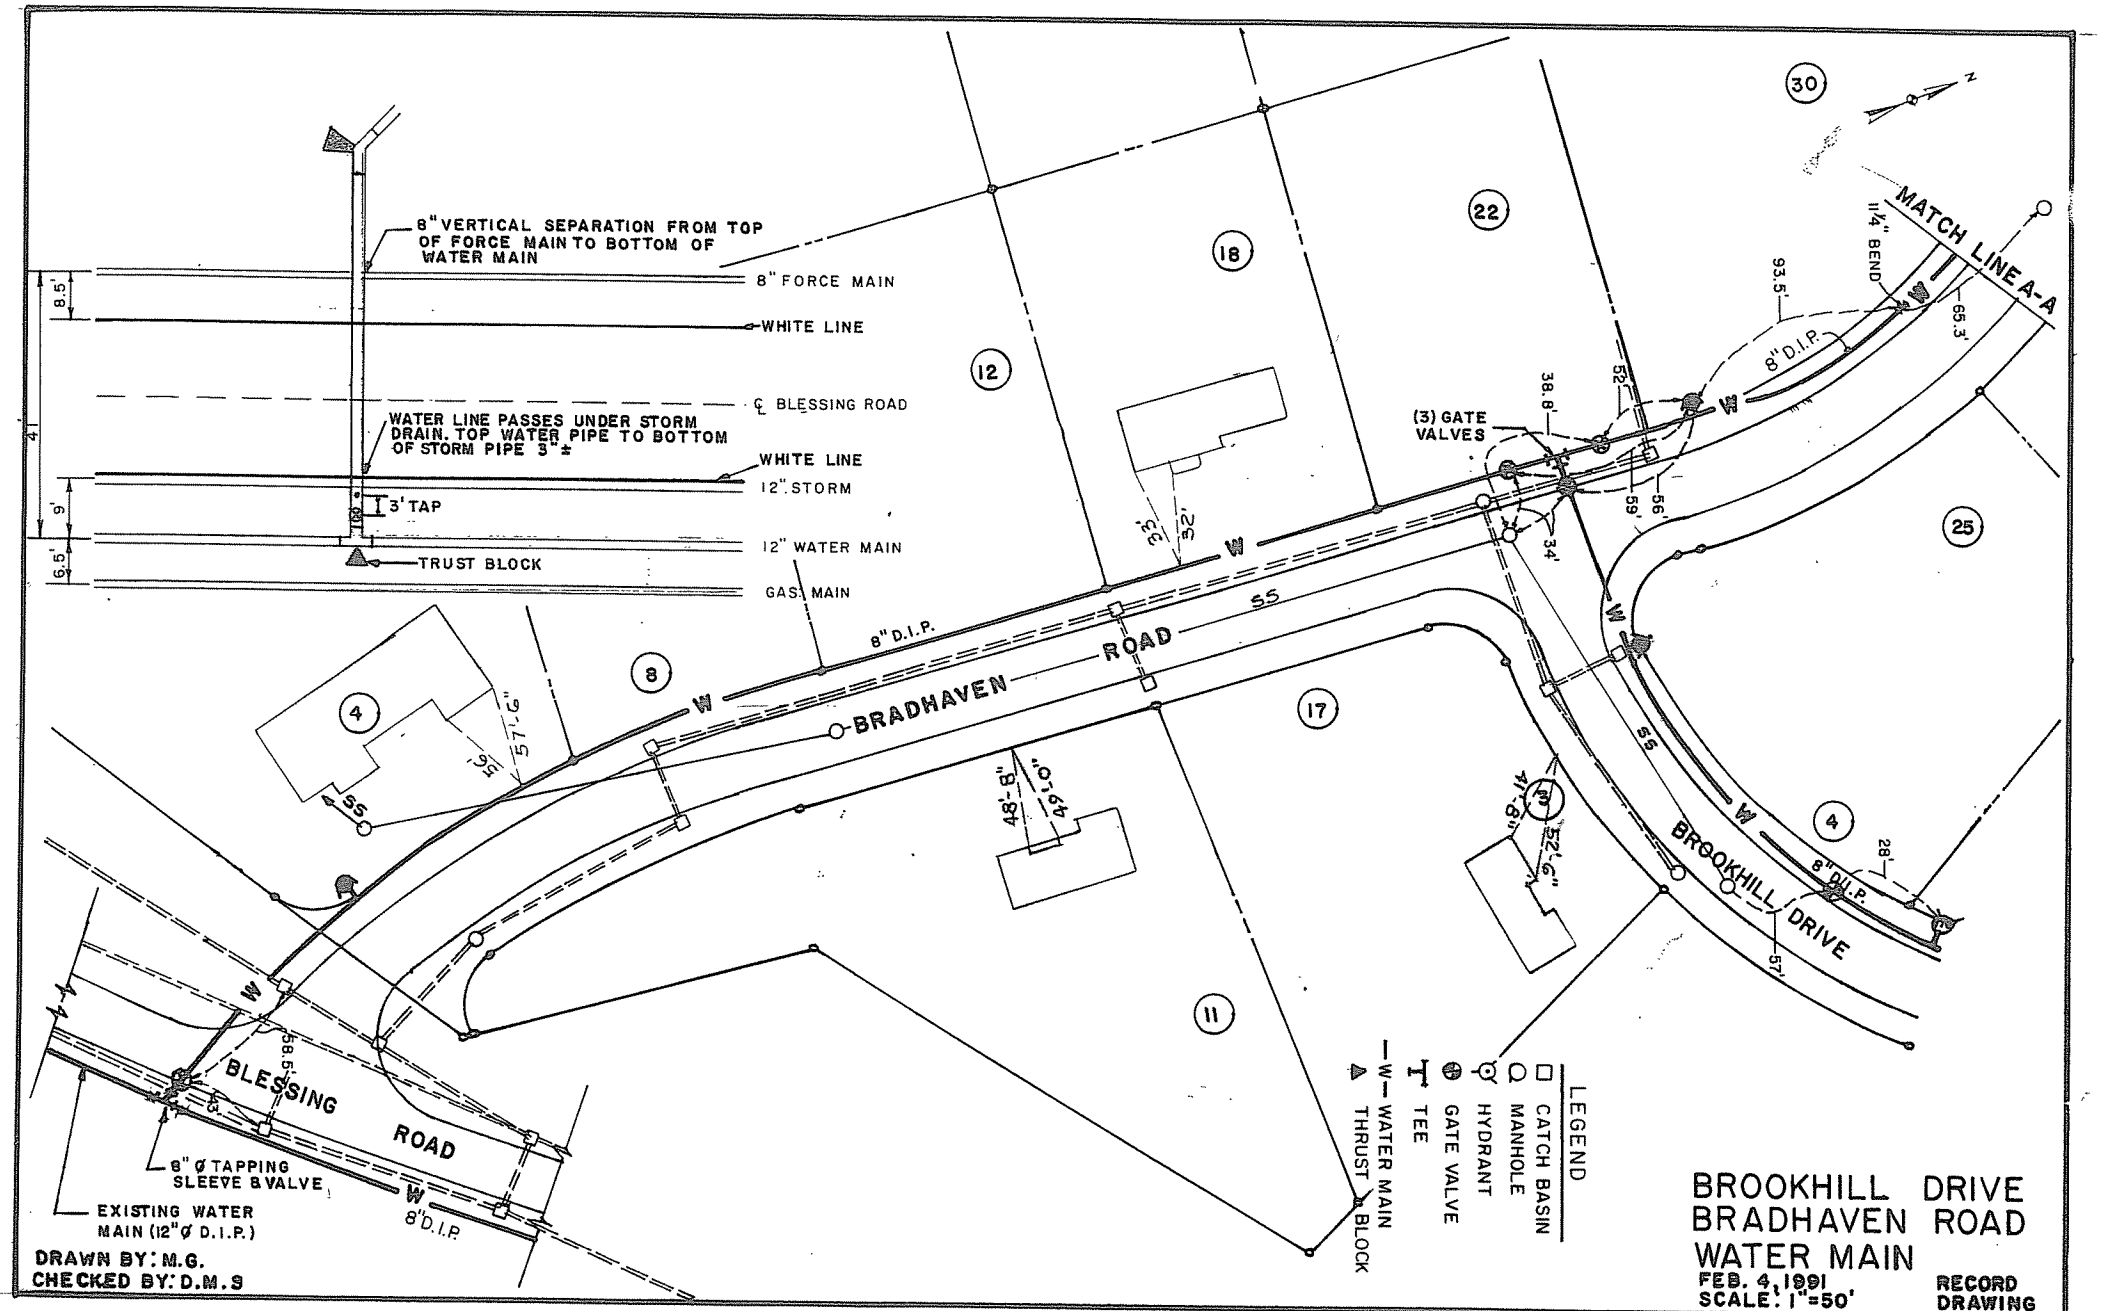

Brookhill sub. div.